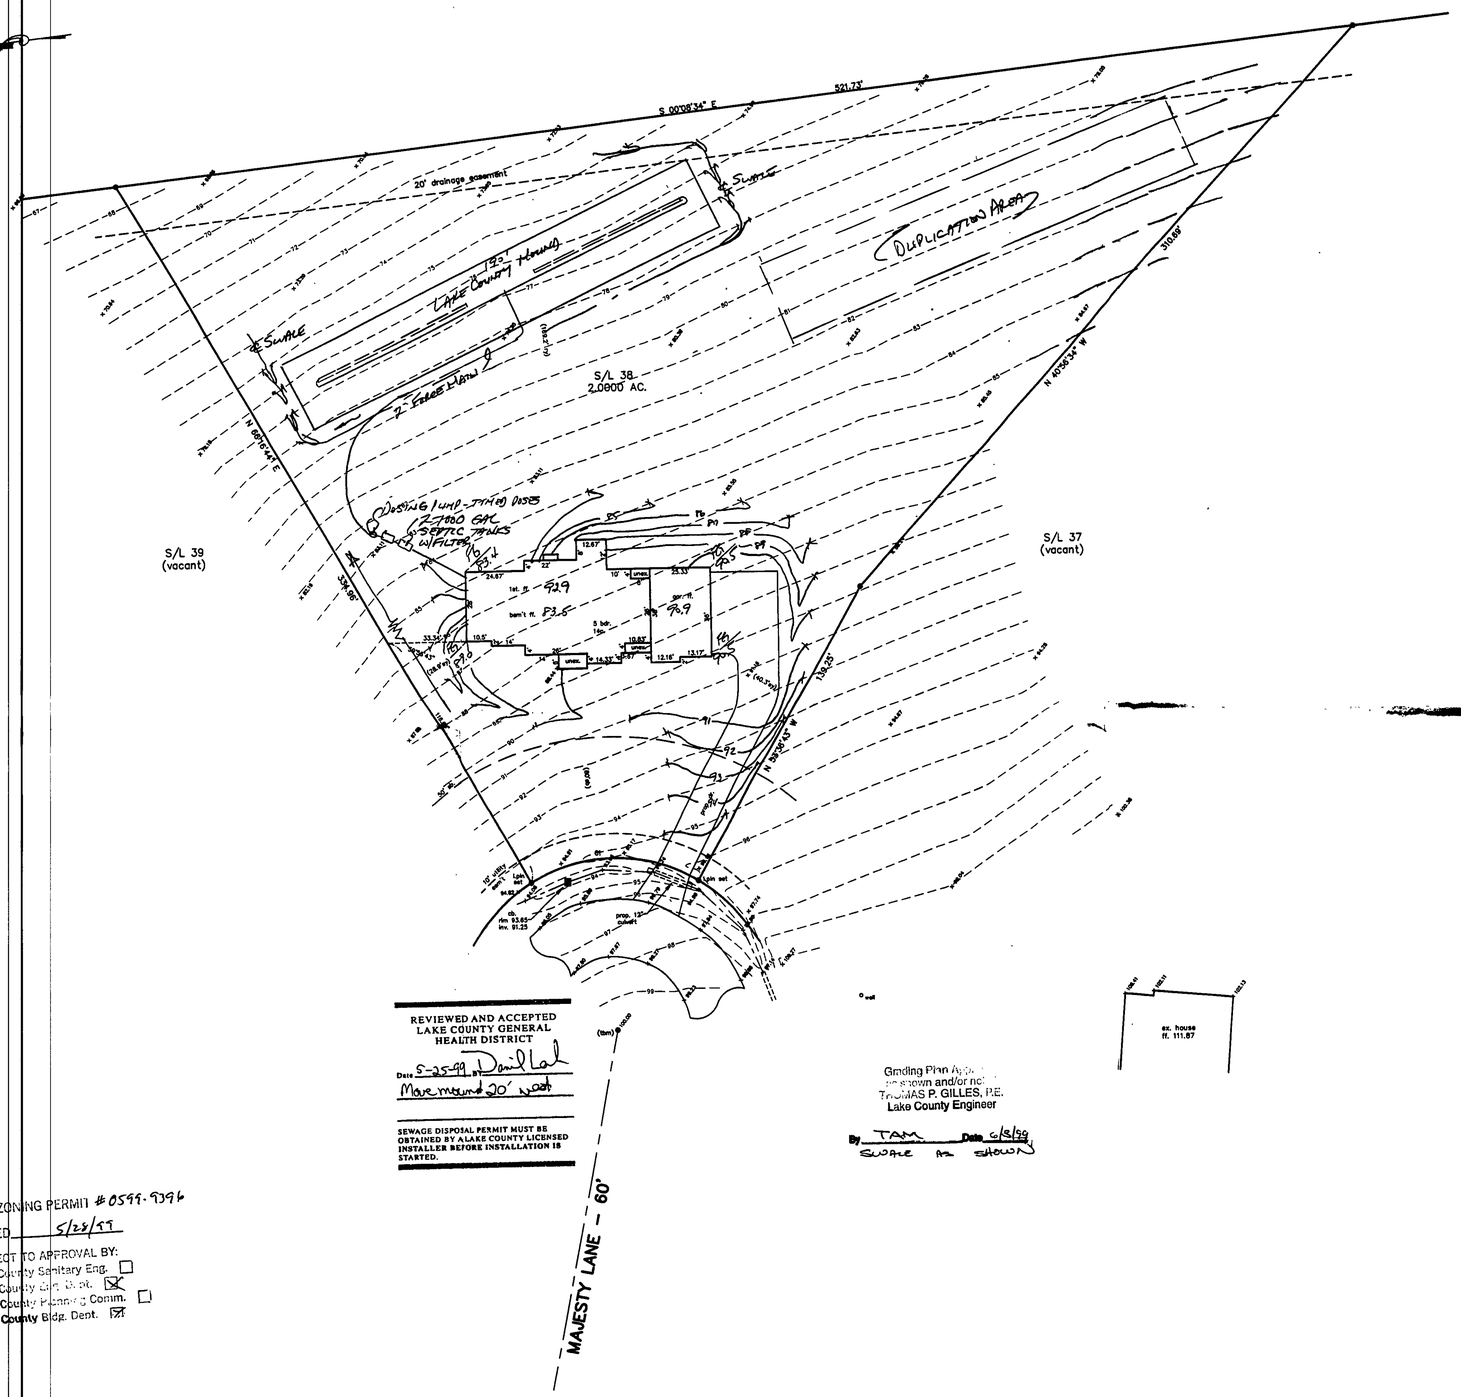

REVIEWED AND ACCEPTED
LAKE COUNTY GENERAL
HEALTH DISTRICT
Date 5-25-99 By Daniel Lal
Move mound 20' north

SEWAGE DISPOSAL PERMIT MUST BE OBTAINED BY ALAKE COUNTY LICENSED INSTALLER BEFORE INSTALLATION IS STARTED.

Grading Plan Approved as shown and/or noted
THOMAS P. GILLES, P.E.
Lake County Engineer
By TAM Date 6/8/99
SWALE AS SHOWN

ZONING PERMIT #0599-9396
ISSUED 5/28/99
SUBJECT TO APPROVAL BY:
Lake County Sanitary Eng. ☐
Lake County Eng. Dept. ☒
Lake County Planning Comm. ☐
Lake County Bldg. Dept. ☒

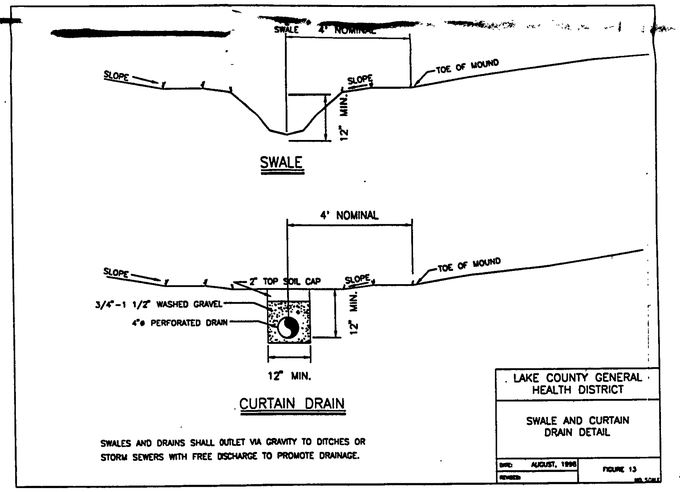

SWALES AND DRAINS SHALL OUTLET VIA GRAVITY TO DITCHES OR STORM SEWERS WITH FREE DSCHARGE TO PROMOTE DRAINAGE.

LAKE COUNTY GENERAL HEALTH DISTRICT
SWALE AND CURTAIN DRAIN DETAIL
DATE: AUGUST, 1996 | FIGURE 13
REVISION: | NO. SCALE

TBM–IRON PIN FND. @ RAD. PT.
ELEV.= 100.00

C1:R=70.00'
L=73.44'
C=70.12'
D=60°06'33"
N06°20'00"E

"I, the undersigned hereby certify that this topography indicated by 6", 1', or 2' contours, and elevations shown hereon represent an actual field survey made by me on the 22nd day of June, 19 99 and that the elevations were taken as appropriate intervals and that as of that date they existed as indicated hereon."

Harry Jones #6313
Name Reg. No.

STATE OF OHIO HARRY H. JONES JR. S-6343 REGISTERED PROFESSIONAL SURVEYOR

REV NO.	DESCRIPTION	DATE	BY	CHK'D
1	Revise setback	5/14/99	T.R.	H.J.
2	Revised SEPTIC	5/19/99	HJ	HJ

BABCOCK, JONES AND ASSOCIATES, INC
CIVIL ENGINEERS – SURVEYORS – LAND PLANNERS
PAINESVILLE OHIO 44077

DATE 4/24/99
DESIGN BY H.J.
DRAWN BY T.R.
APPROVED BY H.J.

SITE PLAN
FOR
JAROS BUILDERS
S/L 38 MOUNT ROYAL SUB.
CONCORD TOWNSHIP LAKE COUNTY

SCALE: 1"=30'
JOB NO. 93-163-38
SHEET 1 OF 2