


REVISIONS	BY
REVISED STORM LOC JUNE 16, 2014	WSO
REVISED GRADING JULY 10, 2014	WSO


Barrington
CONSULTING GROUP, INC.
9114 TYLER BLVD., MENTOR, OHIO 44060
PHONE 440.205.1260 FAX 440.205.1262
www.BarringtonCGI.com

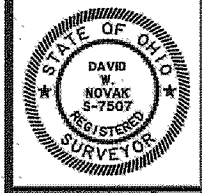

SITE PLAN
8251 MORLEY ROAD
CONCORD TWP., OHIO 44060

JANIK INVESTMENTS

DRAWN
WSO
CHECKED
DWN
DATE
MAY 12, 2014
SCALE
1" = 30'
JOB NO.
14036
SHEET
2/3
OF SHEETS

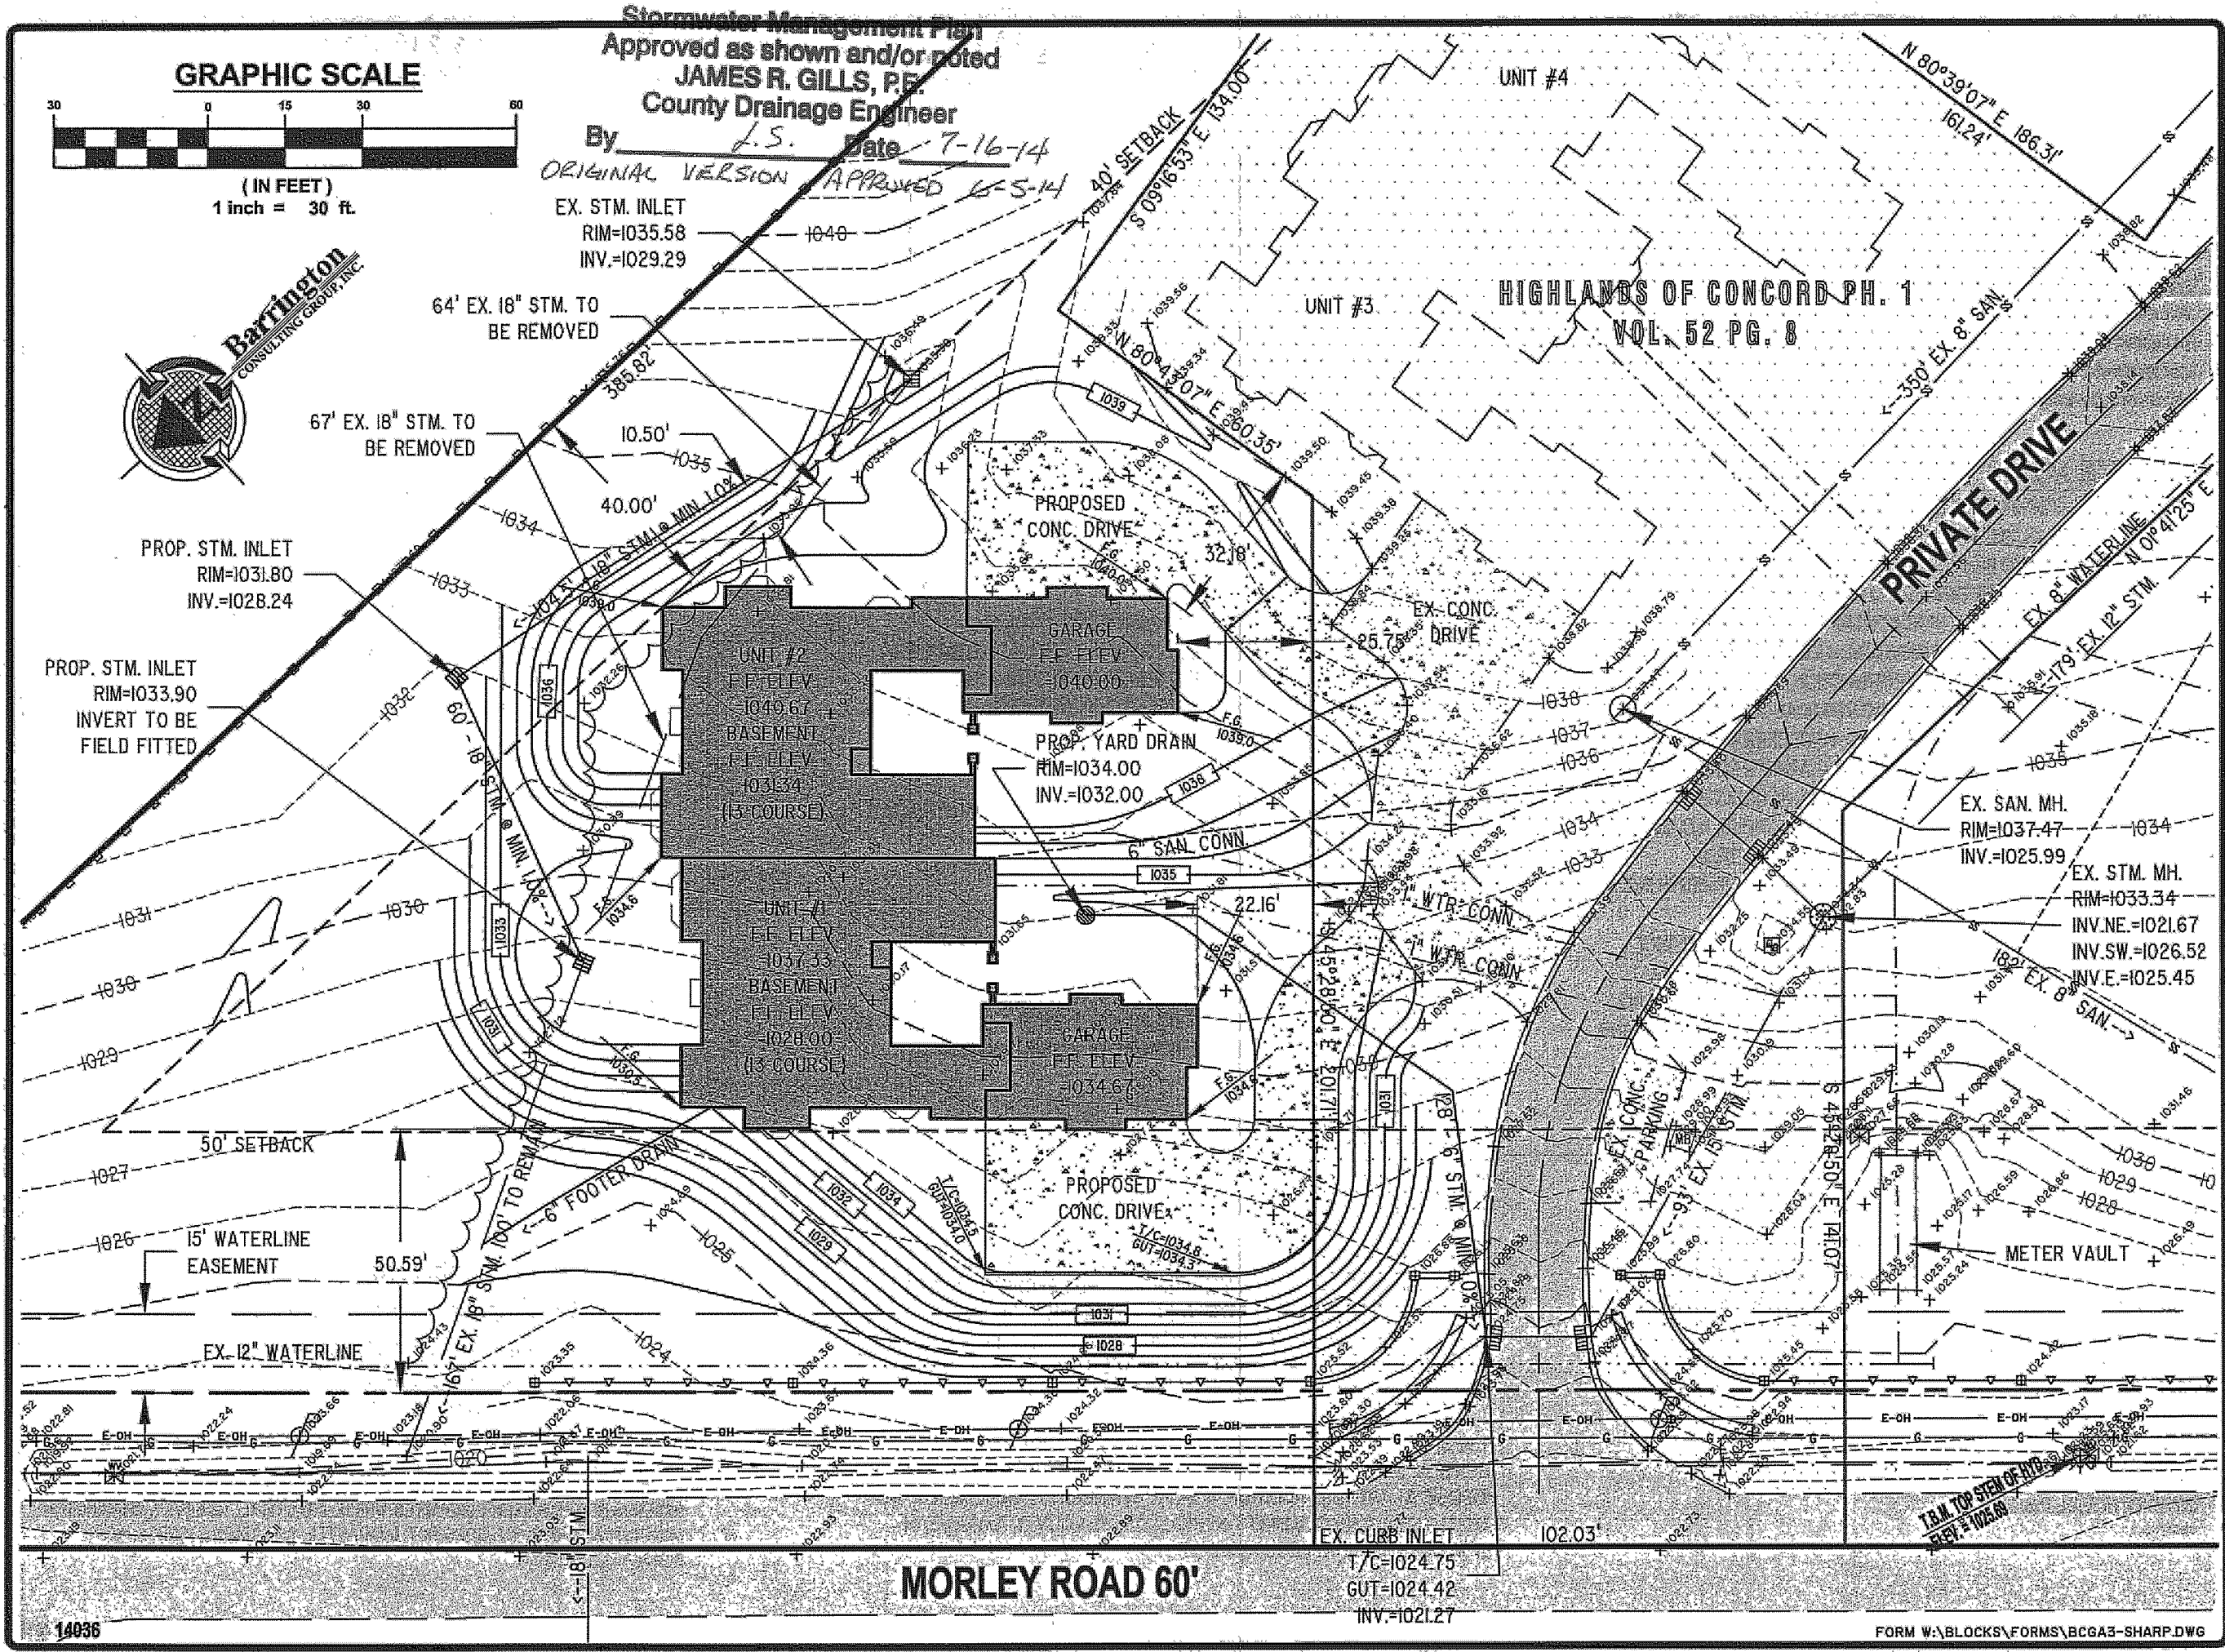

Barrington
CONSULTING GROUP, INC.

Civil Engineers - Surveyors - Land Planners

9114 TYLER BLVD., MENTOR, OHIO 44060
PHONE 440.205.1260 FAX 440.205.1262
www.BarringtonCGI.com