

REVISIONS	BY

Barrington

CONSULTING GROUP, INC.

9114 TYLER BLVD., MENTOR, OHIO 44060


PHONE 440.205.1260 FAX 440.205.1262

www.BarringtonCGL.com

STATE OF OHIO

DAVID W. NOVAK

REGISTERED SURVEYOR

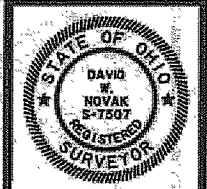

SITE PLAN

MORELY ROAD

CONCORD TWP., OHIO 44060

JANIK INVESTMENTS

DRAWN WSO

CHECKED DWN

DATE MAY 12, 2014


SCALE 1" = 30'

JOB NO. 14036

SHEET 2/3

14036

FORM W:\BLOCKS\FORMS\BCGA3-SHARP.DWG

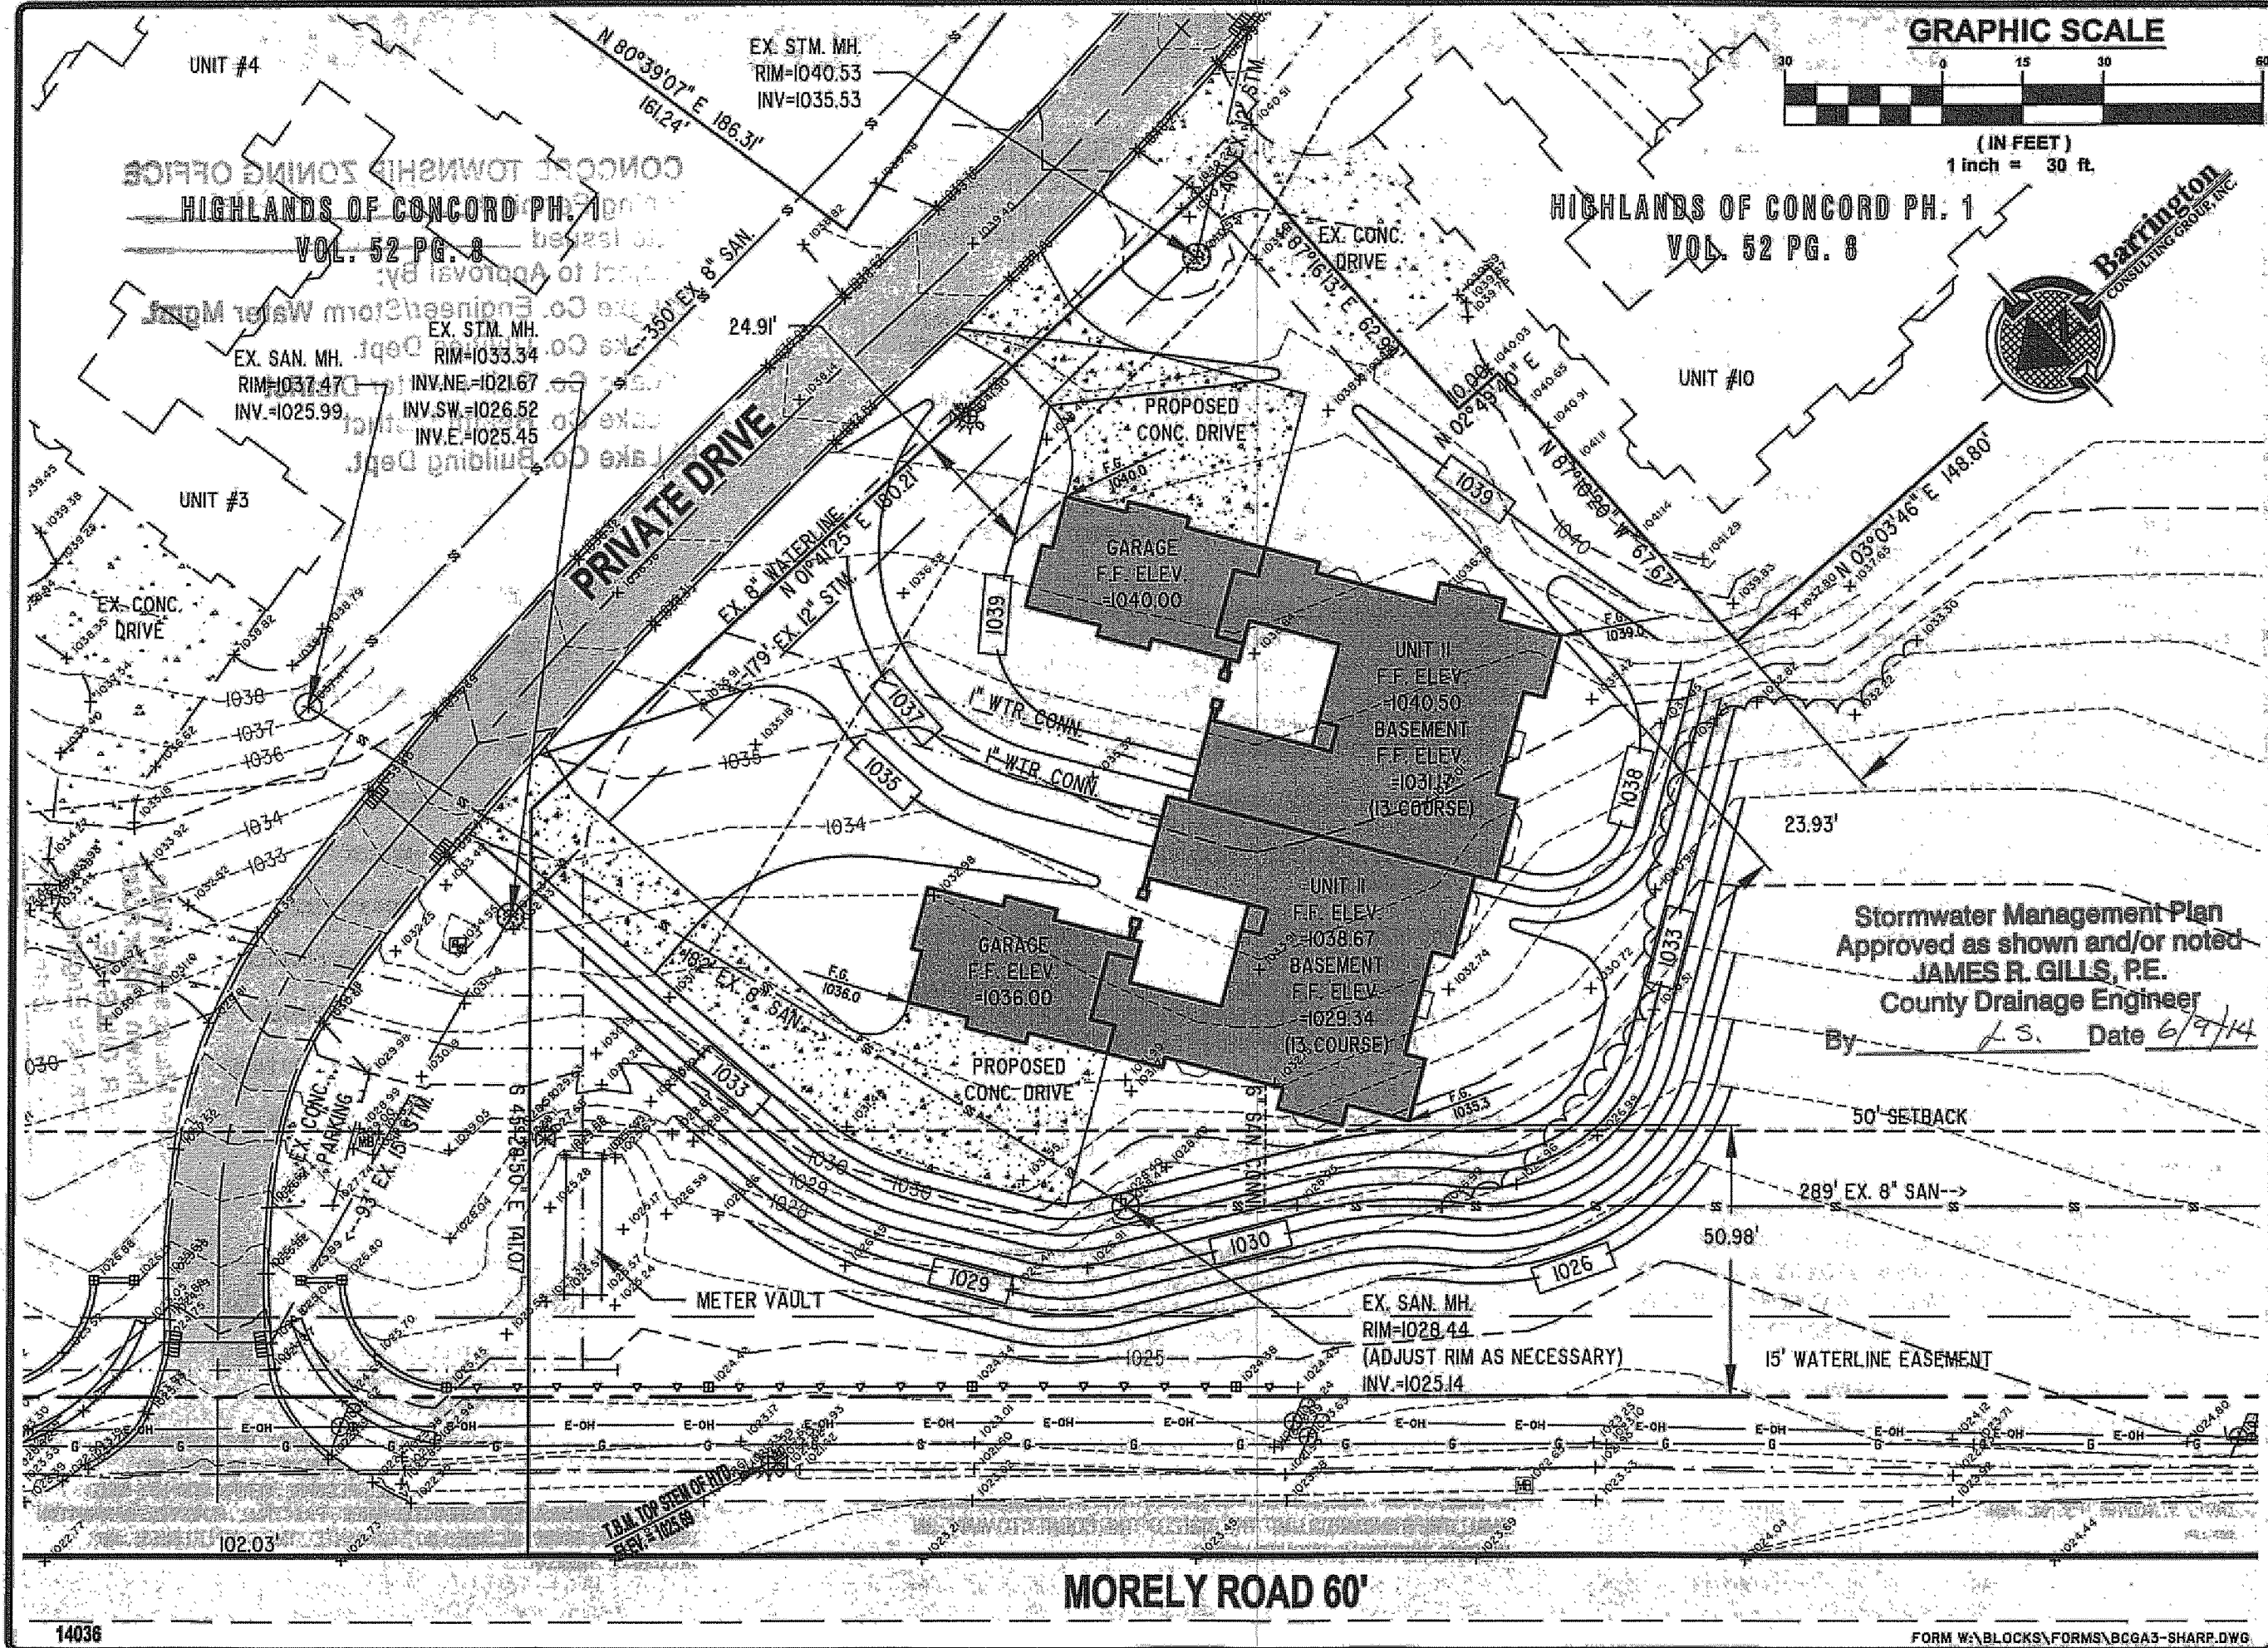

Barrington

CONSULTING GROUP, INC.

9114 TYLER BLVD., MENTOR, OHIO 44060

PHONE 440.205.1260 FAX 440.205.1262

www.BarringtonCGL.com

Civil Engineers - Surveyors - Land Planners