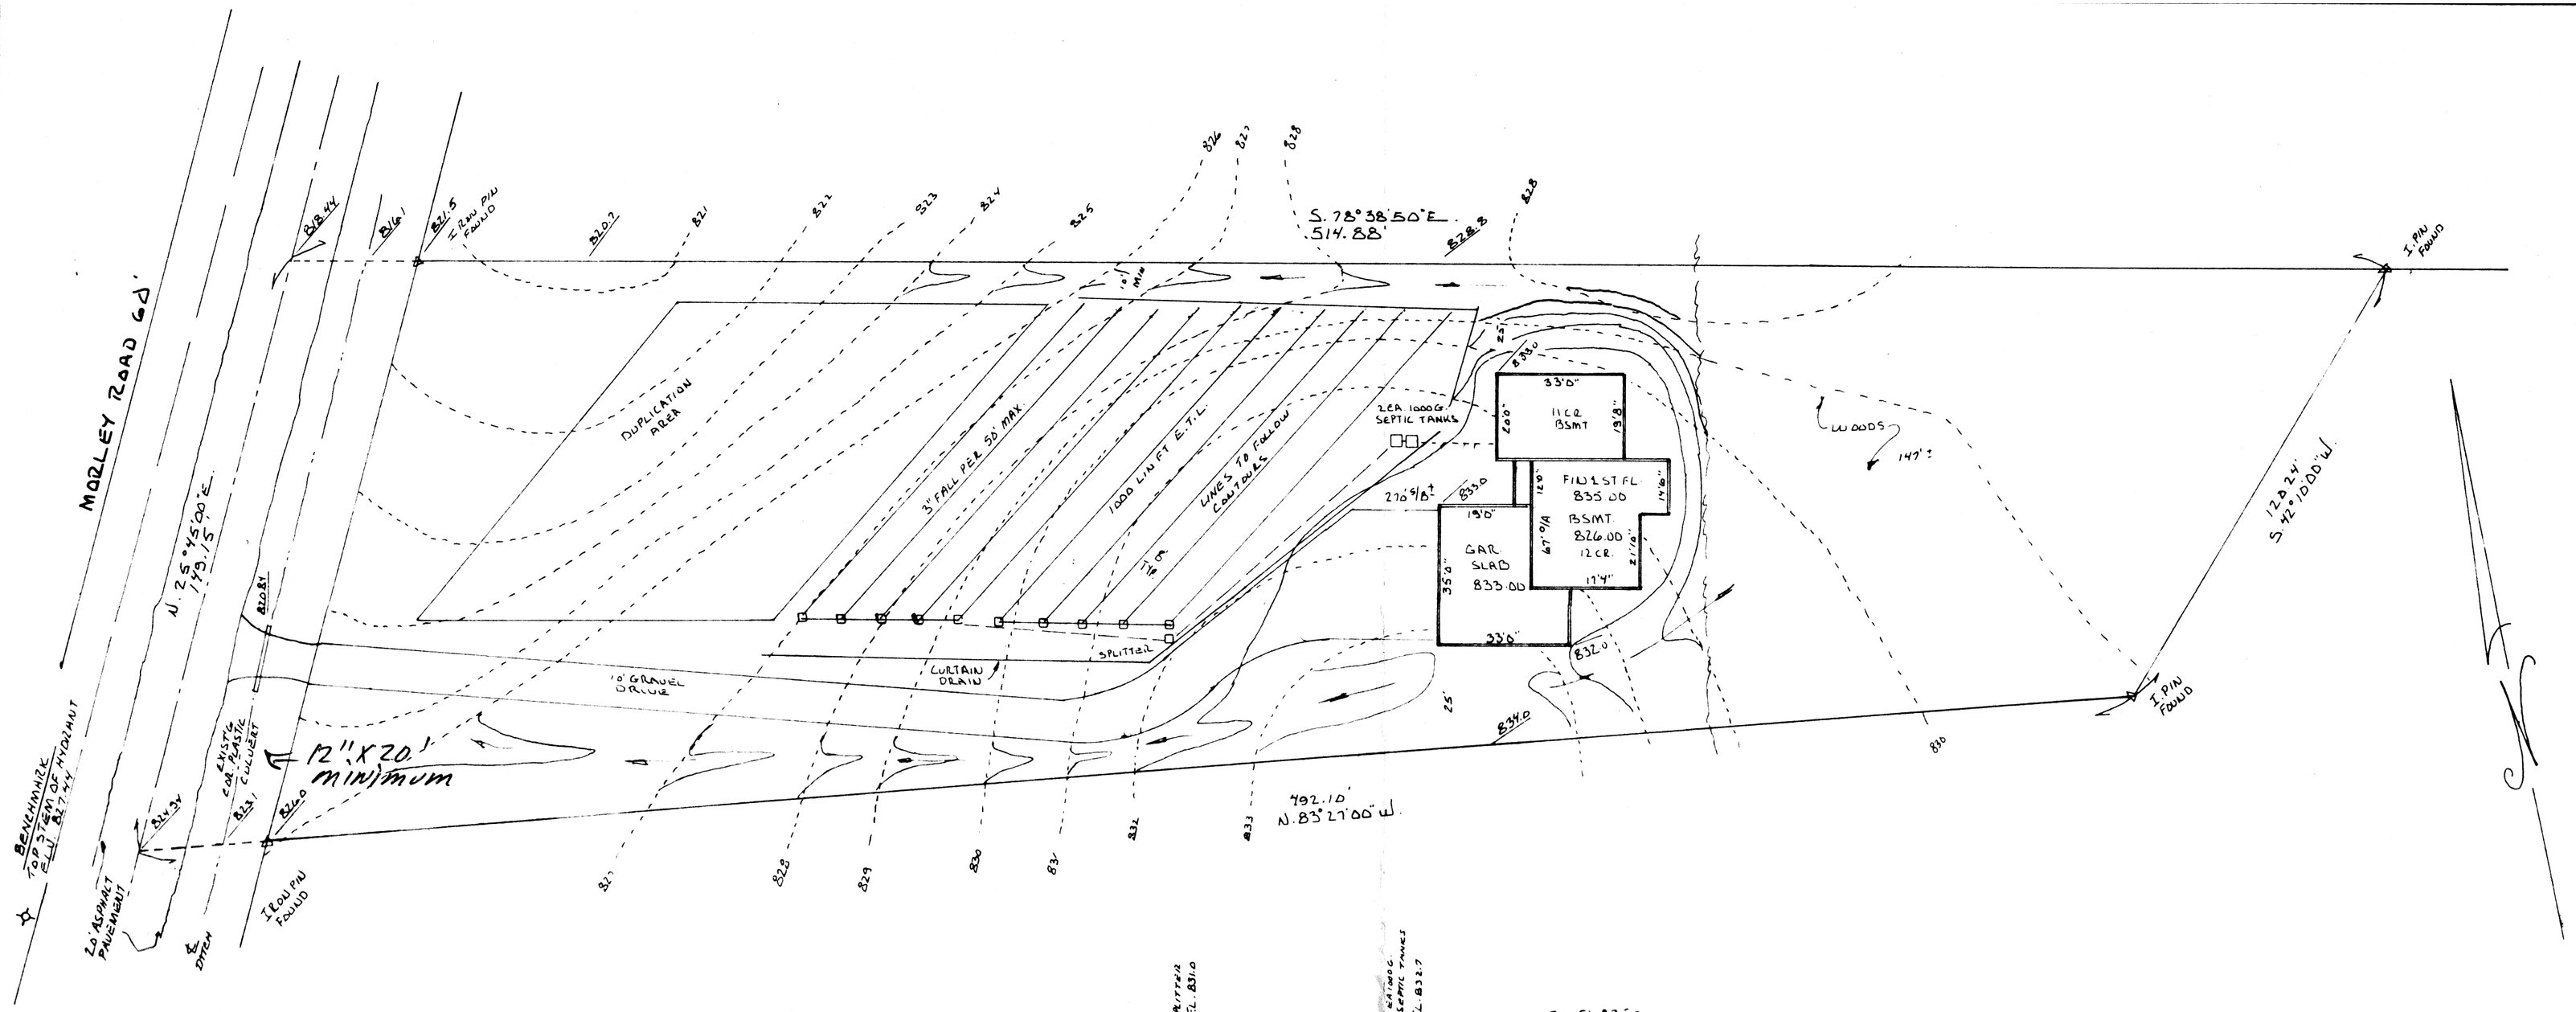

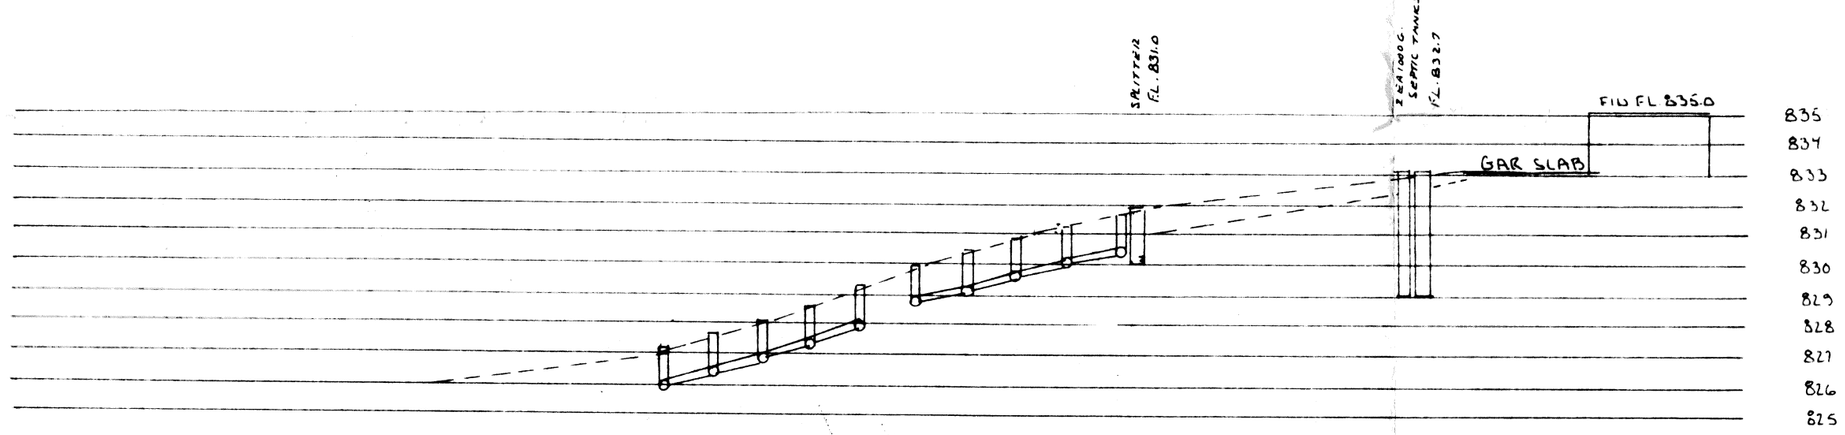

PROFILE HOR. 1" = 30'
VER. 1" = 5'

SEWAGE DISPOSAL PERMIT MUST BE OBTAINED BY A LAKE COUNTY LICENSED INSTALLER BEFORE INSTALLATION IS STARTED.

A. To be brought to finished grade
1. Septic tank manhole covers
2. Splitter box cover
3. Distribution box cover
4. Vent lines

B. No footer drains or downspouts to be discharged into septic tanks

C. All waste water to be discharged **into** septic tanks

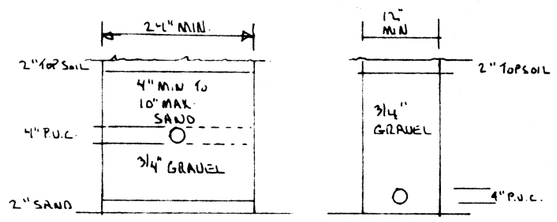

TYPICAL SECTIONS
N.T.S.

LOW YIELD WATER FIXTURES REQUIRED ON ALL:
___ Shower Head
___ Toilet
___ _____

Reviewed and Accepted
LAKE COUNTY GENERAL HEALTH DISTRICT
Date 7-2-87
J. E. LUSH, R.S., M.P.H.
Health Commissioner
BY Laura Kramer Burns

EXISTING GRADES
PROPOSED GRADES
SWALE

ZONING PERMIT #5571
ISSUED 7-2-87
SUBJECT TO APPROVAL BY:
Lake County Sanitary Eng. ☐
Lake County Eng. Dept. ☒
Lake County Planning Comm. ☐
Lake County Bldg. Dept. ☒
Terri S. Marano

I CERTIFY THAT THIS PLAN WAS PREPARED BY ME AND IS CORRECT TO THE BEST OF MY KNOWLEDGE AND BELIEF
John C. Skonieczny
REG. SURVEYOR #5356
JOHN C. SKONIECZNY
7739 VIEWMOUNT DR.
PAINESVILLE, OHIO 44077
PH. 352-7742

Grading Plan Approved as shown and/or noted
THOMAS P. GILLES, P.E.
Lake County Engineer
By _____ Date 7-2-87

SITE PLAN FOR:
DAVID & VIRGINIA NAGY

SCALE: 1" = 30'	APPROVED BY	DRAWN BY JCS
DATE: JUN 87		

AS DESCRIBED IN VOL. 257 PG. 1346 L.C.R.D.
TOWNSHIP OF CONCORD COUNTY OF LAKE STATE OF OHIO

DRAWING NUMBER