

# SITE PLAN FOR:

SHANDLE CONST. CO.  
8353 MENTOR AVENUE  
MENTOR, OHIO

## PREPARED BY:

WM. R. GRAY ASSOC., INC.  
ENGINEERS & SURVEYORS  
7547 MENTOR AVENUE  
MENTOR, OHIO


## CERTIFICATION:

I HEREBY CERTIFY THAT THIS PLAT IS CORRECT  
TO THE BEST OF MY KNOWLEDGE.


BY: *Wm. R. Gray*  
WM. R. GRAY REG. SURV. # 2752

DATE: MARCH 19, 1974 SCALE: 1"=20'

NOTE: UTILITIES & PAVEMENT ARE SUBJECT  
TO AS-BUILT CONDITIONS

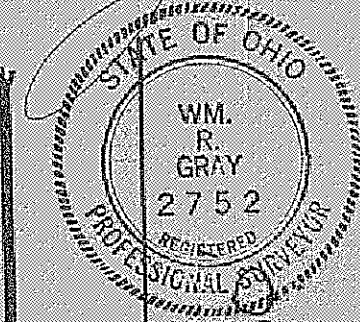

BEING SUBLT No. 31 IN MORLEY HILLS ESTATES  
SUBDIVISION No. 2 IN CONCORD TOWNSHIP, OHIO.

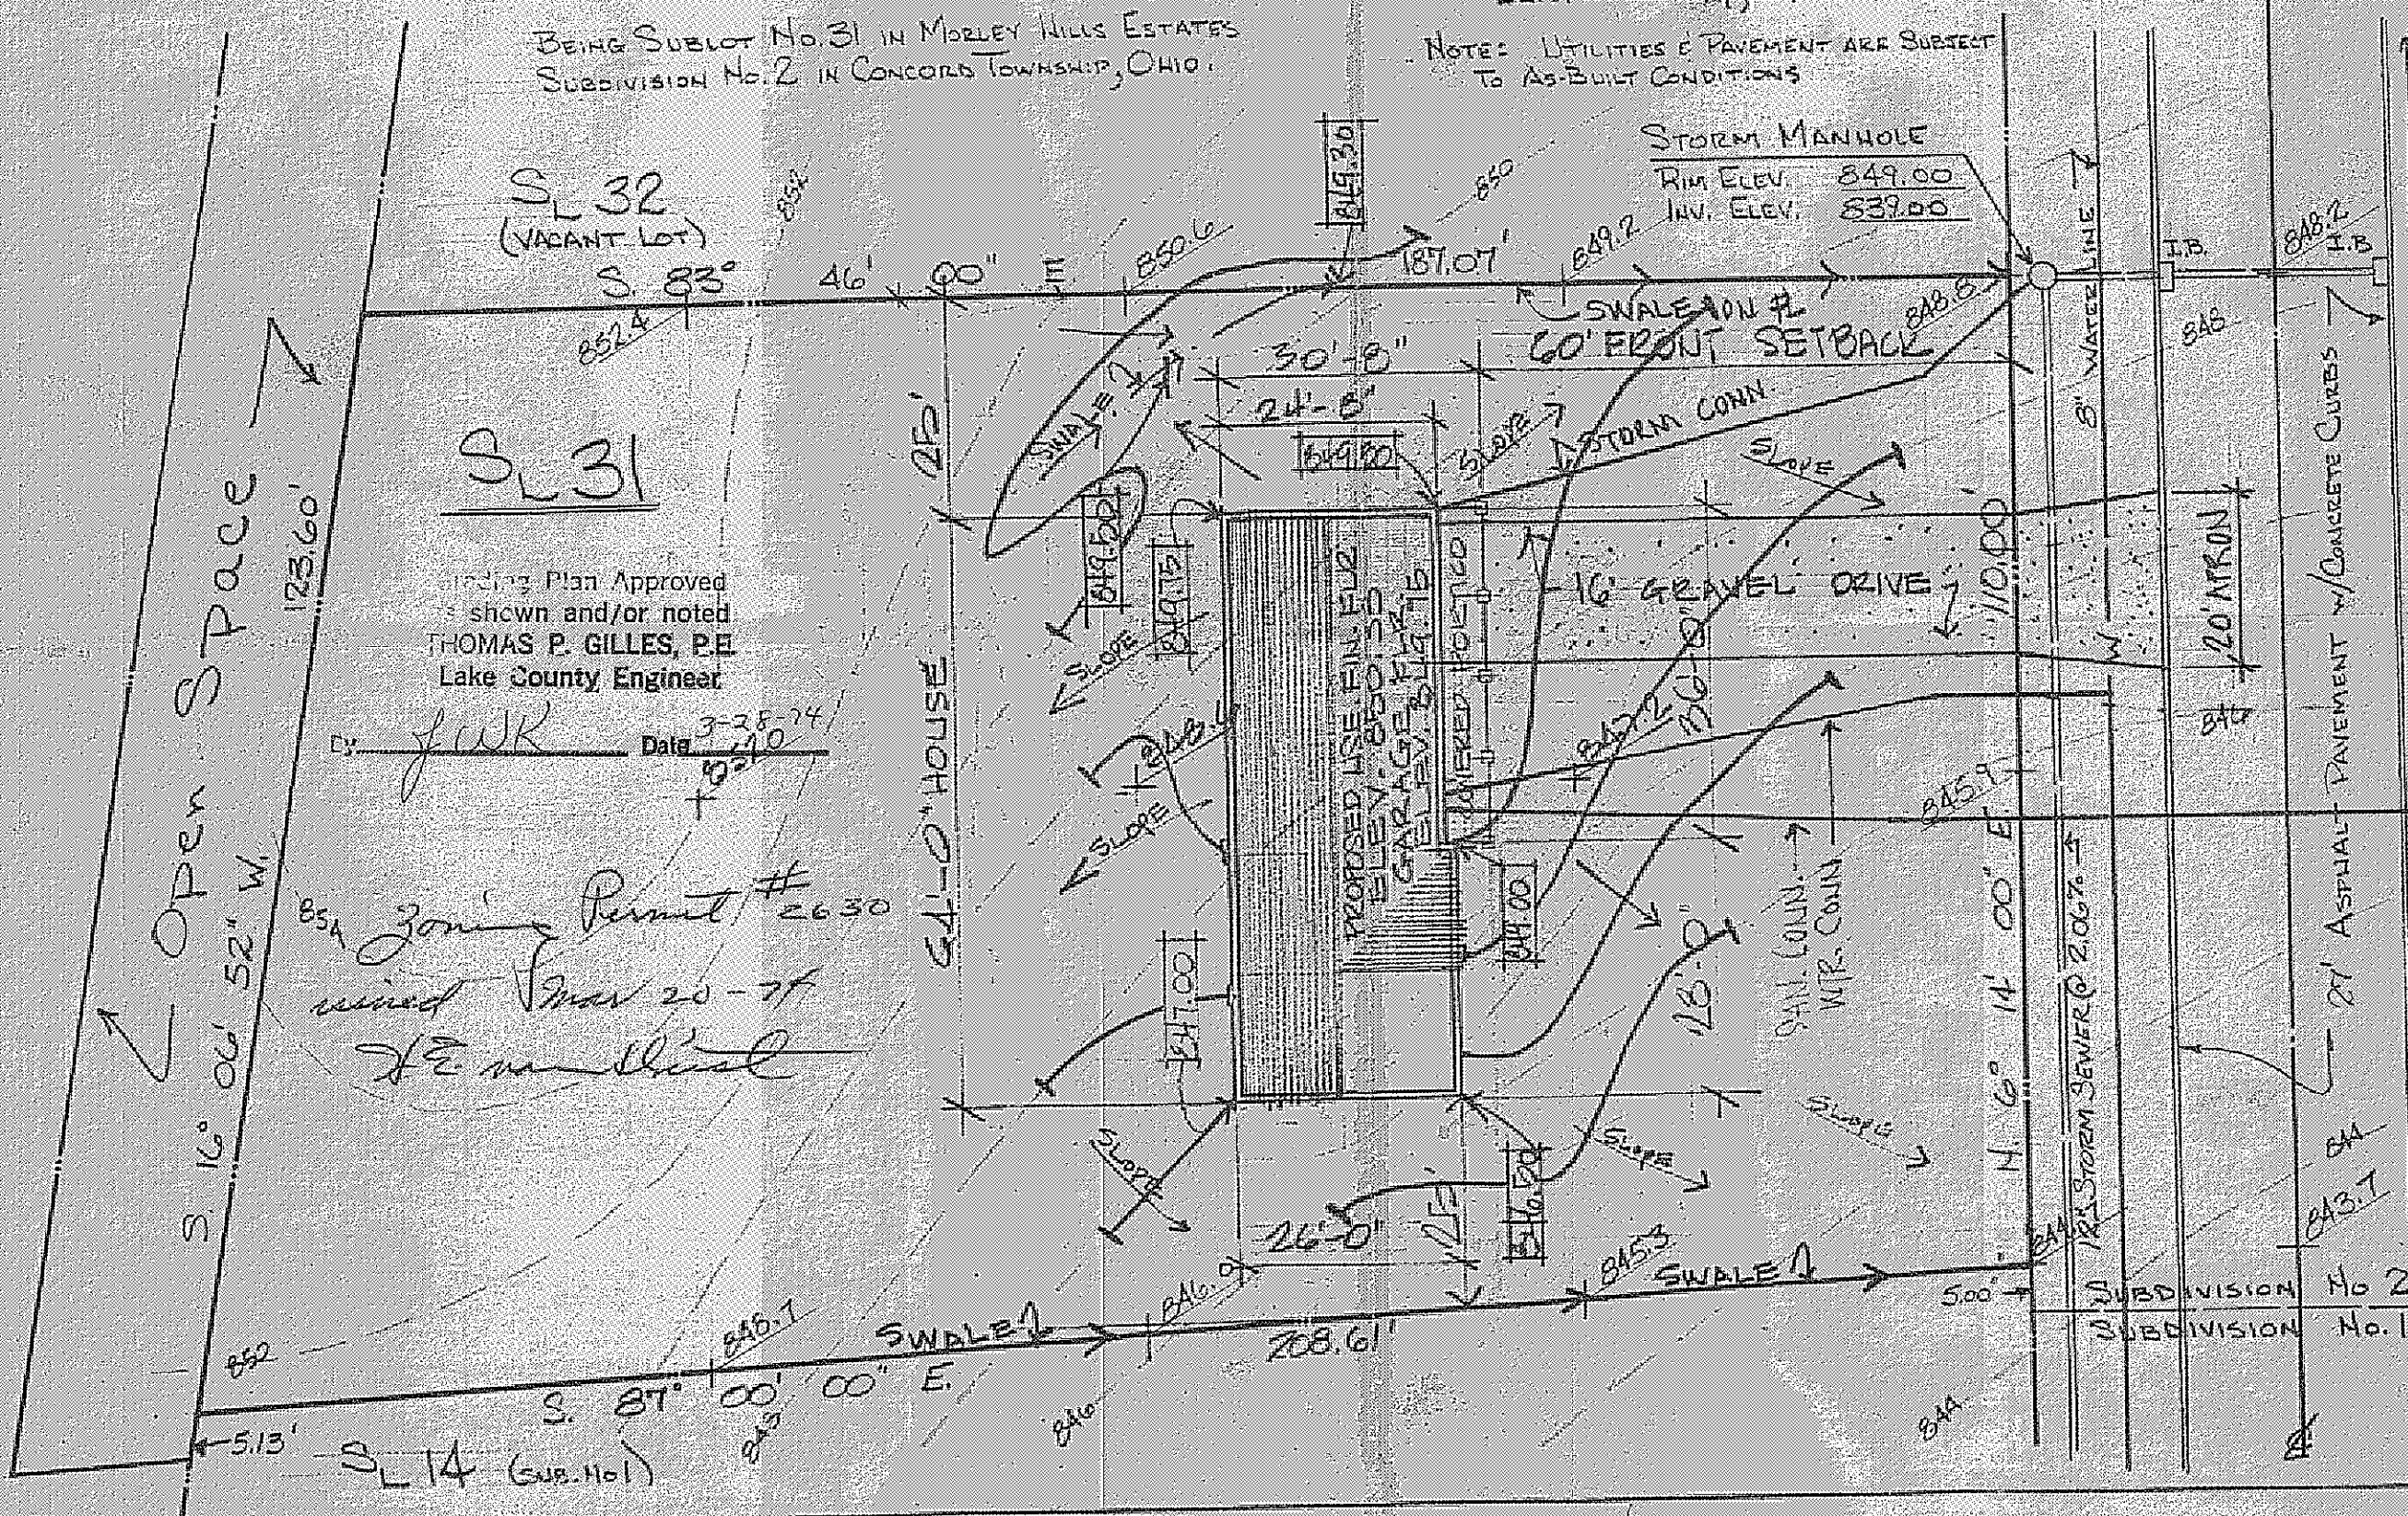

Building Plan Approved  
as shown and/or noted  
THOMAS P. GILLES, P.E.  
Lake County Engineer

By: *fwk* Date: 3-28-74  
8-10

Zoning Permit # 2630  
issued Mar 20-74  
*W. R. Gray*

8" SANITARY SEWER @ 4.11% →

OAKRIDGE DRIVE