

SITE PLAN FOR:

SHANDLE CONST.
8353 MENTOR AVENUE
MENTOR, OHIO

BEING SUBLOT NO. 47 IN THE MORLEY
HILLS ESTATES SUBDIVISION NO. 2 LOCATED
IN CONCORD TWP., OHIO.

PREPARED BY:

WM. R. GRAY ASSOC. INC.
7547 MENTOR AVE.
MENTOR, OHIO

DATE: July 16, 1975 SCALE: 1" = 20'


CERTIFICATION:

I HEREBY CERTIFY THAT THIS
PLAT IS CORRECT TO THE BEST OF MY
KNOWLEDGE.

By: Wm. R. Gray (Signature)
WM. R. GRAY REG. SURV. #
347 1071

Grading Plan Approved
as shown and/or noted
THOMAS P. GILLES, P.E.
Lake County Engineer

JWK Date 7-18-75

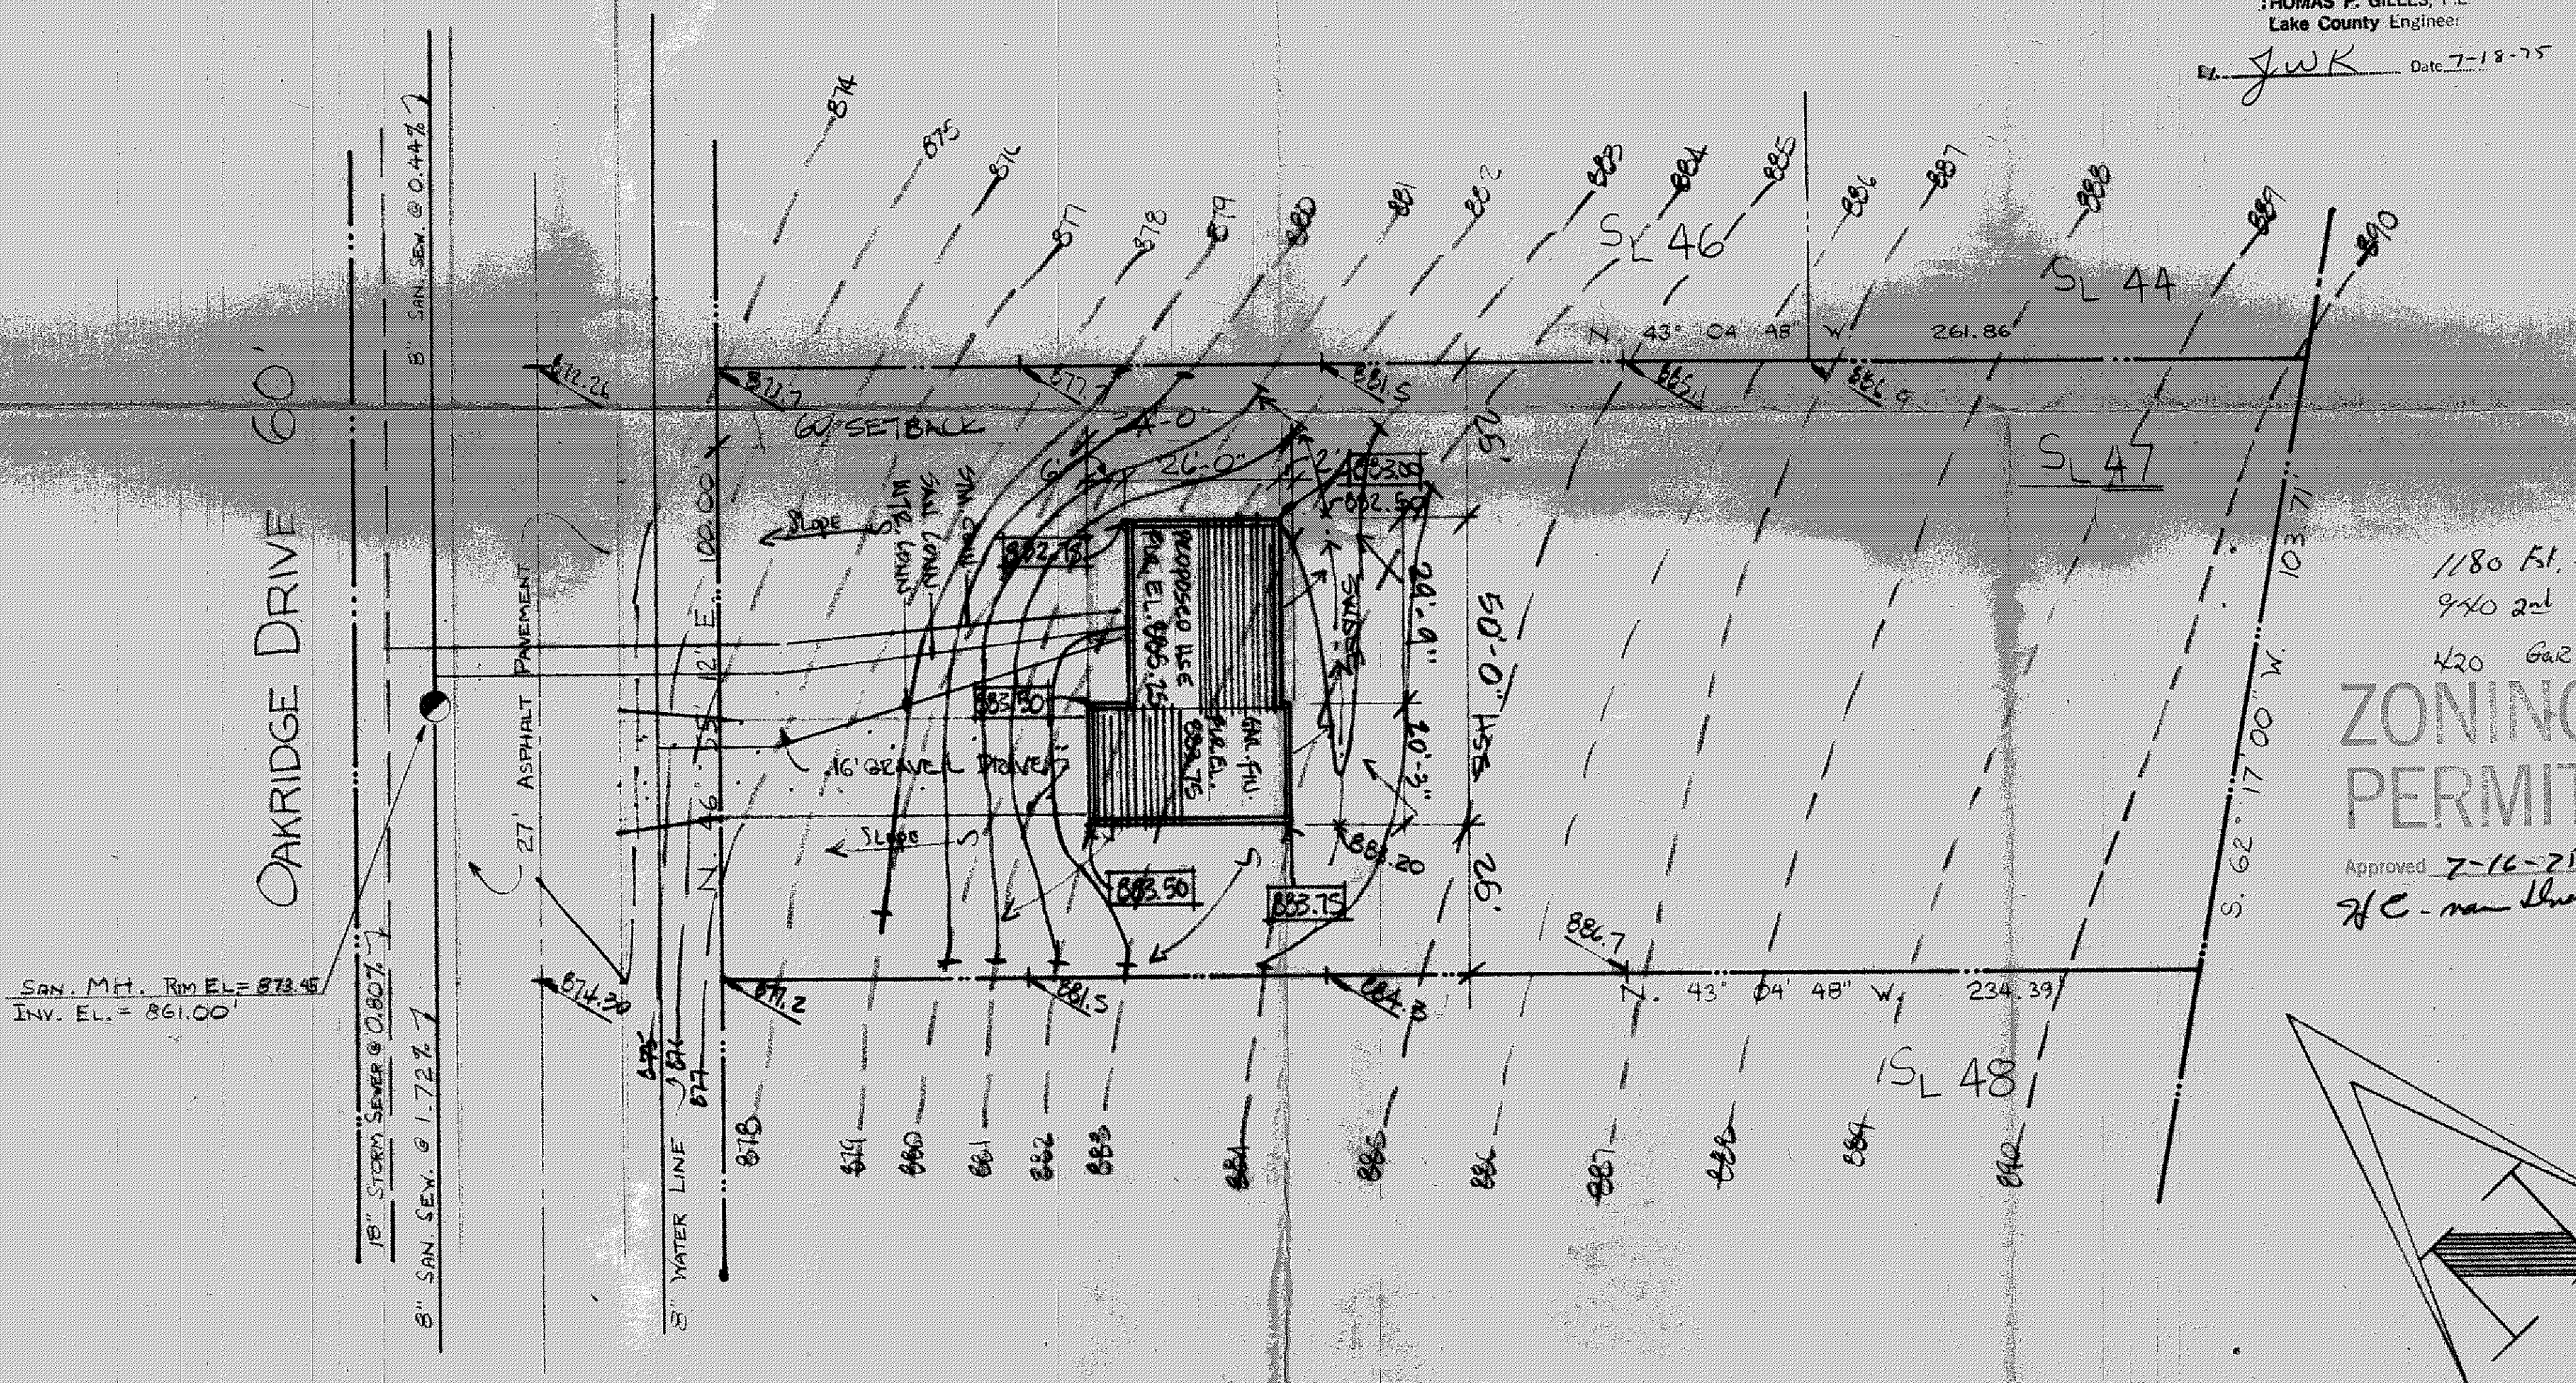

ZONING
PERMIT

Approved 7-16-75
JHC - man blue