


CURVE DATA: RAD. = 745.75'
 A = 91.26' C = 91.20'
 S. 9° 44' 20" W.

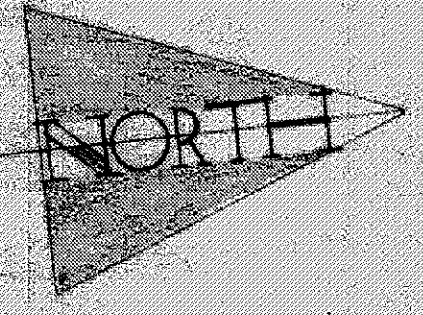

SL 15

SL 16

SL 17

SL 18

SITE PLAN FOR:

PEOPLES HOMES, INC
 7000 GRANGER ROAD
 CLEVELAND, OHIO

BEING SUBLOTS NO. 16 & 17 IN MORELY
 HILLS SUBDIVISION NO. 1 IN CONCORD TWP. OHIO

PREPARED BY:

WM. R. GRAY ASSOC. INC.
 7547 MENTOR AVE.
 MENTOR, OHIO

DATE: AUG. 26, 1974

SCALE: 1" = 20'

Grading Plan Approved
 as shown and/or noted
 THOMAS P. GILLES, P.E.
 Lake County Engineer

By: JWK Date 9-10-74

30000 Permit # 2725
 issued for SL # 17
 Permit # 2726 issued for SL # 16
 Aug 20-74 J.E. name sheet

CERTIFICATION:

I HEREBY CERTIFY THAT THE
 PLAN IS CORRECT TO THE BEST
 OF MY KNOWLEDGE.

By: Wm. R. Gray
 Wm. R. GRAY Reg. Sur.
 # 275

SAN. M.H. ADDITIONAL
 TBM. RIM EL. = 842.92
 INV. EL. = 834.94

ROAD SURFACE NOT ESTABLISHED
 AS OF THIS DATE: AUG. 23, 1974

STORM M.H. RIM EL. = 842.25
 INV. EL. = 834.52

SAN. M.H. T.B.M.
 RIM EL. = 840.76 INV. EL. = 831.00

OAKRIDGE DRIVE 60'

