

PARCEL 12  
RAINES CONSTRUCTION INC.  
VOL. 1199-1140  
1.712 ACRES

PARCEL 11  
CHAS. G. EISENHART  
VOL. 652-1060  
1.818 ACRES

PARCEL 47  
BRUCE & DOROTHY BOTCHICK  
VOL. 970031166  
4.3461 ACRES

PARCEL 50  
TODD K. HENKEL  
VOL. 980018520  
4.6314 ACRES

PARCEL 42  
ROBERT W. MACKNIGHT  
VOL. 980033009  
3.0142 ACRES

PARCEL 49  
CAROLE C. CLEMENT  
VOL. 970025492  
4.9642 ACRES

PARCEL 44  
GARY W. DARLING  
VOL. 960022785  
1.2263 ACRES

PARCEL 41  
SCOTT J. & CYNTHIA L. EDWARDS  
VOL. 585-61  
1.065 ACRES

REVIEWED AND ACCEPTED  
LAKE COUNTY GENERAL  
HEALTH DISTRICT

DATE 10/16/06 BY J.C. SKONIECZNY


SEWAGE DISPOSAL PERMIT MUST BE  
OBTAINED BY A LAKE COUNTY LICENSED  
INSTALLER BEFORE INSTALLATION IS  
STARTED.

NOTE!  
EXCAVATING CONTRACTOR TO FIELD VERIFY  
SERVICE CONNECTION LOCATION AND ELEVATIONS  
PRIOR TO BASEMENT EXCAVATION.

| Seeding Dates        | Species            | Lb./1,000 ft. <sup>2</sup> | Per Ac.  |
|----------------------|--------------------|----------------------------|----------|
| March 1 to August 15 | Oats               | 3                          | 4 bushel |
|                      | Tall Fescue        | 1                          | 40 lb.   |
|                      | Annual Ryegrass    | 1                          | 40 lb.   |
|                      | Perennial Ryegrass | 1                          | 40 lb.   |
|                      | Tall Fescue        | 1                          | 40 lb.   |
|                      | Annual Ryegrass    | 1                          | 40 lb.   |
| March 1 to August 15 | Rye                | 3                          | 4 bushel |
|                      | Tall Fescue        | 1                          | 40 lb.   |
|                      | Annual Ryegrass    | 1                          | 40 lb.   |
|                      | Wheat              | 3                          | 2 bushel |
|                      | Tall Fescue        | 1                          | 40 lb.   |
|                      | Annual Ryegrass    | 1                          | 40 lb.   |
|                      | Perennial Ryegrass | 1                          | 40 lb.   |
|                      | Tall Fescue        | 1                          | 40 lb.   |
|                      | Annual Ryegrass    | 1                          | 40 lb.   |

November 1 to Spring Seeding Use mulch only, sodding practices or dormant seeding.

Note: Other approved seed species may be substituted


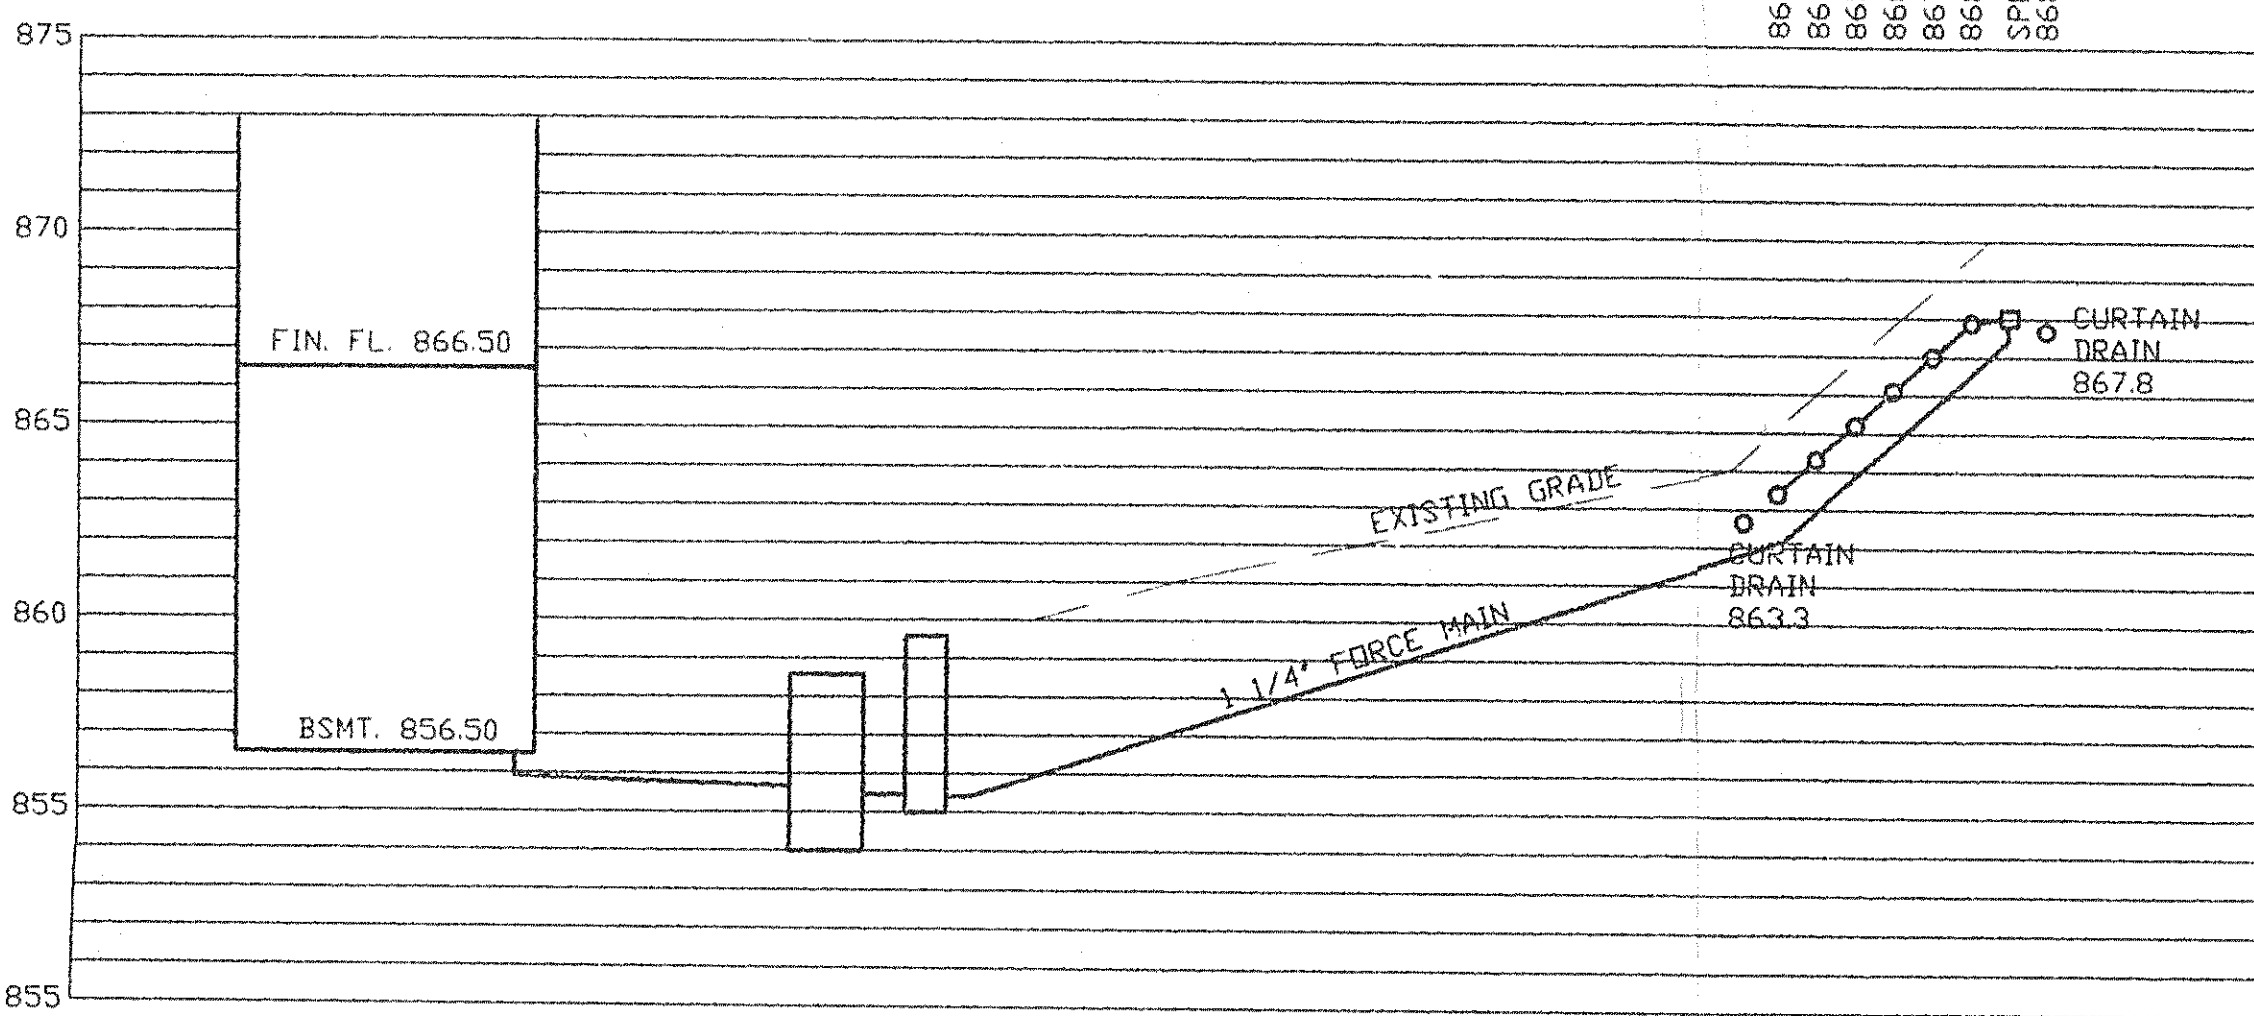


500 GAL/DAY NSF 40  
CLASS 1 AERATOR  
855.50IN/855.3 OUT

PROFILE  
HOR 1"=40'  
VERT 1"=5'

2 WORKING DAYS  
BEFORE YOU DIG

CALL TOLL FREE 800-362-2764  
OHIO UTILITIES PROTECTION SERVICE

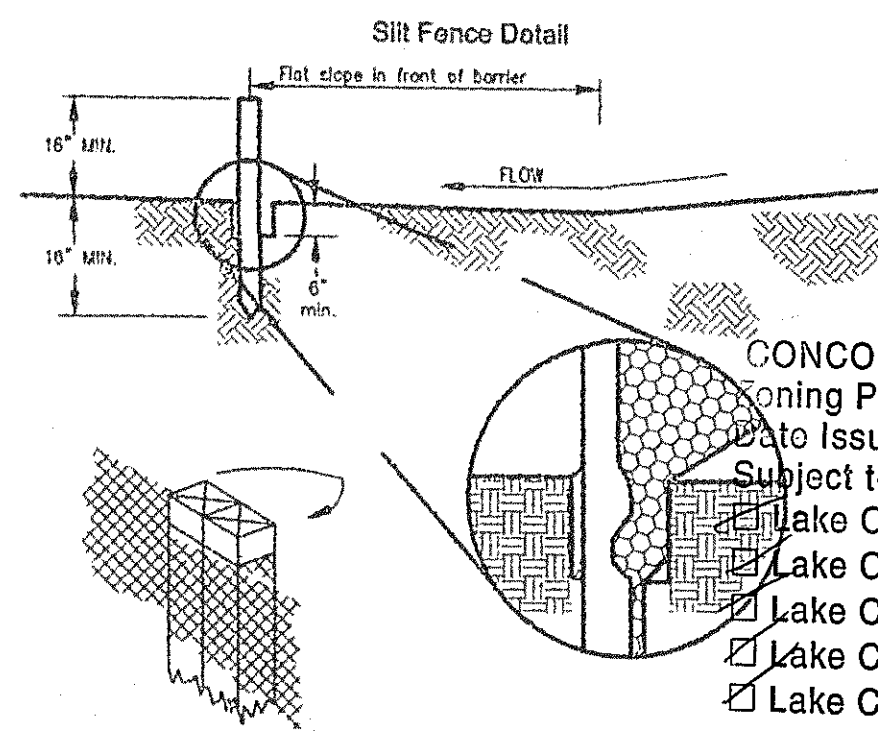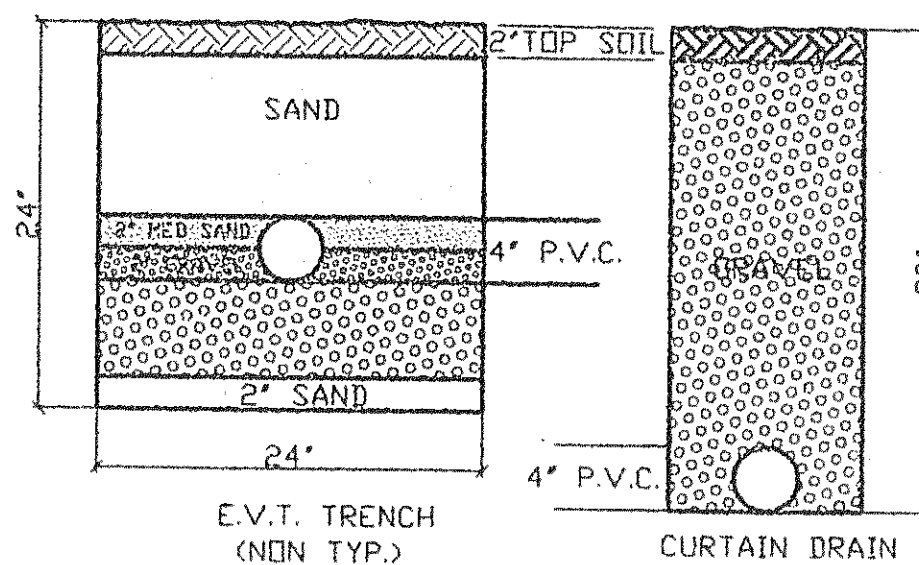

Temporary Seeding Specifications

Ingress-Egress  
A stone access drive complete with under lying geo-textile fabric (20 feet wide and 50 feet long) for ingress and egress at the site shall be installed. This drive shall be the only entrance and exit to the site.

Silt Fence  
All silt fence shall be installed prior to any earthwork activities at the site in the locations shown on the site plan as well as along the front of any lot that slopes towards the street.

Temporary Seeding  
Disturbed areas of the site that are to remain idle for more than thirty (30) days shall be properly seeded and straw mulched within seven (7) days of completion of initial grading. Temporary seeding and mulching of a thirty (30) foot strip of the entire front of the lot shall be maintained on the site once initial grading is complete.

Stabilization of critical areas within fifty (50) feet or any stream or wetland shall be complete within two (2) days of the disturbance if the site is to remain inactive for longer than fourteen (14) days.

Mulching  
Straw-mulch shall be applied at a rate of 1 bale per every ten (10) feet of curb, at a width of thirty (30) feet of the entire length of the lot. Wood chips may also be used but must be spread at a minimum depth of four inches over the thirty-foot width and must be accompanied by a properly installed silt fence.


Maintenance  
Erosion and sediment controls shall be inspected every seven (7) days of within 24 hours of a 0.5" or greater rainfall event. Necessary repairs shall be made at this time.

Note:  
All erosion and sediment control specifications, application, and timetables are based on the descriptions and standards of The Ohio Department of Natural Resources "Rainwater and Land Development Manual" and can be found in the Lake County Erosion and Sediment Control Rules as adopted December 21, 1999.

The specified erosion and sediment control standards are general guidelines and shall not limit the right of the county to impose, at any time, additional, more stringent requirements. Nor shall the standards limit the right of the county to.

NOTE: PROPERTY OWNER'S RESPONSIBILITY  
TO OBTAIN & MAINTAIN  
DRAINAGE EASEMENT

I CERTIFY THAT THIS PLAN  
WAS PREPARED BY ME AND IS  
CORRECT TO THE BEST OF  
MY KNOWLEDGE AND BELIEF  
JOHN C. SKONIECZNY  
REG. SURVEYOR #8356  
JOHN C. SKONIECZNY  
7739 VIEWMOUNT DR.  
PAINESVILLE, OHIO 44077  
PH. 352-7742

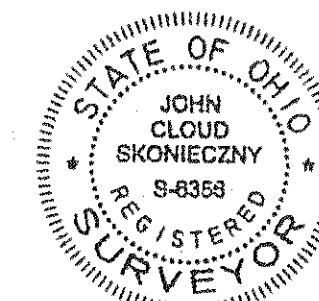

REVISION  
1 09/19/06 MOVE WATER WELL  
2 10/04/06 MOVE WATER WELL  
3 10/16/06 ADD 144LF OF SEPTIC LINE

GRAPHIC SCALE



|   |                           |
|---|---------------------------|
| SITE PLAN FOR:<br><b>BRUCE &amp; JENNIFER BOTCHICK</b>                                                                                                |                           |
| SCALE: 1" = 40'   | APPROVED: [Signature] SWC |
| DATE: OCT 99   | REVISION: [Signature]     |
| BEING A PART OF LOT NO. 13 TRACT NO. 1 SITUATED IN THE<br>TOWNSHIP OF CONCORD, VOLUME 970031166<br>TOWNSHIP OF CONCORD, COUNTY OF LAKE, STATE OF OHIO |                           |
| JOB# 99-2878   | 99-1817                   |