



KALMER ROAD CO.

Tom & Maureen

ISSUED 6-26-87
#5563
ZONING PERMIT
SUBJECT TO APPROVAL BY:
Lake County Board of Health
Lake County Planning Commission
Lake County Board of Health
Lake County Board of Health

100 year Flood Plain Elev. 628.50

EXISTING WALK:
TOP OF FLOOD H.W. Elev. 119.67

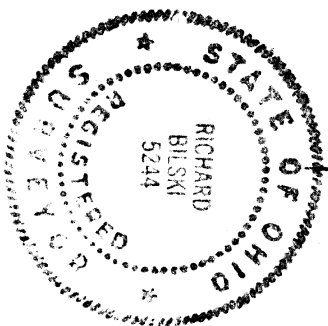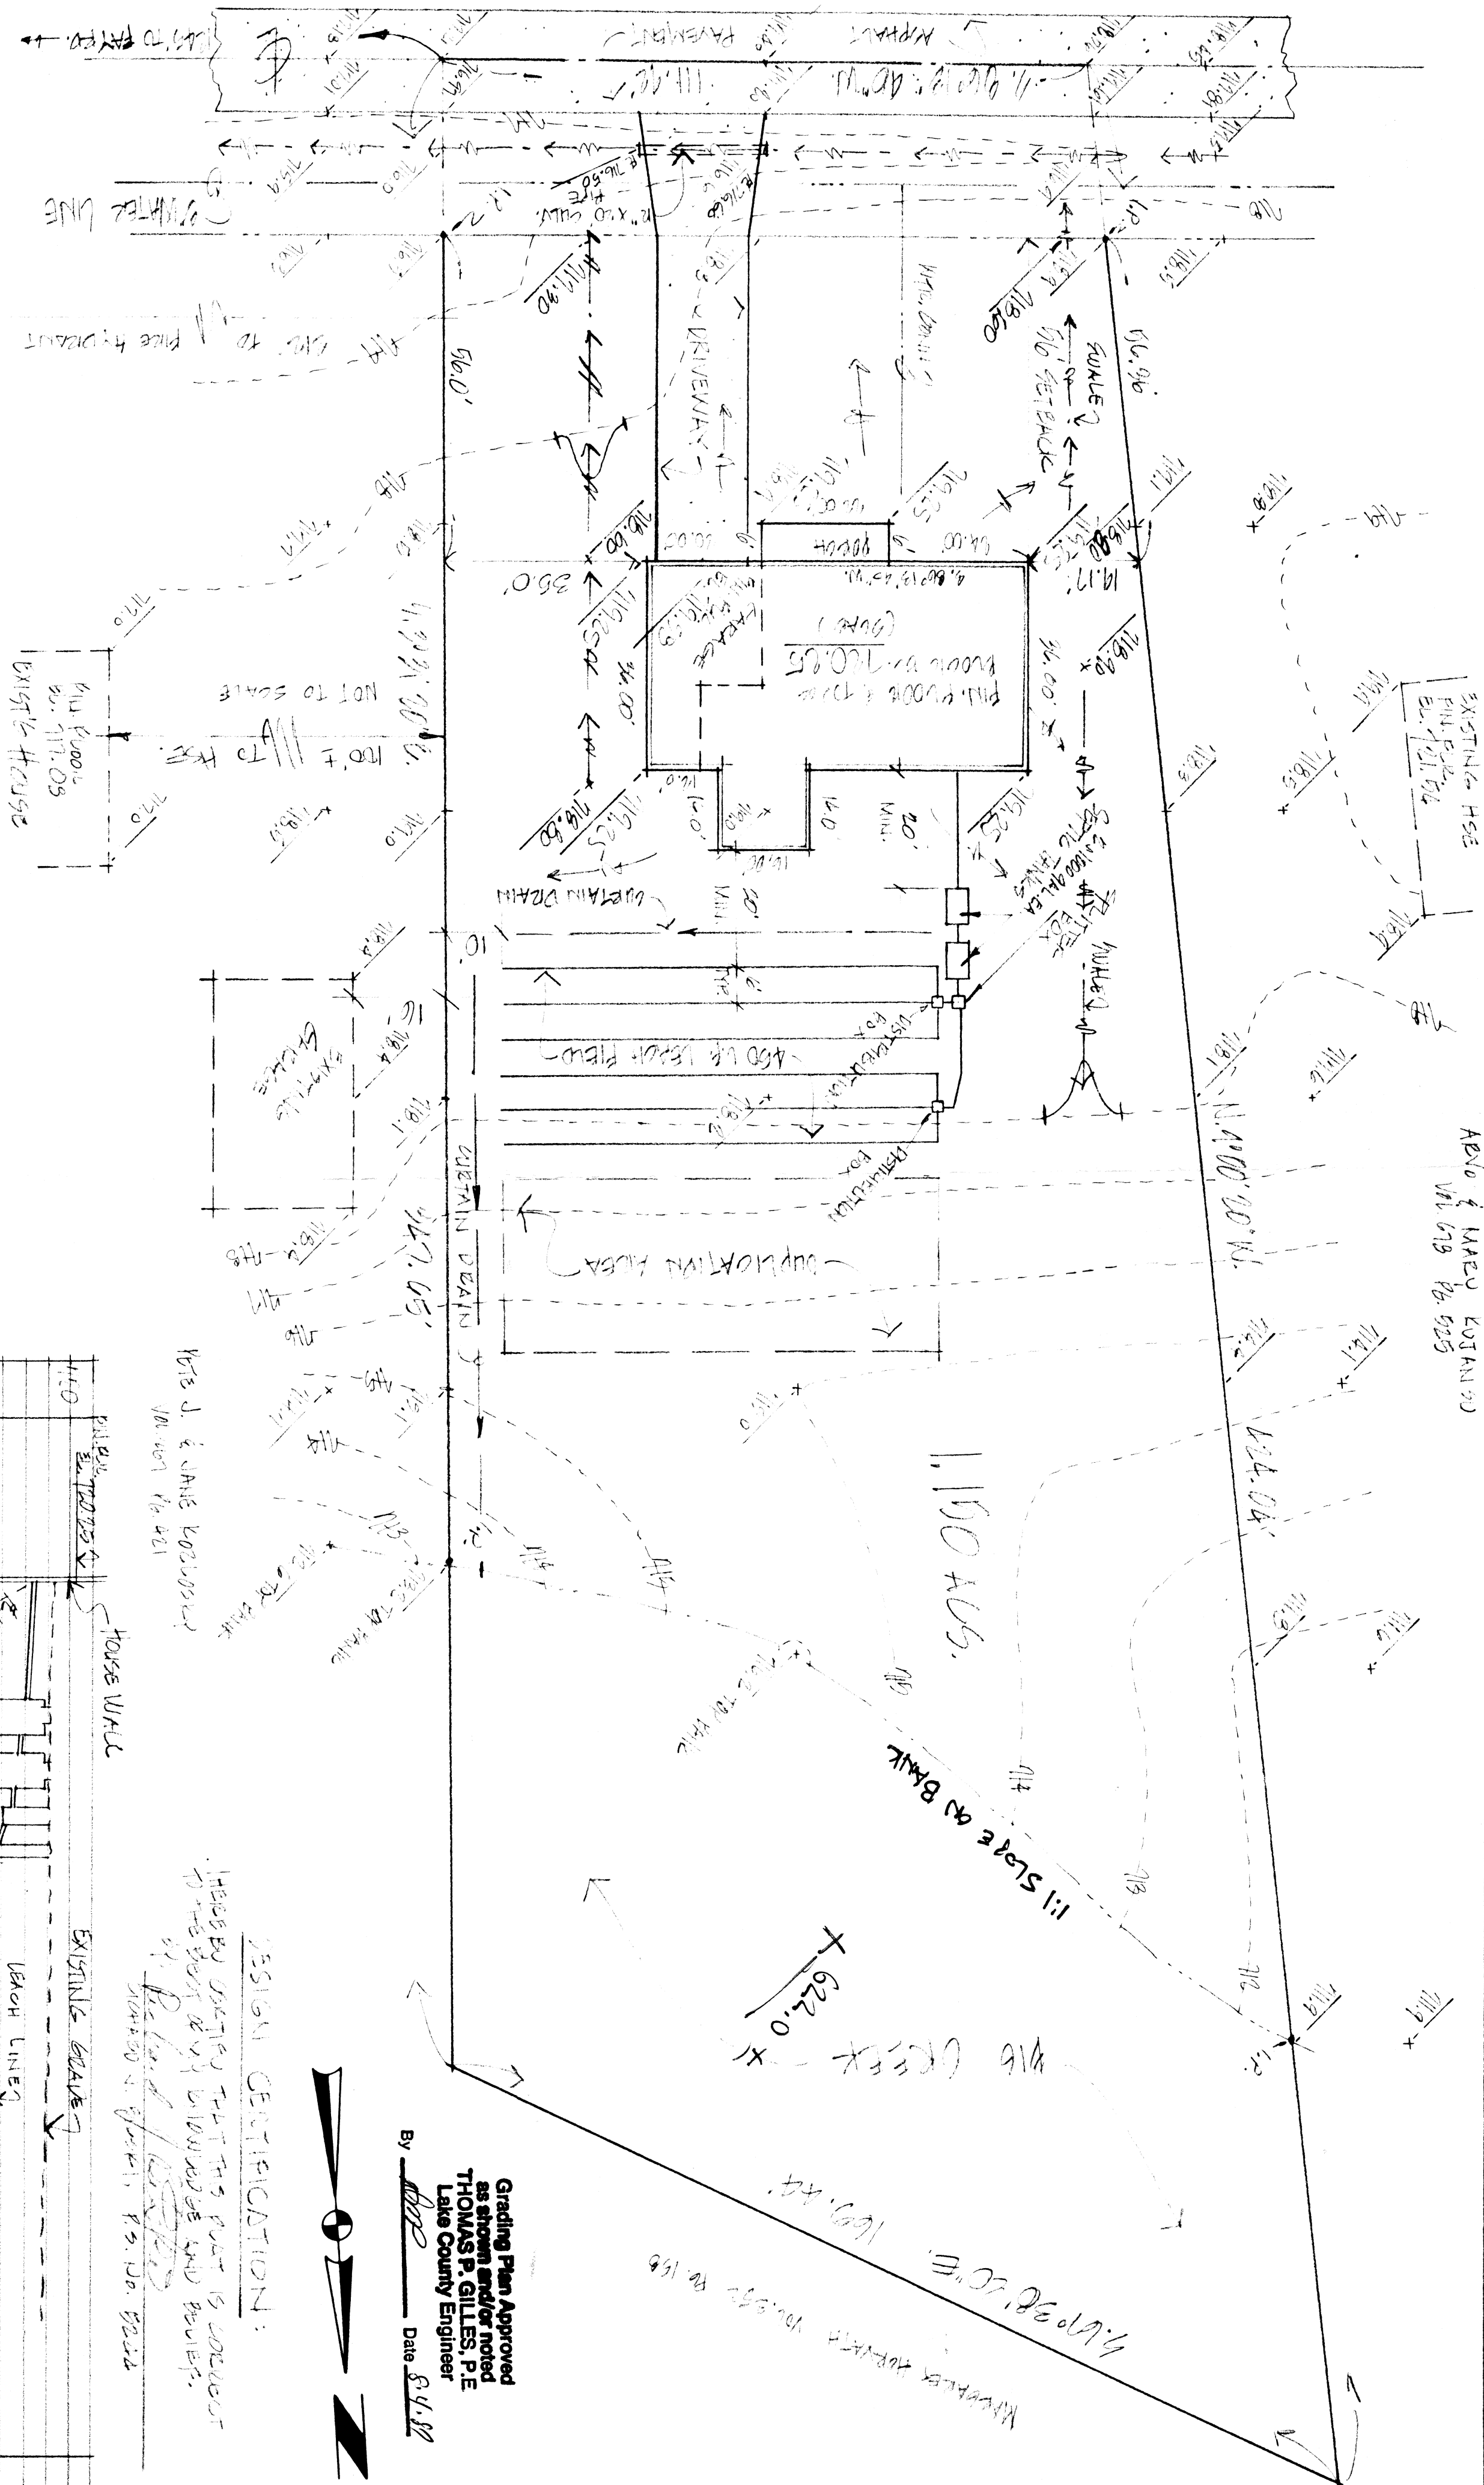

SITE PLAN FOR:
A. P. SIDLEY INC.
1001 MADISON AVENUE, PAINESVILLE, OHIO
BEING A PART OF LOT NO. 5, TRACT NO. 2 IN CONCORD TOWNSHIP, LAKE COUNTY, OHIO

DATE: 6/26/87
SCALE: 1"=30'
DRAWN BY: GDE
CHKD BY: GDE
F&E 5731 PG. 41

COLPETZER-THOMAS, INC.
AN ENGINEERING GROUP
WILLOUGHBY • MENOR • NORTH CANTON • STEUBENVILLE • LOBAIN

SHEET 1 OF 1
CONTRACT NO. 87-341