
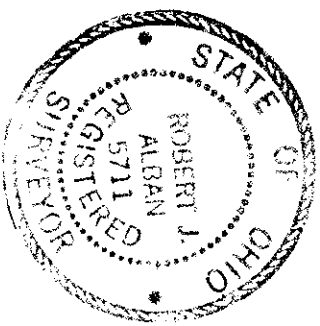


EXISTING GRADE  
PROPOSED GRADE  
EXIST ELEV 1090  
PROPOSED ELEV 1091  
ASPHALT CONCRETE DRIVEWAY GOVERNMENT;  
711-504 BASE; 111-402 LEVING COURSE;  
111-404 SURFACE COURSE

ZONING PERMIT #4838  
ISSUED 5-14-84  
SUBJECT TO APPROVAL BY:  
Lake County Sanitary Eng. ☐  
Lake County Eng. Dept. ☒  
Lake County Planning Comm. ☐  
Lake County Bldg. Dept. ☒  
Tara M. McNamee

Grading Plan Approved  
as shown and/or noted  
by Thomas P. Gilles, P.E.  
Lake County Engineer  
Date: 17 MAY 84

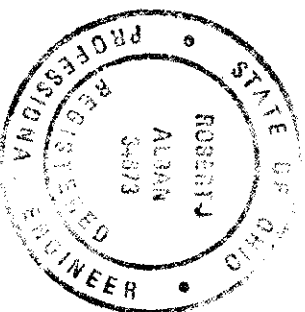

|                                |                |
|--------------------------------|----------------|
| DENMAN SITE PLAN               |                |
| SCALE 1"=20'                   | APPROVED BY    |
| DATE 5/18/84                   | DRAWN BY       |
| CONCORD TWP, LAKE COUNTY, OHIO |                |
| 10000 S/L 3 PINECREST SUBD.    | DRAWING NUMBER |

BENCH MARK 711 UAIL IN 18" OAK TREE  
NORTH SIDE OF PINECREST RD. EL. 1080.97

