


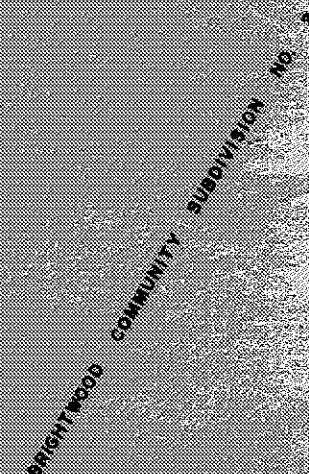

- ### Notes :
1.  EXISTING GROUND ELEVATION
 2.  PROPOSED GROUND ELEVATION
 3.  EXISTING GROUND GRADE
 4.  PROPOSED GROUND GRADE
 5.  CENTERLINE OF PROPOSED SWALE
 6. BENCH MARK: TOP OF IRON PIN AT NORTHEAST CORNER OF PAUL C. HETH PROPERTY
ELEV. 100.00


Grading Plan Approved
as shown and/or noted
THOMAS P. GILLES, P.E.
Lake County Engineer

By JWK Date 3-

CONCORD REQUEST THAT
OUR APPROVAL BE FIRST RE
THIS PLAN ONLY.

VERT


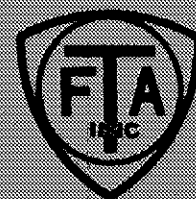

FRANK A. THOMAS & ASSOCIATES, INC.
CONSULTING ENGINEERS
WILLOUGHBY, OHIO

DRAWN BY: C.F.W.

CHECKED BY: P.W.S

DATE: MARCH 20