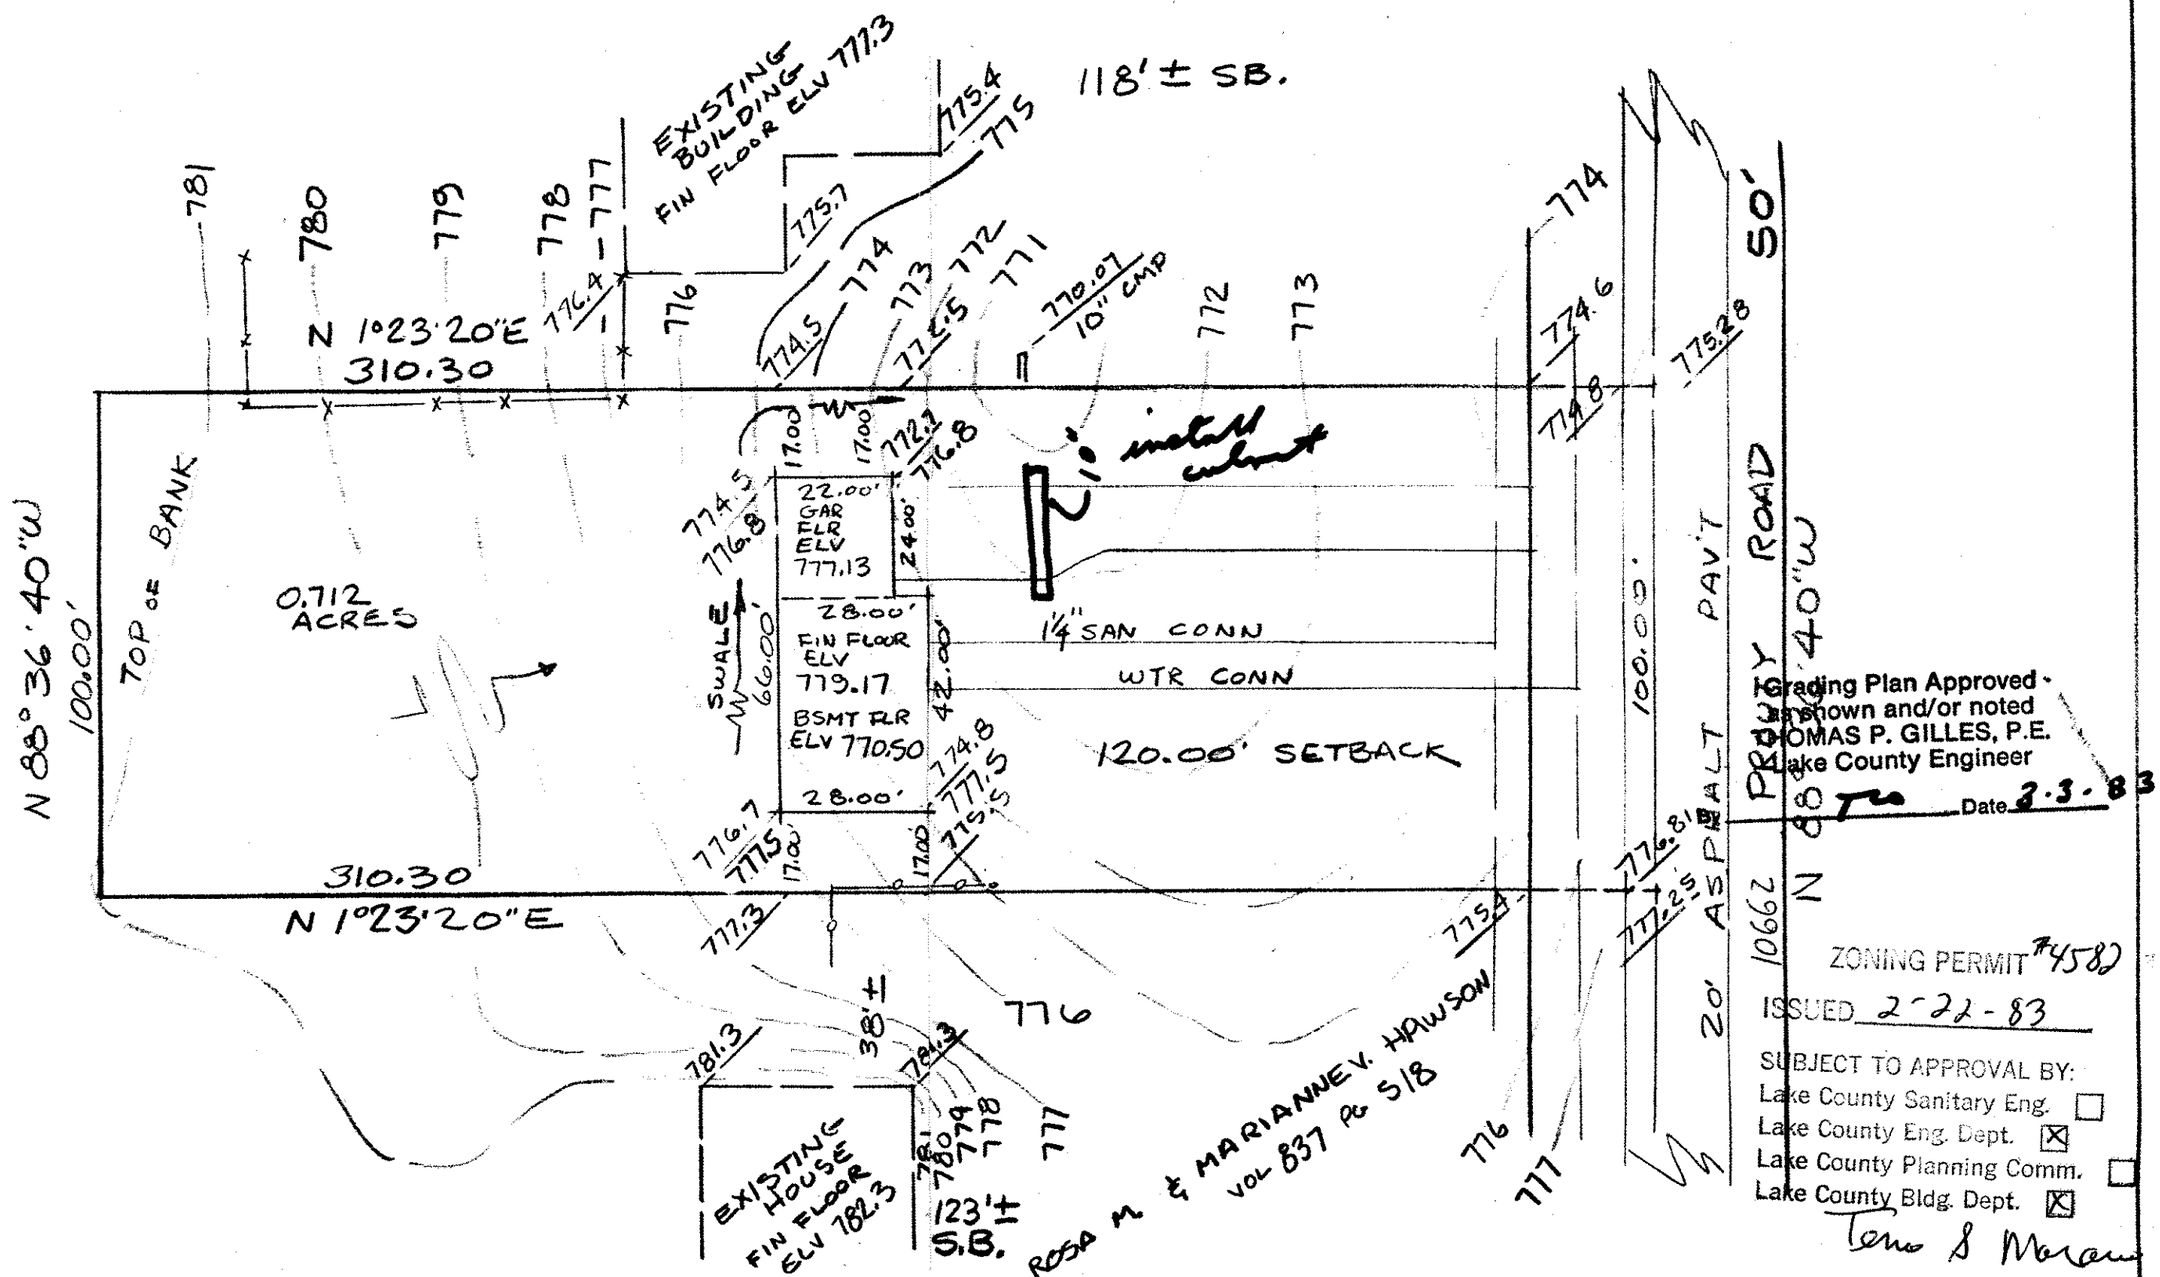

Grading Plan Approved as shown and/or noted
THOMAS P. GILLES, P.E.
Lake County Engineer
By Tro Date 2-3-83

ZONING PERMIT #4582
ISSUED 2-22-83

SUBJECT TO APPROVAL BY:
Lake County Sanitary Eng. ☐
Lake County Eng. Dept. ☒
Lake County Planning Comm. ☐
Lake County Bldg. Dept. ☒
Terry S Moran

DESIGN CERTIFICATION
THIS PLAT WAS PREPARED BY ME, AND IS CORRECT TO THE BEST OF MY KNOWLEDGE AND BELIEF.
Richard A. Bilski
REG. SURVEYOR NO. 5244

AS BUILT CERTIFICATION
I HEREBY CERTIFY THAT THE CIRCLED GRADES ARE EXISTING FINISH GRADES CHECKED IN THE FIELD ON _____ AND THAT SURVEY IS CORRECT TO THE BEST OF MY KNOWLEDGE AND BELIEF.
REG. SURVEYOR NO. _____

COLPETZER · WOODS
CONSULTANTS, INC.
9470 MENTOR AVENUE • MENTOR, OHIO 44066 • (216) 357-7569

DATE 2·18·83
SCALE 1"=30
DRWN BY RJB
CHKD BY RJB
JOB NO. 83
FB ____ PG ____

SITE PLAN
for BETTELEY BUILDERS INC. of 0.712 AC. BEING PART OF ORIG. LOT Nº 36 TRACT Nº 4 NOW IN CONCORD TWP~LAKE COUNTY NO.