


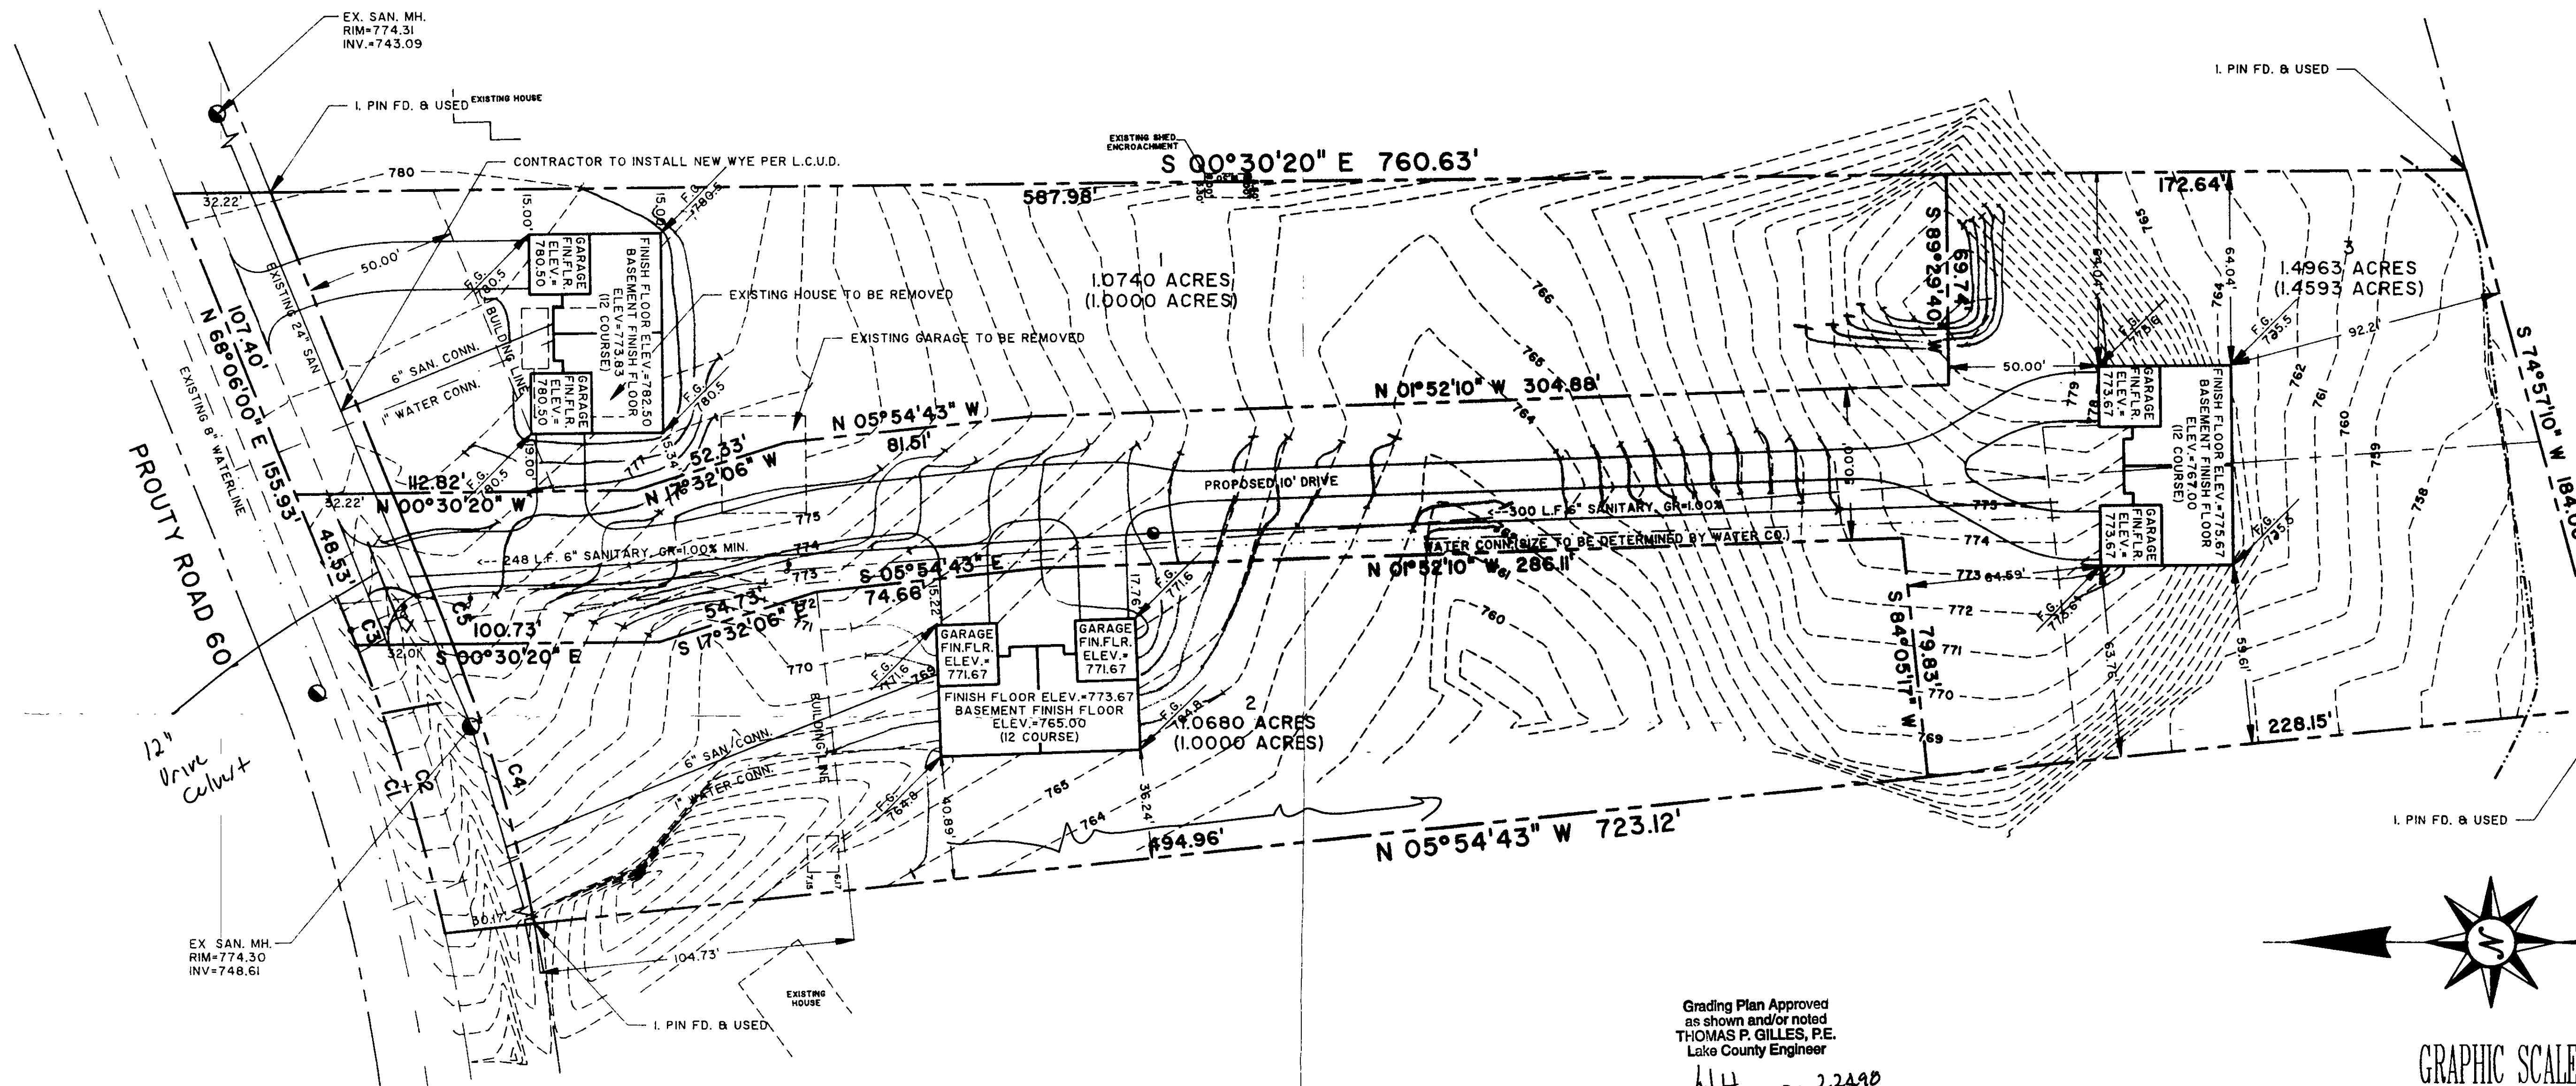


CURVE	RADIUS	ARC LENGTH	CHORD LEN	CHORD BEARING	DELTA ANGLE	TANGENT
C1	625.00'	105.55'	105.42'	N 72°56'13" E	09°40'34"	52.90'
C2	625.00'	100.39'	100.28'	N 73°10'25" E	09°12'10"	50.30'
C3	625.00'	5.16'	5.16'	N 68°20'08" E	00°28'24"	2.58'
C4	655.00'	97.09'	97.00'	N 73°49'07" E	08°29'35"	48.63'
C5	655.00'	16.84'	16.84'	N 68°50'08" E	01°28'24"	8.42'

Grading Plan Approved
as shown and/or noted
THOMAS P. GILLES, P.E.
Lake County Engineer

- By DLH Date 2.24.98
- Install erosion control around perimeter of site
 - 12" Drive Culvert
 - Swale as shown


ZONING PERMIT 12-31-97
ISSUED 12-31-97

SUBJECT TO APPROVAL BY:
Lake County Sanitary Eng. ☒
Lake County Eng. Dept. ☒
Lake County Planning Comm. ☒
Lake County Bldg. Dept. ☒

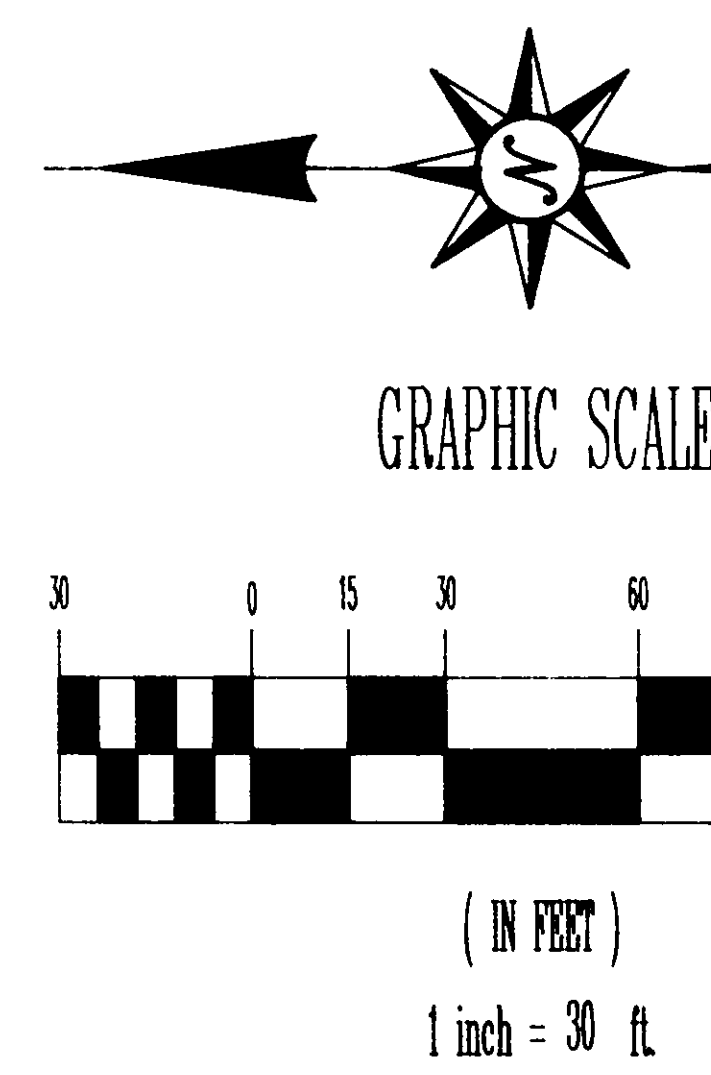

"I HEREBY CERTIFY THAT THIS PLAN W
AND IS CORRECT TO THE BEST OF MY
DAVID W. NOVAK
DAVID W. NOVAK

REV. No.	DESCRIPTION	DATE	BY	CHK'D
A	REVISED FINAL GRADE AND BLDG.	02/11/98	DWN	

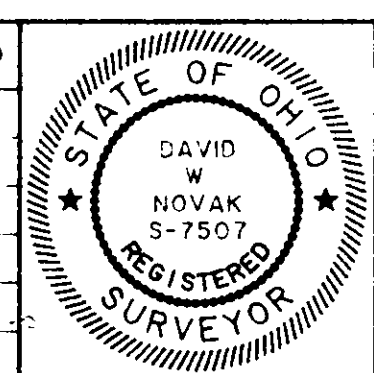

Himebaugh and Novak
Surveyors and Site Consultants
38342 Western Parkway, Unit 10
Willoughby, Ohio 44094
(440) 946-1761, (440) 918-0486 FAX.

EYE-WILL DEVELOPMENT, INC.
759 LAKESHORE BLVD., UNIT F, PAINESVILLE, OH 44077

DATE:	AUG. 12, 1997
DRAWN BY:	D. W. NOVAK
CHECKED BY:	DWN
APPROVED BY:	
F.B. No.	PG.

SITE PLAN
1110 PROUTY ROAD, CONCORD