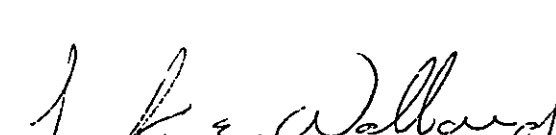


A circular professional seal for a surveyor in the State of Ohio. The outer ring contains the text "STATE OF OHIO" at the top and "PROFESSIONAL SURVEYOR" at the bottom, separated by a decorative wavy line. In the center, the name "Frank E. Walland" is written in a serif font. Below the name, the number "S-7556" is printed, and at the very bottom of the center, the word "REGISTERED" is written in a smaller, all-caps font.

Stormwater Management Plan
Approved as shown and/or noted
JAMES R. GILLS, P.E.
County Drainage Engineer
By LS Date 11/21/06


FRANK E. WALLAND, P.S. NO. 7556