

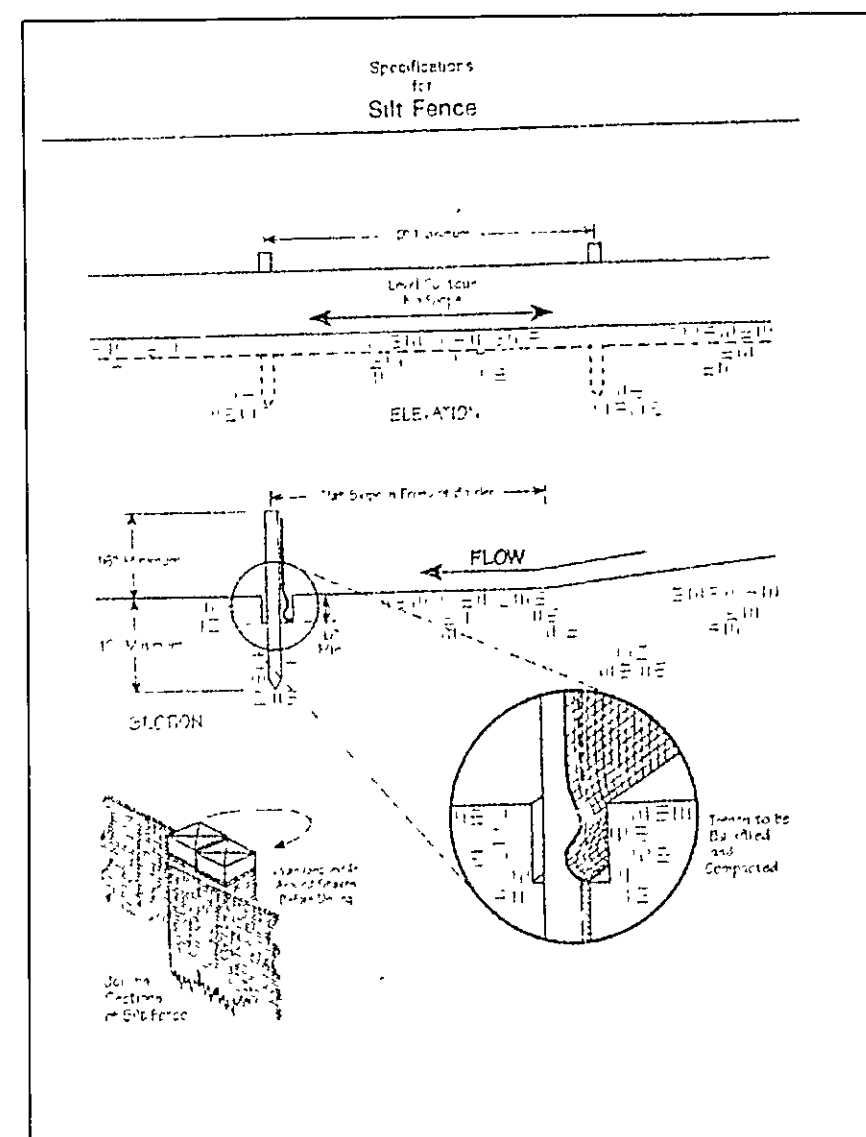


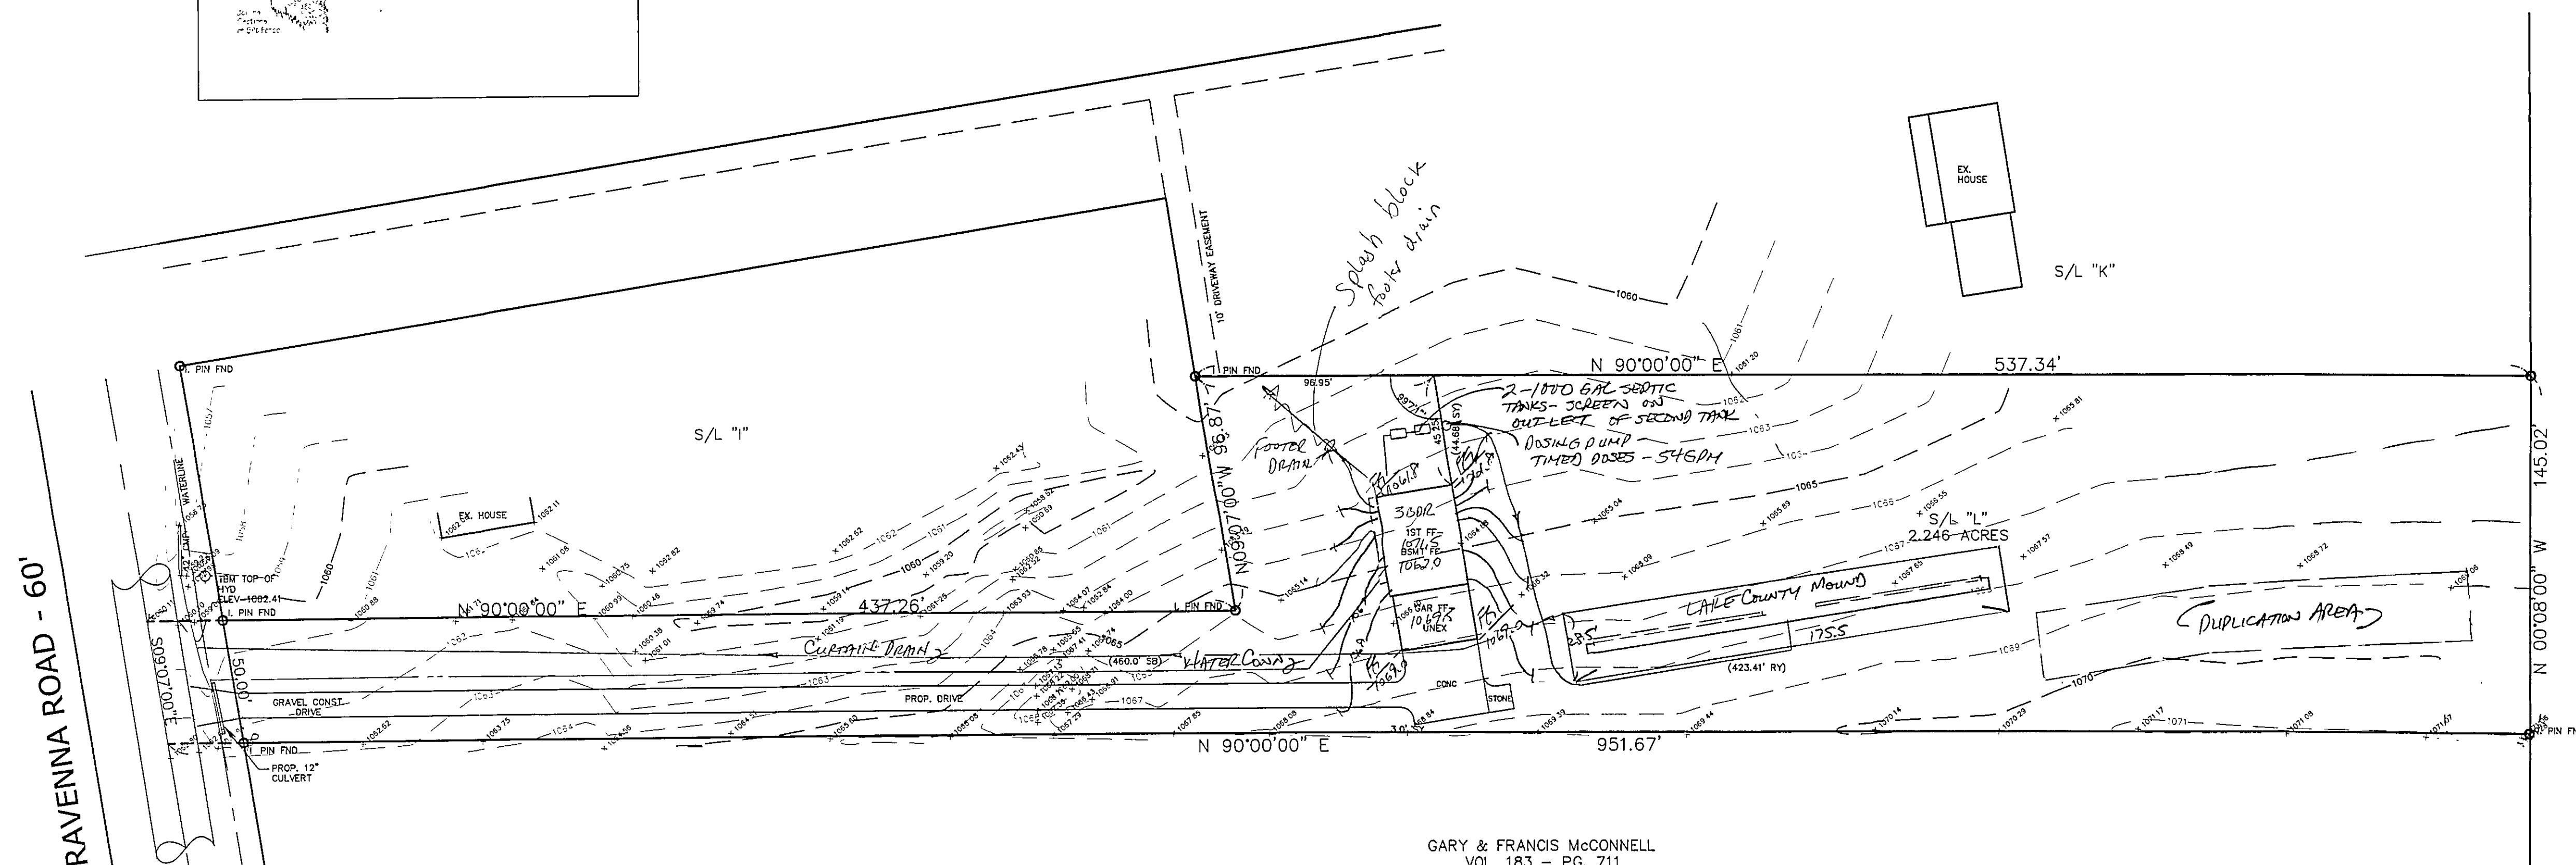

Temporary Seeding Species Selection			
Seeding Dates	Species	Lb./1,000 ft. ²	Per Ac.
March 1 to August 15	Oats	3	4 bushel
	Tall Fescue	1	40 lb.
	Annual Ryegrass	1	40 lb.
	Perennial Ryegrass	1	40 lb.
	Tall Fescue	1	40 lb.
	Annual Ryegrass	1	40 lb.
August 16 to November 1	Rye	3	2 bushel
	Tall Fescue	1	40 lb.
	Annual Ryegrass	1	40 lb.
	Wheat	3	2 bushel
	Tall Fescue	1	40 lb.
	Annual Ryegrass	1	40 lb.
	Perennial Ryegrass	1	40 lb.
	Tall Fescue	1	40 lb.
	Annual Ryegrass	1	40 lb.
November 1 to Spring Seeding	Use much only, sodding practices or dormant seeding.		
Note. Other approved seed species may be substituted.			

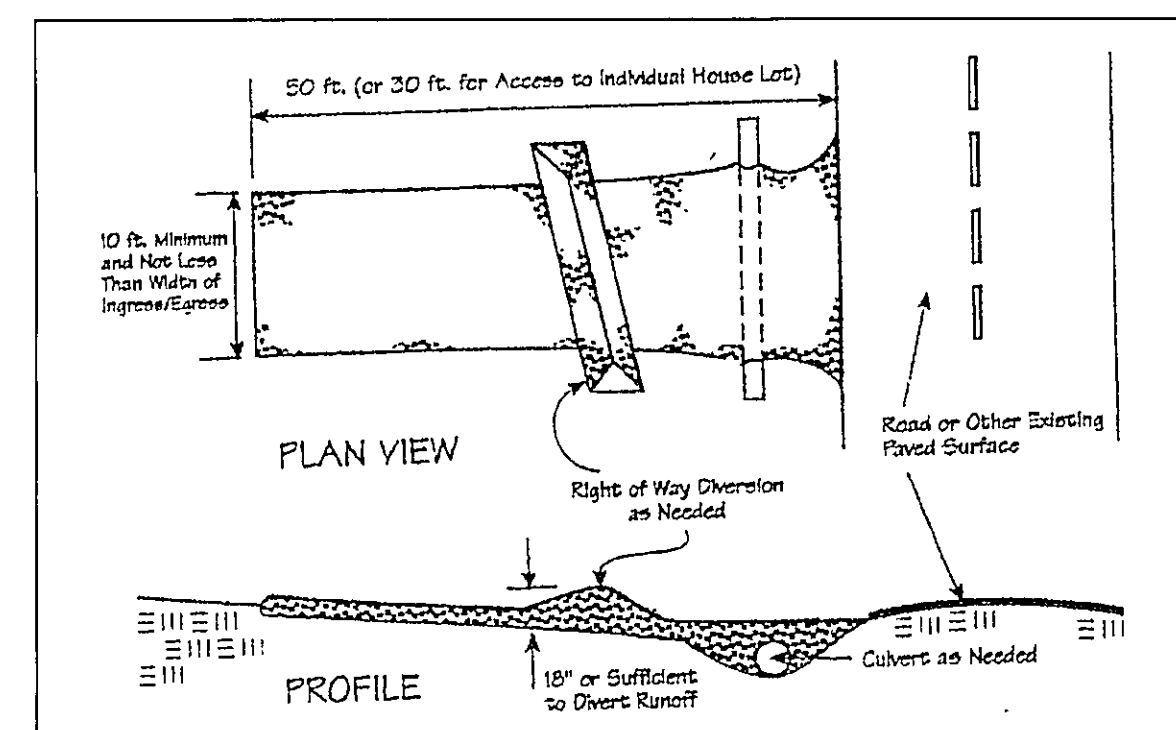


GARY & FRANCIS McCONNELL
VOL. 183 - PG. 711
8A-1-11

REVIEWED AND ACCEPTED
LAKE COUNTY GENERAL
HEALTH DISTRICT

DATE 5-27-4 BY Deu

SEWAGE DISPOSAL PERMIT MUST BE
OBTAINED BY A LAKE COUNTY LICENSED
INSTALLER BEFORE INSTALLATION IS
STARTED

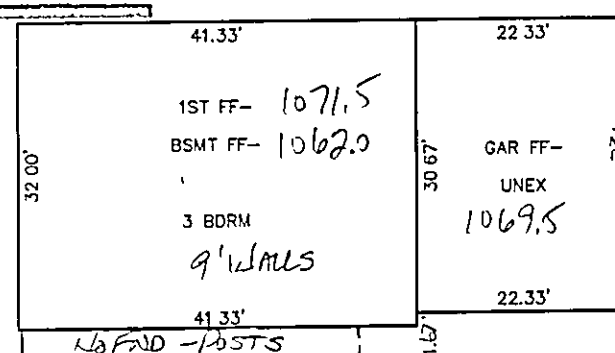

SCALE 1"=20'

Stormwater Management Plan
Approved as shown and/or noted
JAMIE R. GILLES, P.E.
County District Engineer
By: 6517 Date 6/5/89


ROOF DRAINS
SHALL DISCHARGE
TO SPLASH BLOCKS.

TBM TOP OF HYDRANT
ELEV-1082.41

"I, the undersigned hereby certify that this topography indicated by 6", 1' or 2' contours, and elevations shown hereon represent an actual field survey made by me on the 14th day of JULY, 2003 and that the elevations were taken at appropriate intervals and that as of that date they existed as indicated hereon."

Name Heustice #6343 Reg. No.

EXISTING UTILITIES NOTE:
THE SIZE AND LOCATION, BOTH HORIZONTAL AND VERTICAL
OF THE UNDERGROUND UTILITIES SHOWN HEREON, HAVE BEEN
OBTAINED BY A SEARCH OF AVAILABLE RECORDS.
VERIFICATION BY FIELD OBSERVATION HAS BEEN CONDUCTED
WHERE PRACTICAL, HOWEVER, BABCOCK, JONES AND ASSOCIATES
INC. DOES NOT GUARANTEE THE COMPLETENESS NOR ACCURACY
THEREOF.

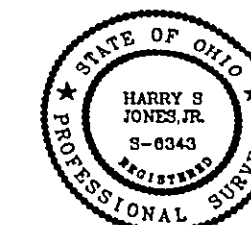

REV NO.	DESCRIPTION	DATE	BY	CHK'D
1	MOVED HOUSE AND DRIVE	4/11/04	N.S.	H.J.
2	REVISED HOUSE DIM.	4/13/04	ART	ART
3	REVISIONS PER L.C. PERMIT DEPT	5/21/04	LS	ART

bj BABCOCK, JONES AND ASSOCIATES, INC.
CIVIL ENGINEERS – SURVEYORS – LAND PLANNERS
PAINESVILLE OHIO 44077

DATE	7/15/03
DESIGN BY	HJ
DRAWN BY	NS
APPROVED BY	H.J.

SITE PLAN FOR JOHN GARVEY

CONCORD TOWNSHIP LAKE COUNTY STATE OF OHIO

SCALE	1"=40'
JOB NO	03-15
SHEET	0
1	2