


for : A.D. SIDLEY INC
CLIENT

20 WATERFORD LANE PAINESVILLE

CITY


39	WOODS of CONCORD		
SUBLOT No.	SUBDIVISION NAME	VOL.	PAGE
29 4	CONCORD, LAKE Co.		OHIO
LOT, TRACT			

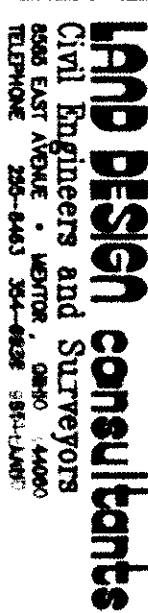

THIS PLAT WAS PREPARED BY ME, AND IS CORRECT TO THE
BEST OF MY KNOWLEDGE AND BELIEF.

NAME ALY. HENRY R. 5. 94

1-LOT DIMENSIONS & BEARINGS
 TO NEAREST STREET
 -SUBLOT NO. (PARCEL No.)
 SURROUNDING OWNERS
 BUILDING DIMENSIONS
 SETBACK, SIDEYARD, REAR YARD
 PAINTED ARCADES TYPE, WIDTH, THICKNESS
 SIDEWALK TYPE, WIDTH, THICKNESS
 CULVERT TYPE, DIA.M., LENGTH
 WATER MAIN SIZE, LOCATION
 SAN. SEWER SIZE, IN, GRADE, LOC.
 SAN. H. CAST. ELEV., INV. ELEV.
 SAN. COAST. SIZE, IN, GRADE, LOC.
 SAN. COAST. ELEV., INV. ELEV.
 STORM H. CAST. ELEV., INV. ELEV.
 PAYT. TYPE, SIZE
 GAS LINE LOC., SIZE
 SEPTIC SYSTEM & DUCTIFICATION RADII
 WELL LOCATION & ISOLATION RADII

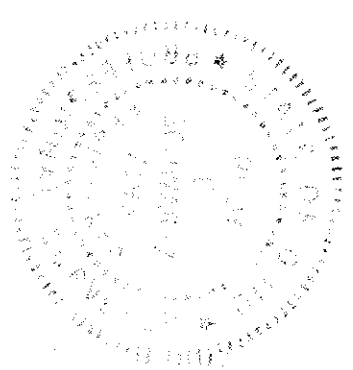

I HEREBY CERTIFY THAT THE CIRCLED INFORMATION IS
EXISTING AS OBTAINED ON THE SITE _____
19 _____ AND IS CORRECT TO THE BEST OF MY KNOWLEDGE
AND BELIEF.


1

DRAWN BY TTC	SCALE "
-----------------	------------

STORM MAINHOLE
SANITARY MAINHOLE
EXISTING CONTOURS
PROPOSED CONTOURS
EXIST. ELEV. 100.0
100.0 PROP. ELEV.
DIRECTION OF
SURFACE DRAINAGE

1	
2	

DATE _____

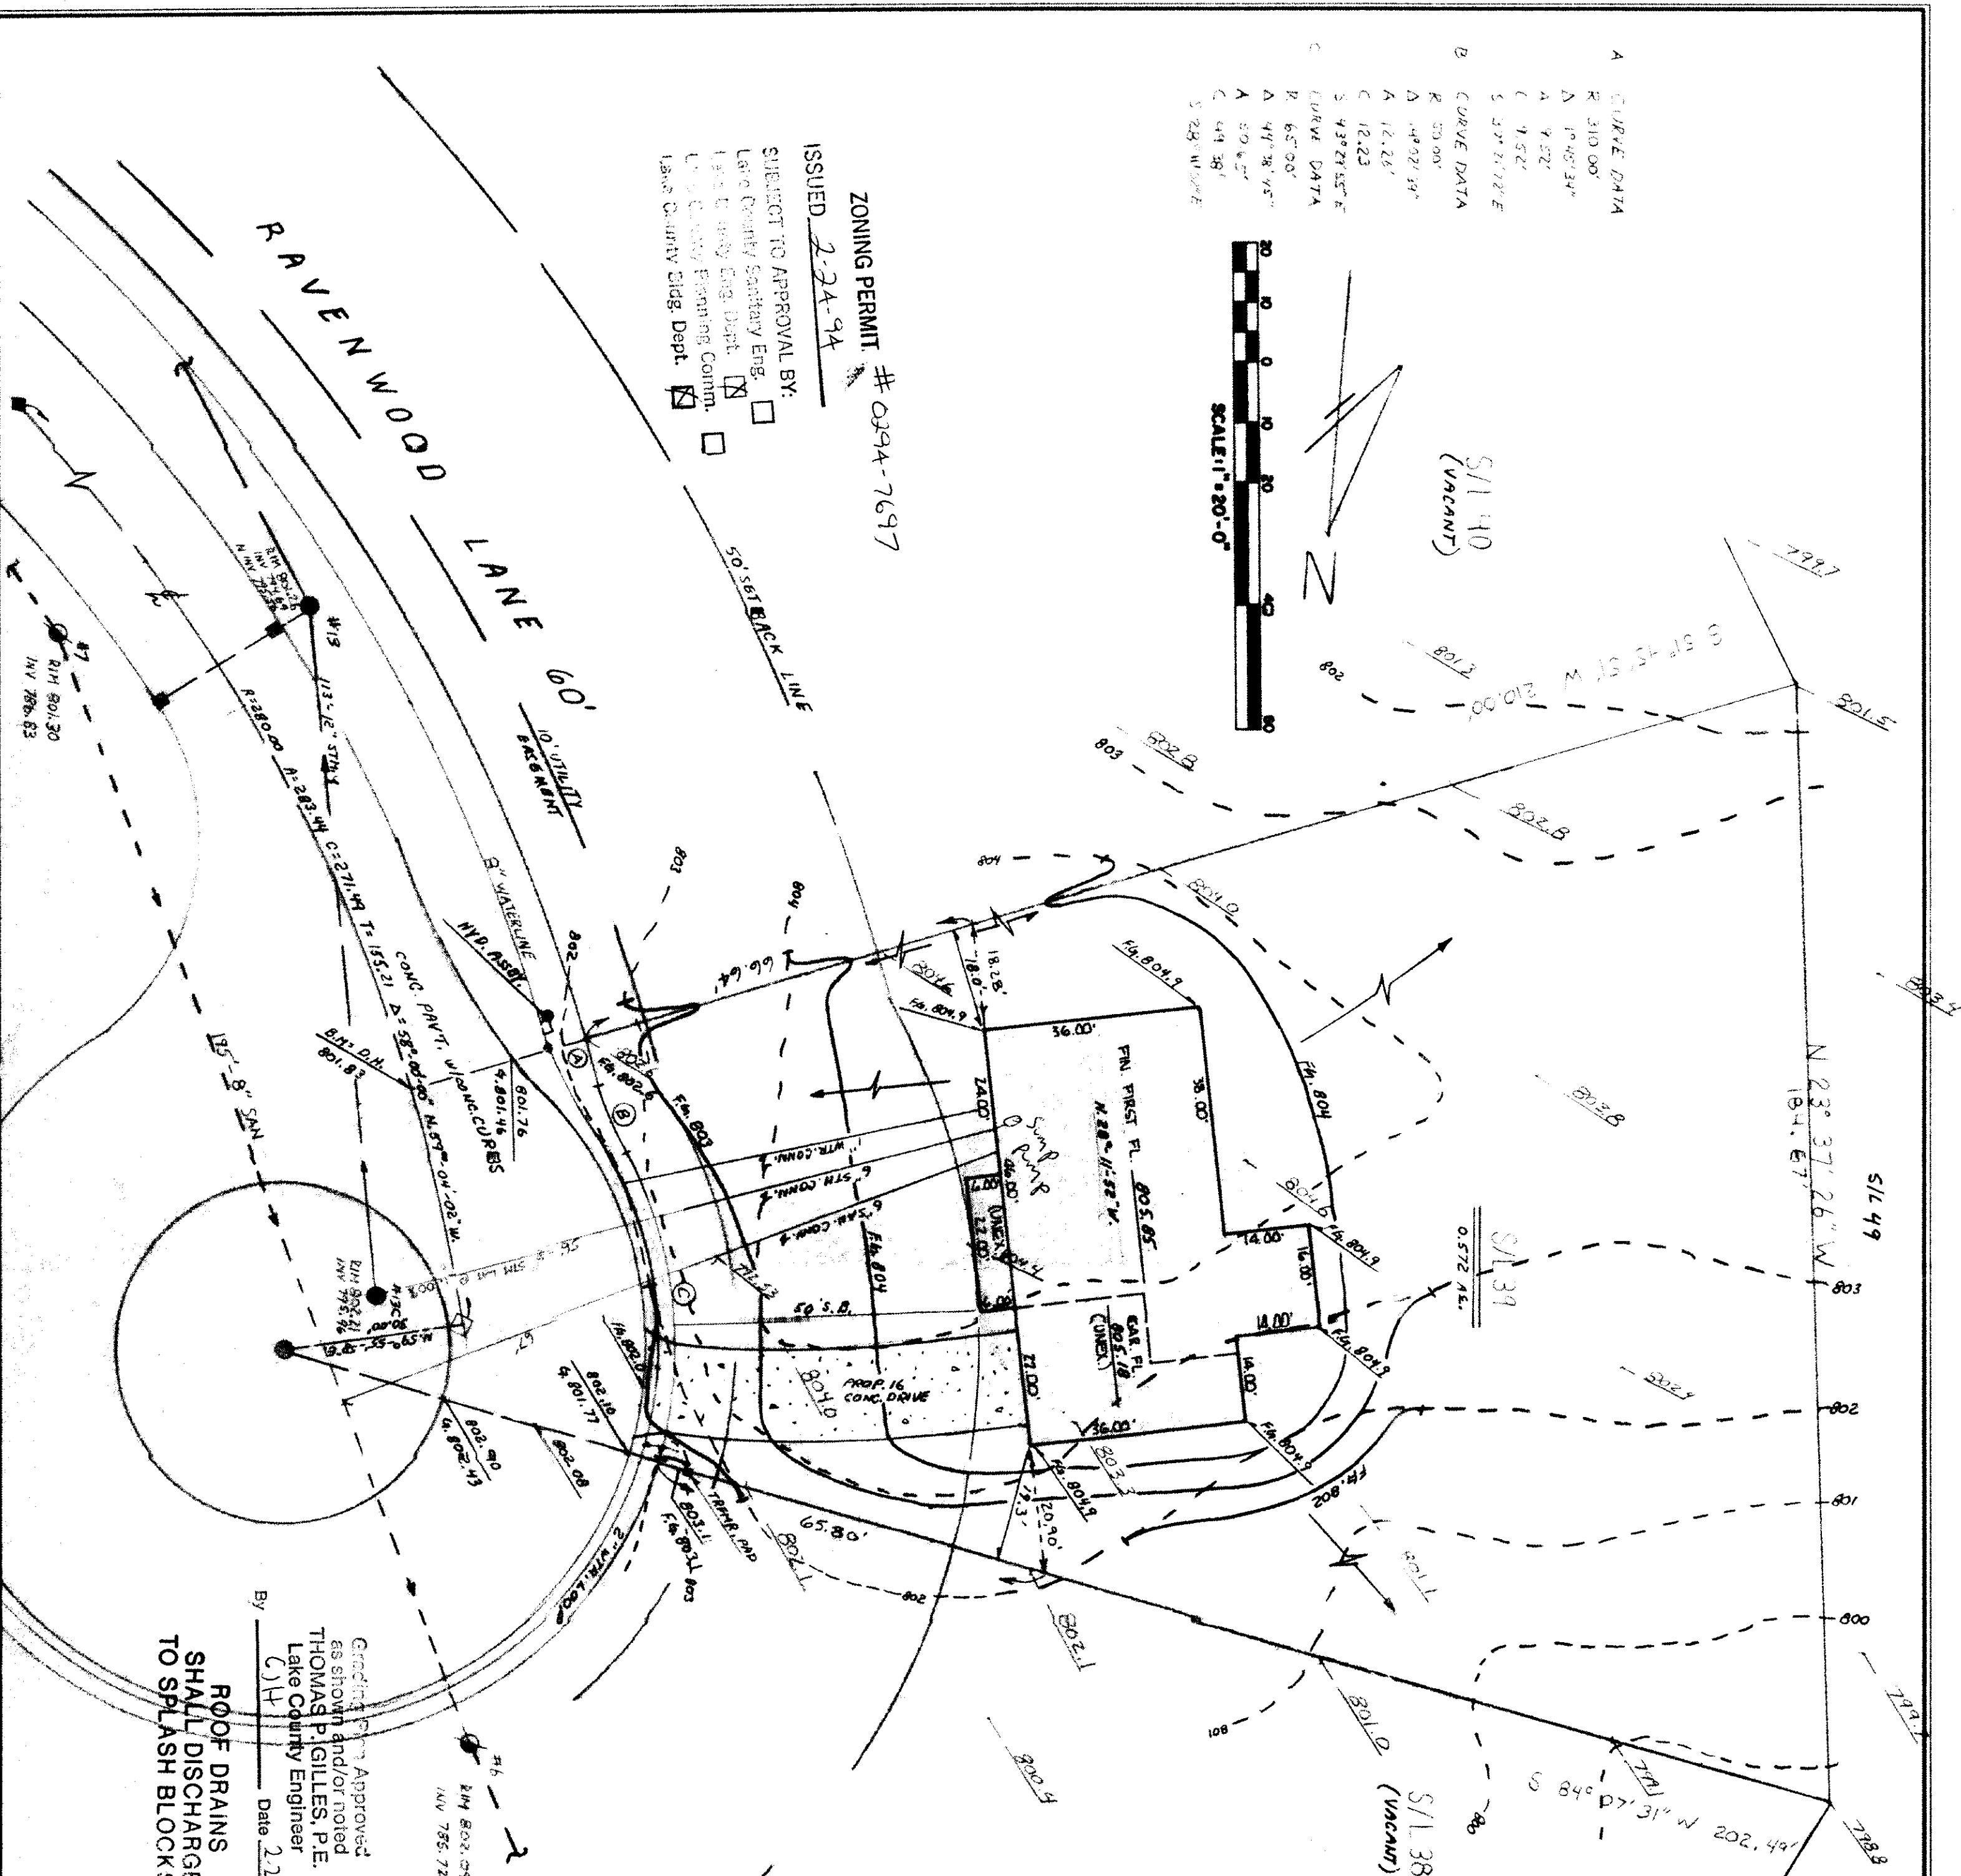

A CURVE DATA
R 310.00"
Δ 1°45'34"
A 7.52"
C 7.52"
S 37°21'22"E

B CURVE DATA
R 330.00"
Δ 1°49'27.34"
A 12.26"
C 12.23"
S 43°24'55"E

C CURVE DATA
R 652.30"
A 41°18'45"
A 59.65"
C 44.38"
S 228°41'50"E

(vacant)

SCALE: 1" = 20'-0"

ISSUED 2-24-94

SUBJECT TO APPROVAL BY:


RAVENWOOD
LANE

**ROOF DRAINS
SHALL DISCHARGE
TO SPLASH BLOCKS**

Grading Plan Approved
as shown and/or noted
THOMAS P. GILLES, P.E.
Lake County Engineer
CJT
By _____ Date 2-25-94

[illegible]

DRAWING NO. 92-179