

SITE DRAINAGE PLAN FOR:

O.E. WOOD
1087 SANDPIPER CT.
PAINESVILLE, OHIO.

BEING SUB-DT NO. 104 IN
EIGHT WOOD SUBD NO. 2 IN
CONCORD TWP. OHIO.

PREPARED BY:

WM. R. GRAY ASSOC., INC.
CIVIL ENGINEERS & SURVEYORS
1547 MENTOR AVENUE
MENTOR, OHIO 44060
DATE: JUNE 21, 1973 SCALE: 1" = 20'

SANDPIPER

SANITARY MH.
KIN. 771.92
INV. 762.53

CT. CO.

0" SAN. SEW @ 2.00% →


Young Farm # 2506
acquired June 21, 1973

1/2 E. man block

CERTIFICATION

I HEREBY CERTIFY THAT THIS
PLAN IS CORRECT TO THE
BEST OF MY KNOWING EDGE.

BY: *[Signature]*
WM. R. GRAY, P.E.
1547 MENTOR AVENUE
MENTOR, OHIO 44060

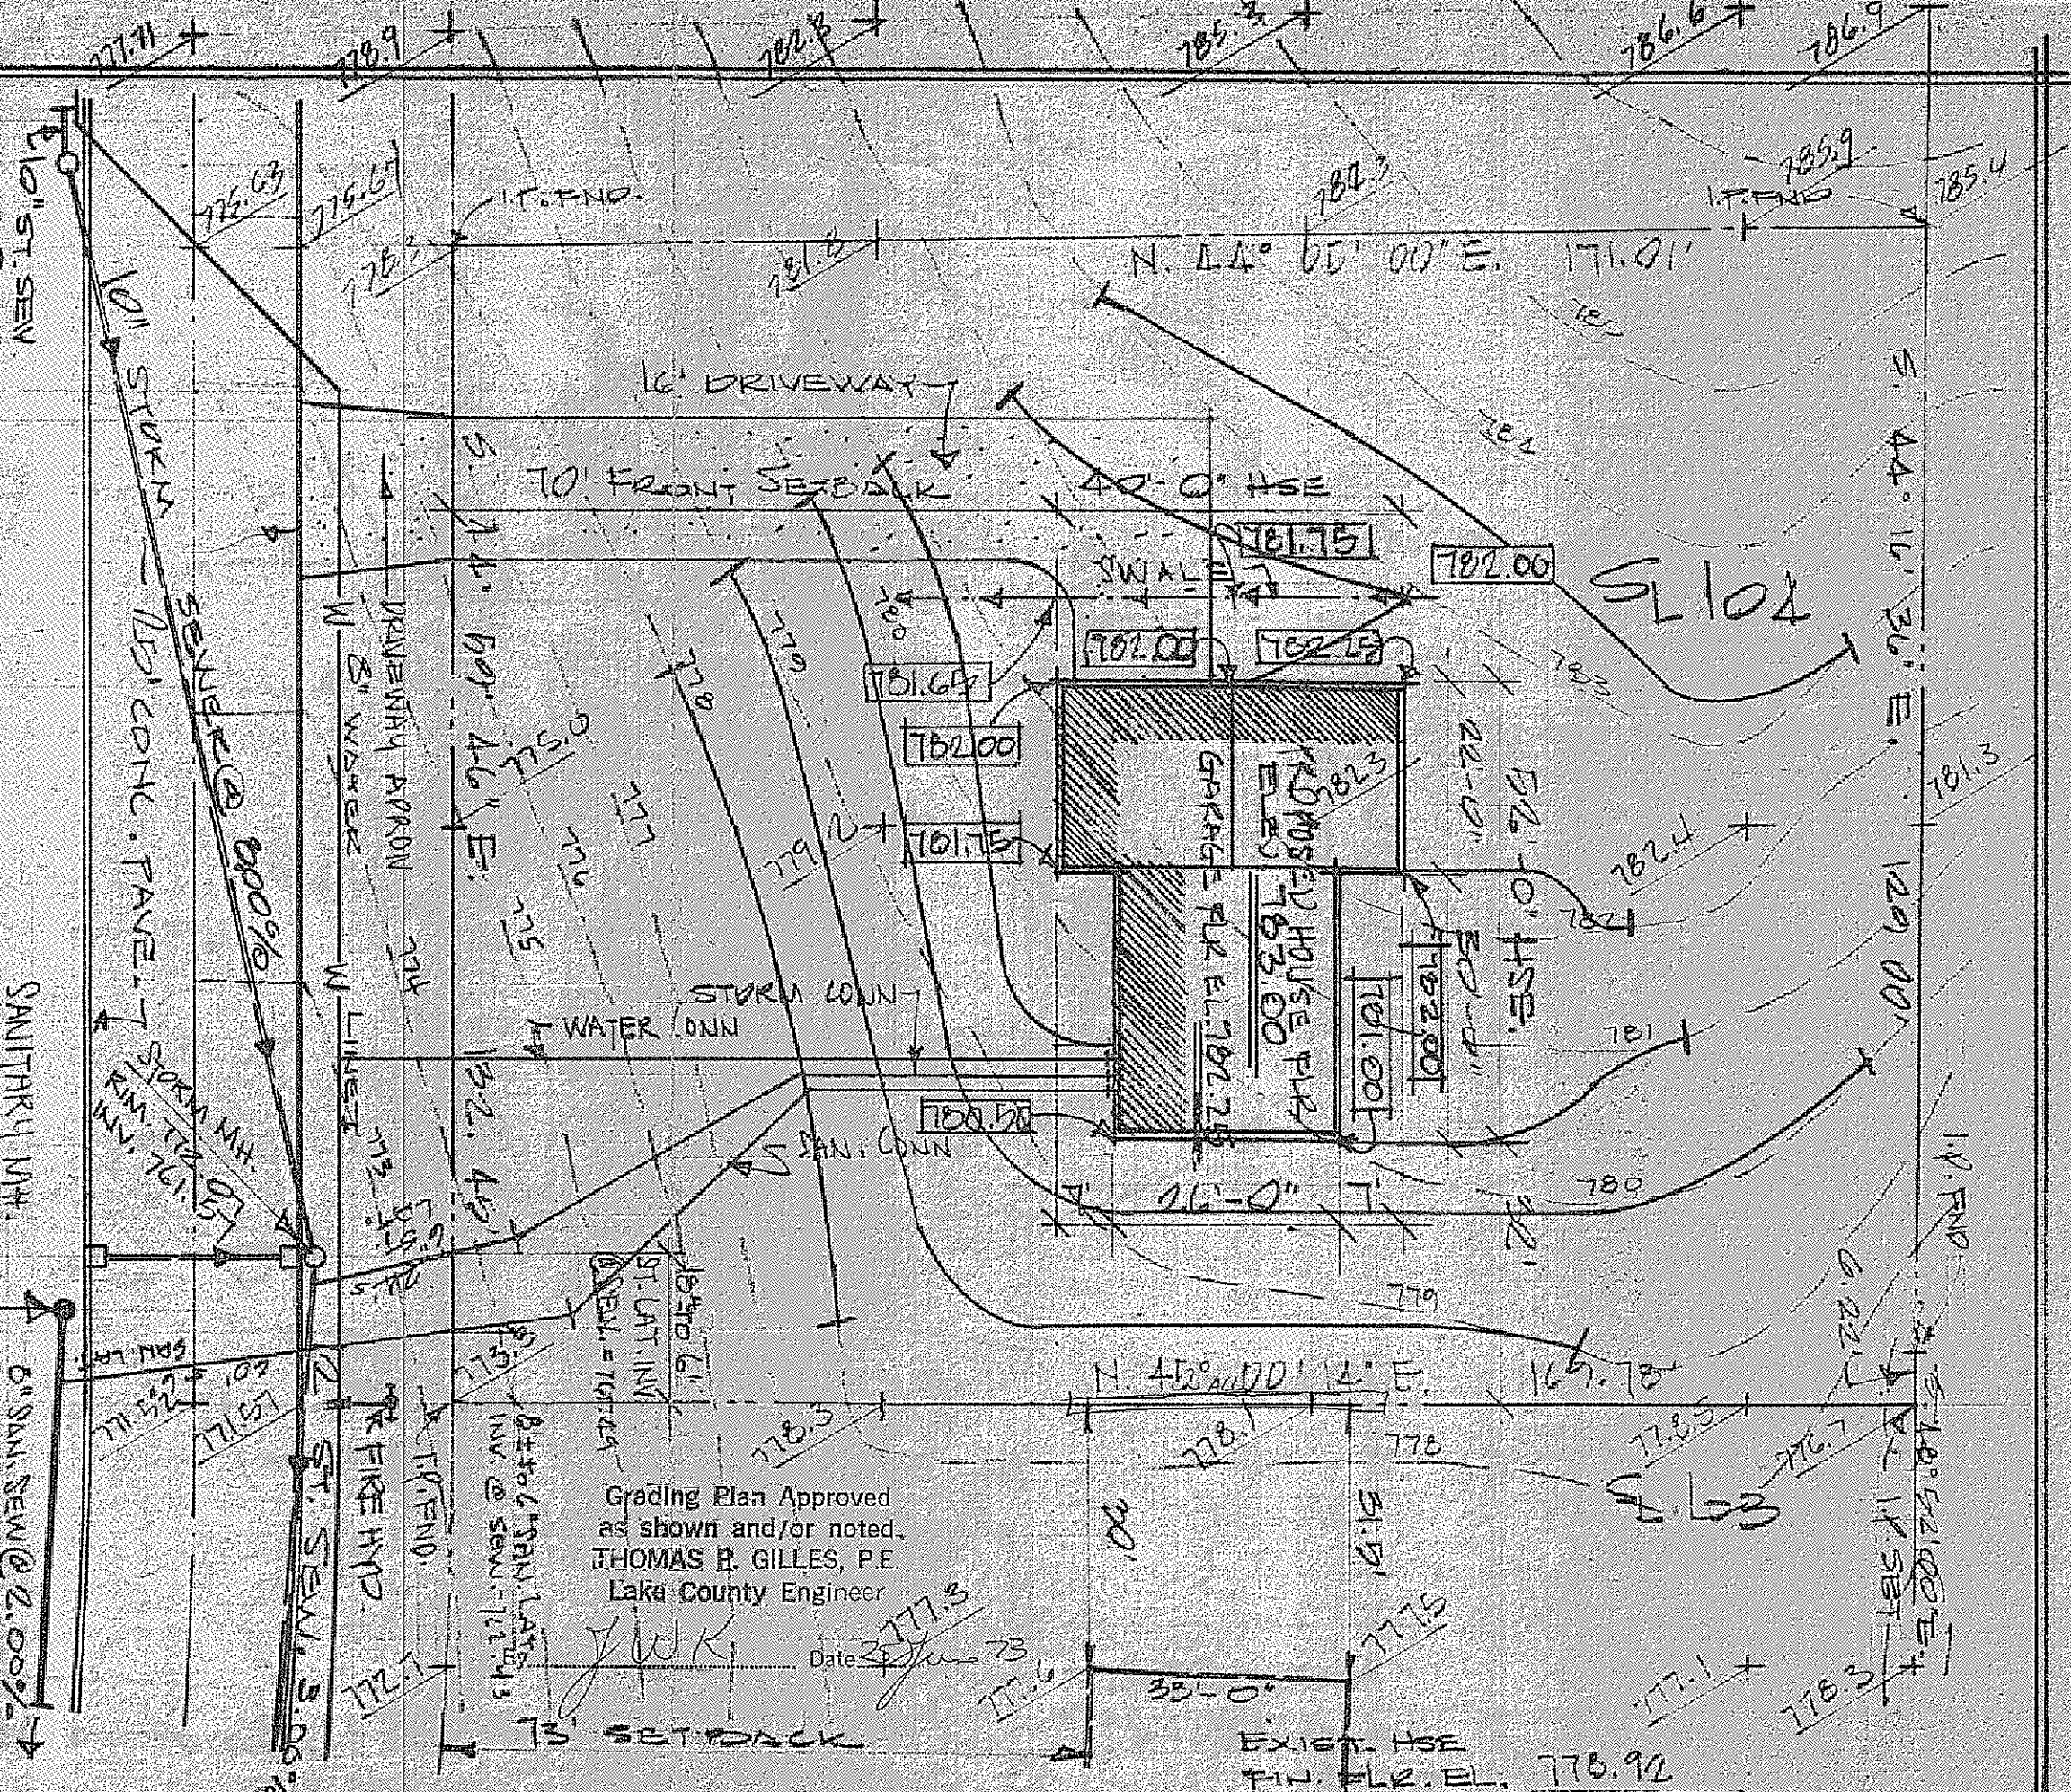

Grading Plan Approved
as shown and/or noted.
THOMAS E. GILLES, P.E.
Lake County Engineer

Date: 3/27/73

EXIST. HSE
FIN. FLR. EL. 778.92