


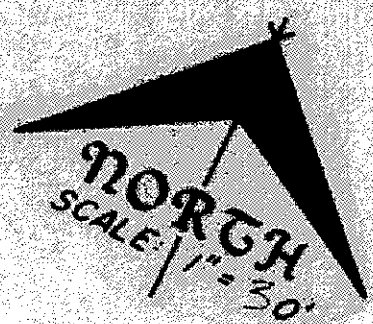

N. 63° 59' 40" E. 220.00'

S. 26° 00' 20" E. 110.00'

SUBLOT #105

10' UTILITY EASE

EXIST. HYDRANT

EXIST. DITCH

EXIST. ASPHALT PAVEMENT

EXIST. M.L.R.

EXIST. ASPHALT PAVEMENT

EXIST. ASPHALT PAVEMENT

Grading Plan Approved
as shown and/or noted
by THOMAS P. GILLES, P.E.
Lake County Engineer
Date 12-2-82

SITE PLAN

CONCRETE TOWNSHIP LAKE COUNTY, OHIO

for: **Ray Hedges** OWNER

CLIENT **South Meardon Dr. Concrete 44077**











WD 5883

2 only 4572

HOOSE ROAD 60'
S. 63° 59' 40" W.

SOUTH MEARDON DRIVE 60'
N. 26° 00' 20" W.

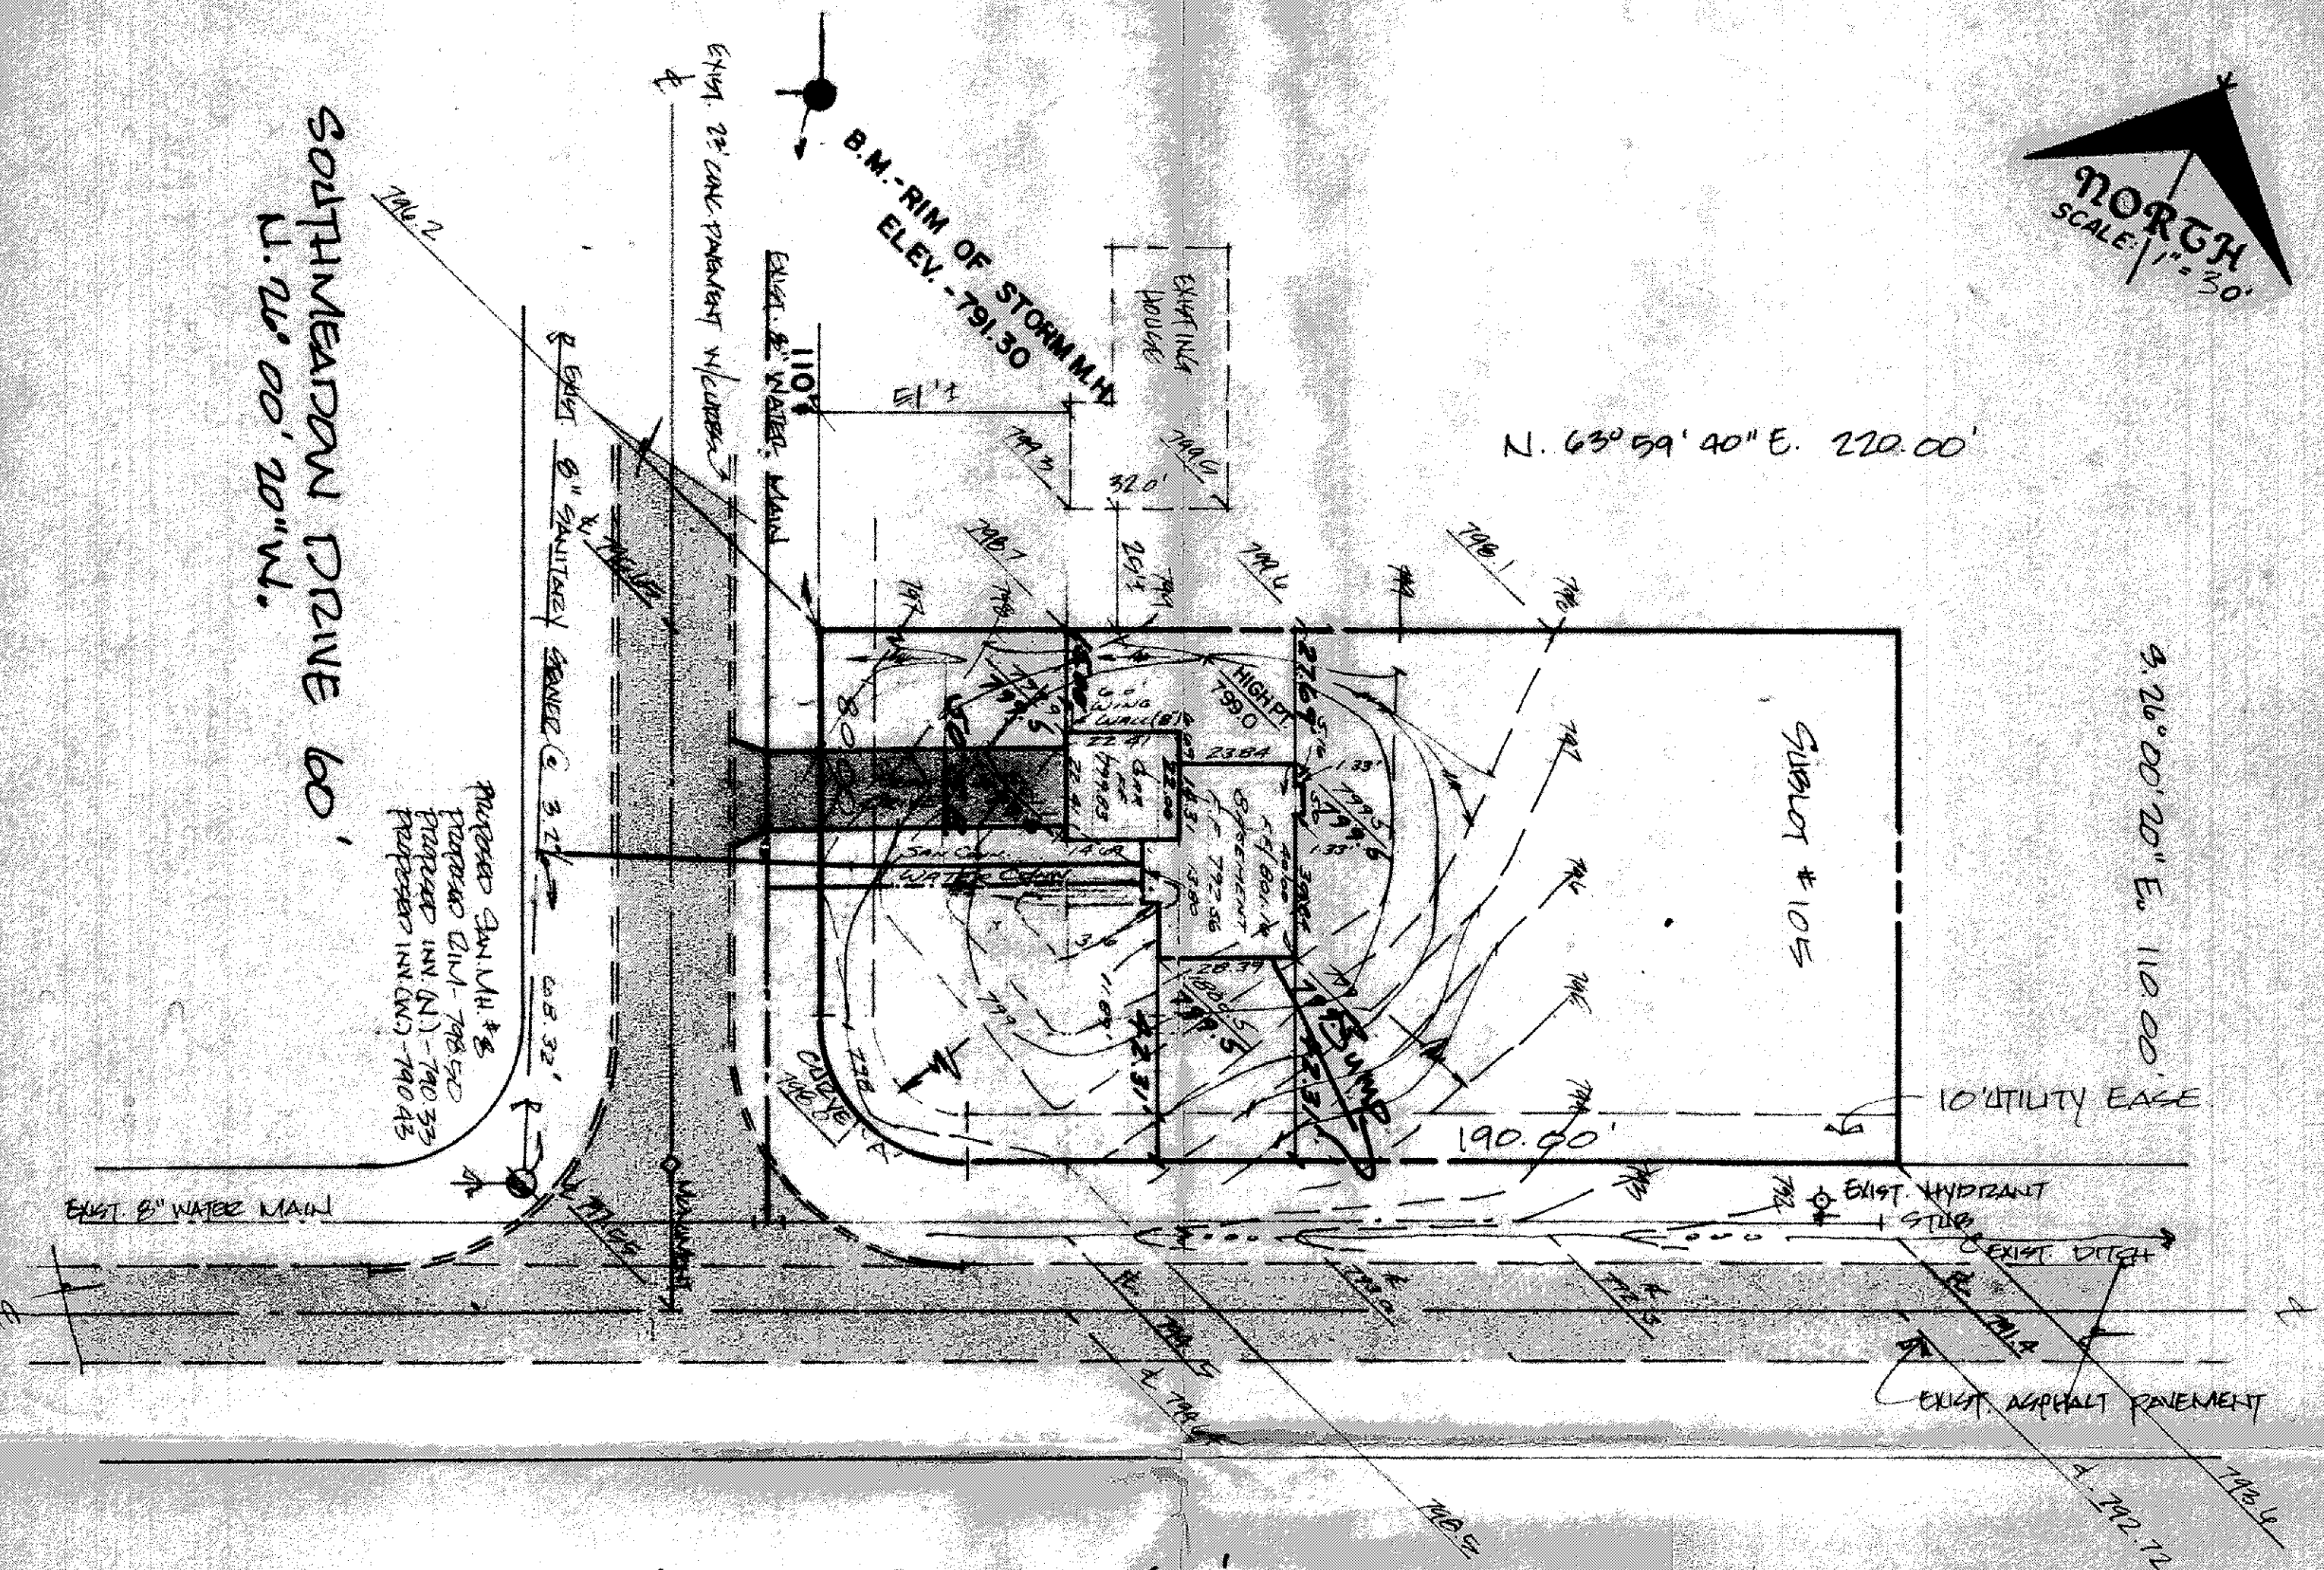

"AS BUILT" CERTIFICATION
I, HEREBY CERTIFY THAT THE CIRCLED GRADES ARE EXISTING
FINISH GRADES CHECKED IN THE FIELD ON 19
AND ARE CORRECT TO THE BEST OF MY KNOWLEDGE AND BELIEF.

REGISTERED SURVEYOR

REG NO

CURVE 'A'
ARC = 47.12'
Δ = 90° 00' 00"
RADIUS = 30.00'
CHORD = 42.43'
Δ = 71° 00' 20" W.

ZONING PERMIT #4572
ISSUED 12-2-82

SUBJECT TO APPROVAL BY:

Lake County Sanitary Eng. ☐

Lake County Eng. Dept. ☒

Lake County Planning Comm. ☐

Lake County Bldg. Dept. ☒

Don & Marlene

WD 5883

CHECK LIST

NO. OF BEDROOMS	WATER MAIN SIZE, LOCATION
1	SAN. SEWER SIZE, OR LOC.
2	SAN. IN. CAST. ELEV. INV. ELEV.
3	SAN. CONN. SIZE, LOC. DEPTH
4	STORM SEWER SIZE, OR LOC.
5	STORM IN. CAST ELEV. INV. ELEV.
6	BLDG. TYPE, GRADE CURBS
7	PAV'T TYPE, GRADE CURBS
8	PIPE TYPE, GRADE CURBS
9	PIPE TYPE, GRADE CURBS
PLAN PREPARED BY: DEBEVEC • SALO & ASSOCIATES, INC.

125 E. ERIE ST. PAINESVILLE, OHIO

DATE: 11/15/82 BY: L.L.

DATE: 12/1/82 BY: L.L.

DATE: 12/1/82 BY: L.L.

