



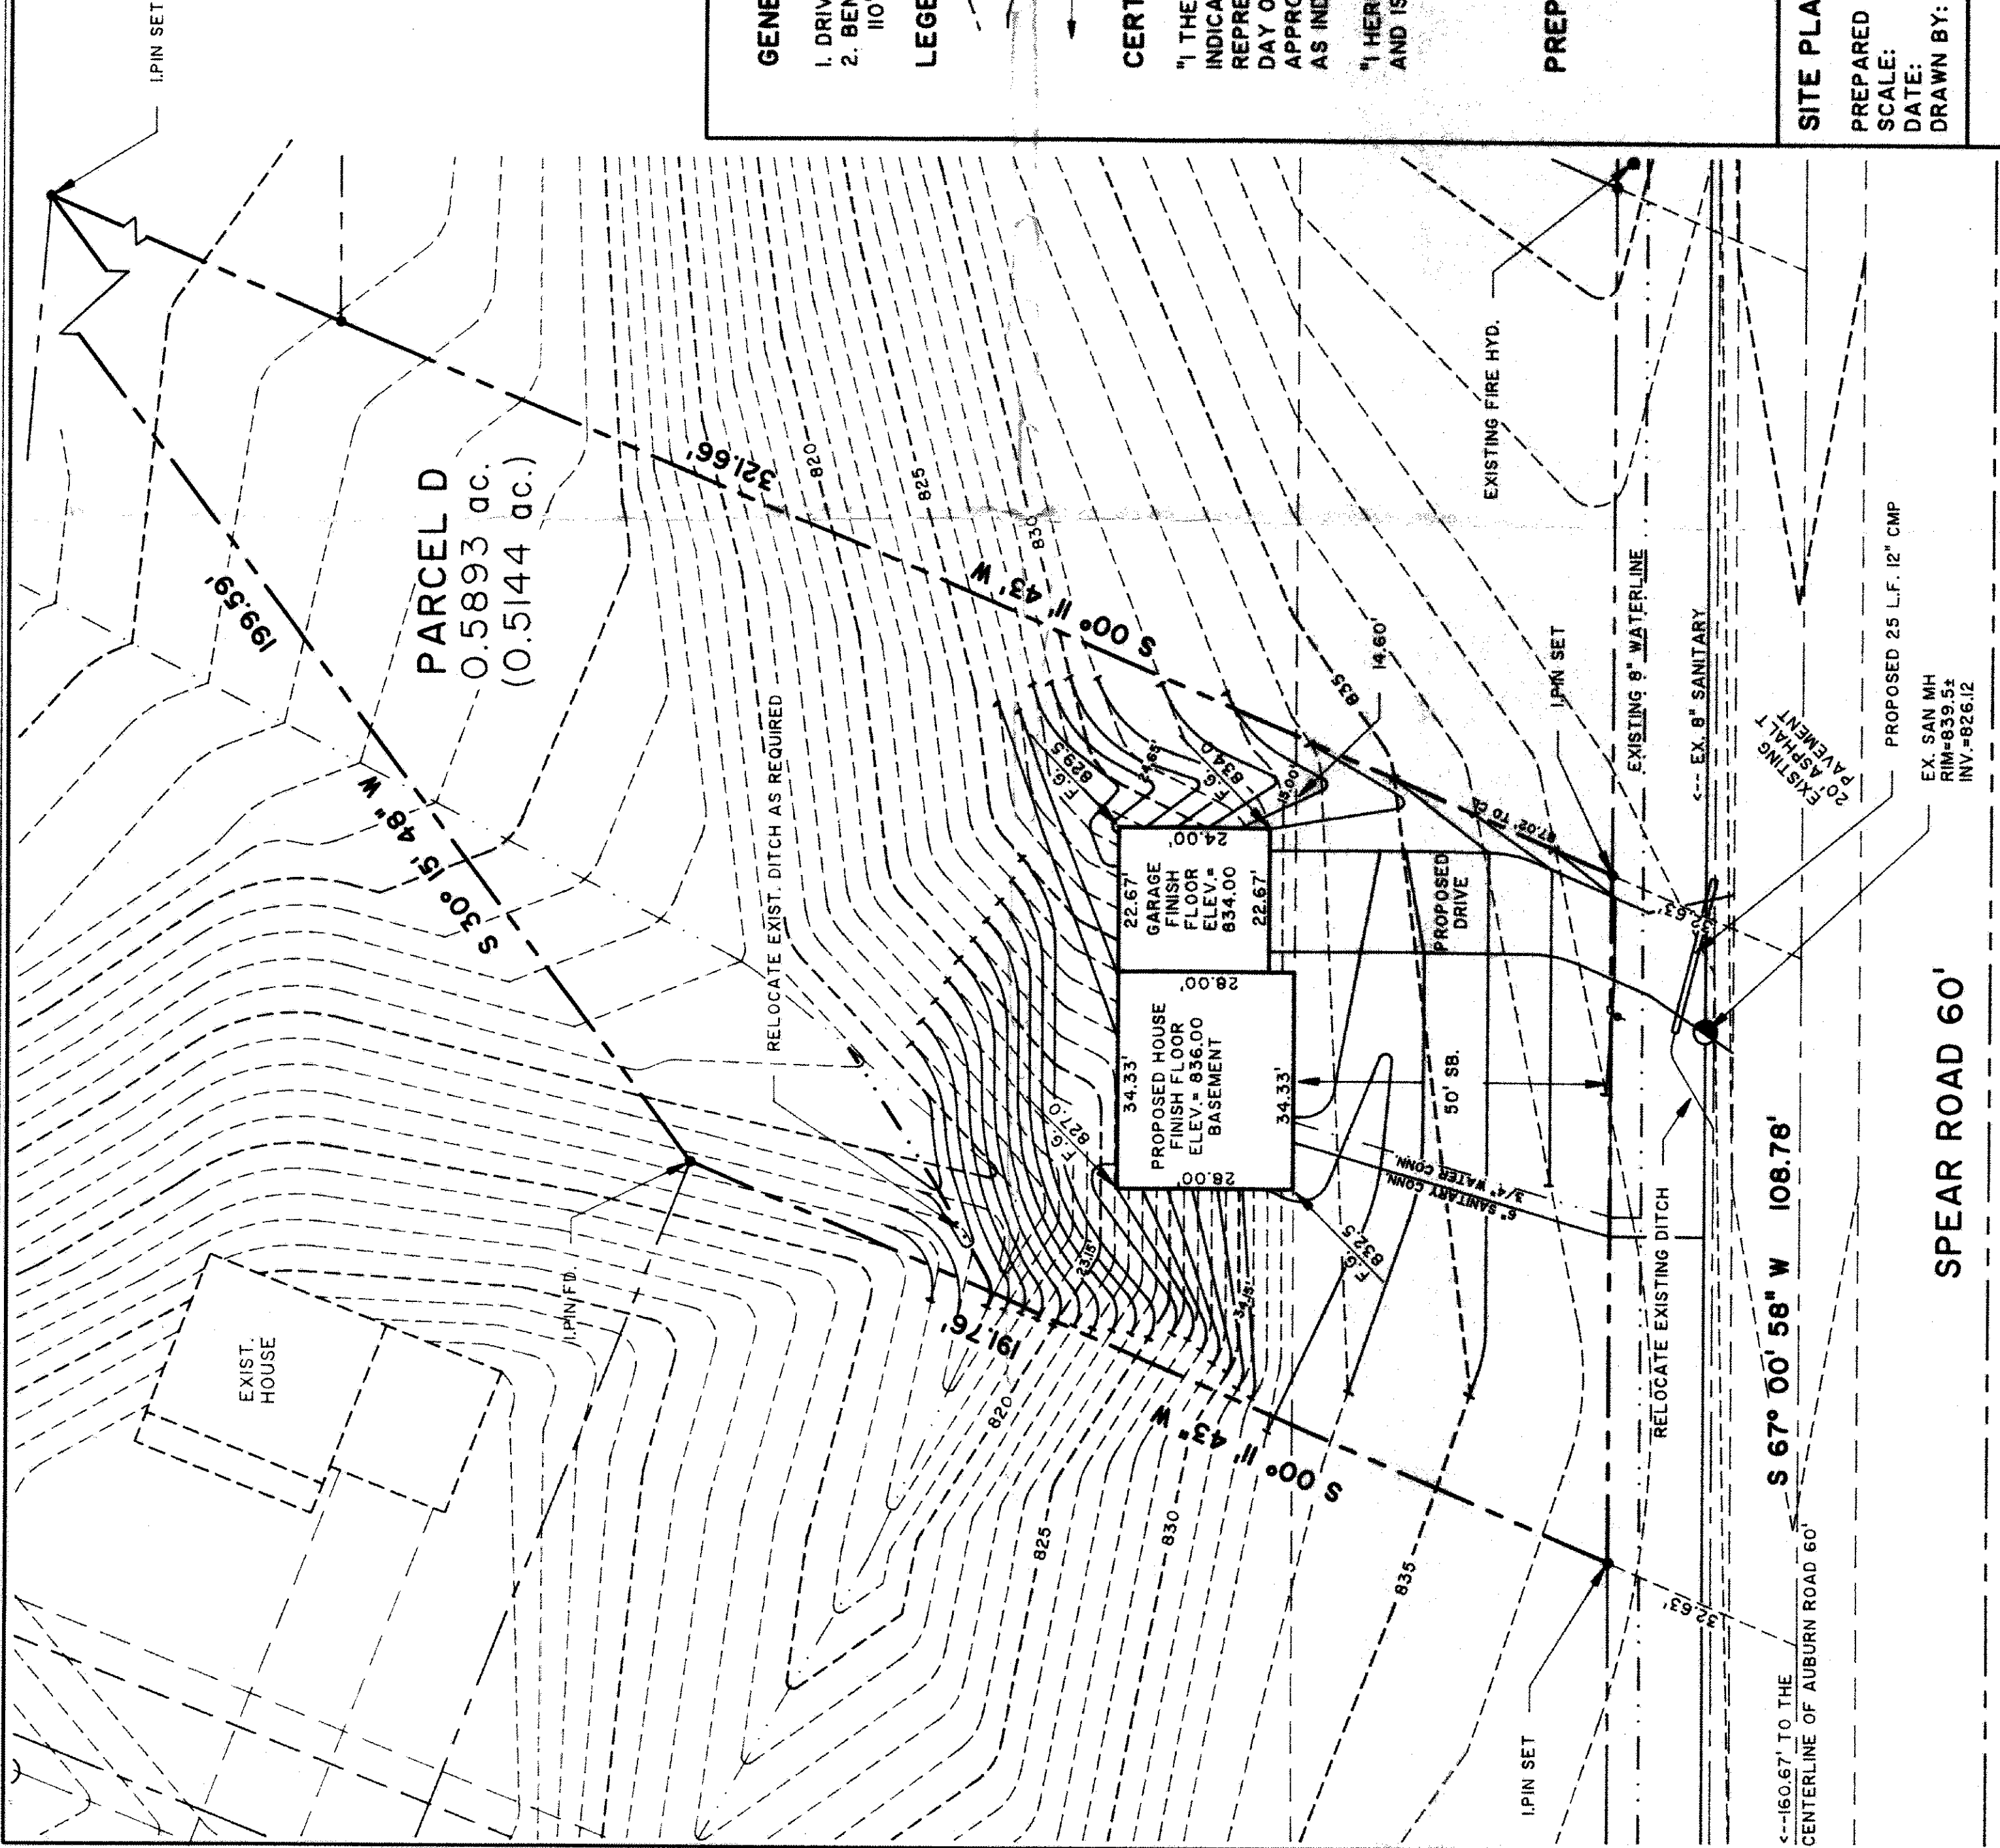

Grading Plan Approved
as shown and/or noted
by M.A.S. P. GILLES, P.E.
Lake County Engineer

By Q/H Date 7/27/92

RELOCATE ROADSIDE DITCH ALONG
ENTIRE FRONTAGE ALONG SPEAR

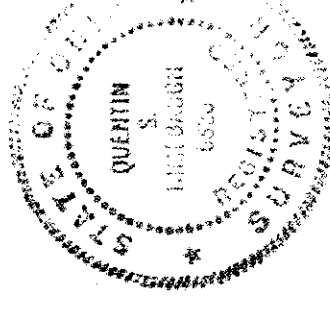

GENERAL NOTES:

1. DRIVEWAY APRON TO BE 6" THICK
2. BENCHMARK - TOP STEM OF FIRE HYDRANT LOCATED 110' WEST OF PARCEL "D", ELEV. =

LEGEND

- EXISTING CONTOUR
PROPOSED CONTOUR
EXISTING ELEVATION
PROPOSED ELEVATION

ZONING PERMIT 0792-7244

ISSUED 7-21-92

SUBJECT TO APPROVAL BY:

- Lake County Sanitary Eng. ☐
Lake County Eng. Dept. ☒
Lake County Planning Comm. ☐
Lake County Bldg. Dept. ☒

CERTIFICATION

"I THE UNDERSIGNED HEREBY CERTIFY THAT THIS TOPOGRAPHY INDICATED BY 1" CONTOURS AND ELEVATIONS SHOWN HEREON REPRESENTS AN ACTUAL SURVEY MADE BY ME ON THE 13th DAY OF NOV. 1991 AND THE ELEVATIONS WERE TAKEN AT APPROPRIATE INTERVALS AND AS OF THAT DAY THEY EXISTED AS INDICATED HEREON.

"I HEREBY CERTIFY THAT THIS PLAN WAS PREPARED BY ME AND IS CORRECT TO THE BEST OF MY KNOWLEDGE"

Quentin S. Himebaugh
QUENTIN S. HIMEBAUGH, P.S. No. 6820

PREPARED BY:

Himebaugh and Associates
Surveyors and Site Consultants
38083 West Spaulding St.
Willoughby, Ohio 44094
(216) 946-1761

SITE PLAN: 0.5893 ac. PARCEL LOCATED 160.67' FROM THE INTERSECTION OF AUBURN ROAD 60'

PREPARED FOR: LITTLE MOUNTAIN HOMES, INC.

SCALE: 1" = 20'

DATE: JUNE 25, 1992

DRAWN BY: DAVID W. NOVAK

SPEAR ROAD 60'

91-082-D