


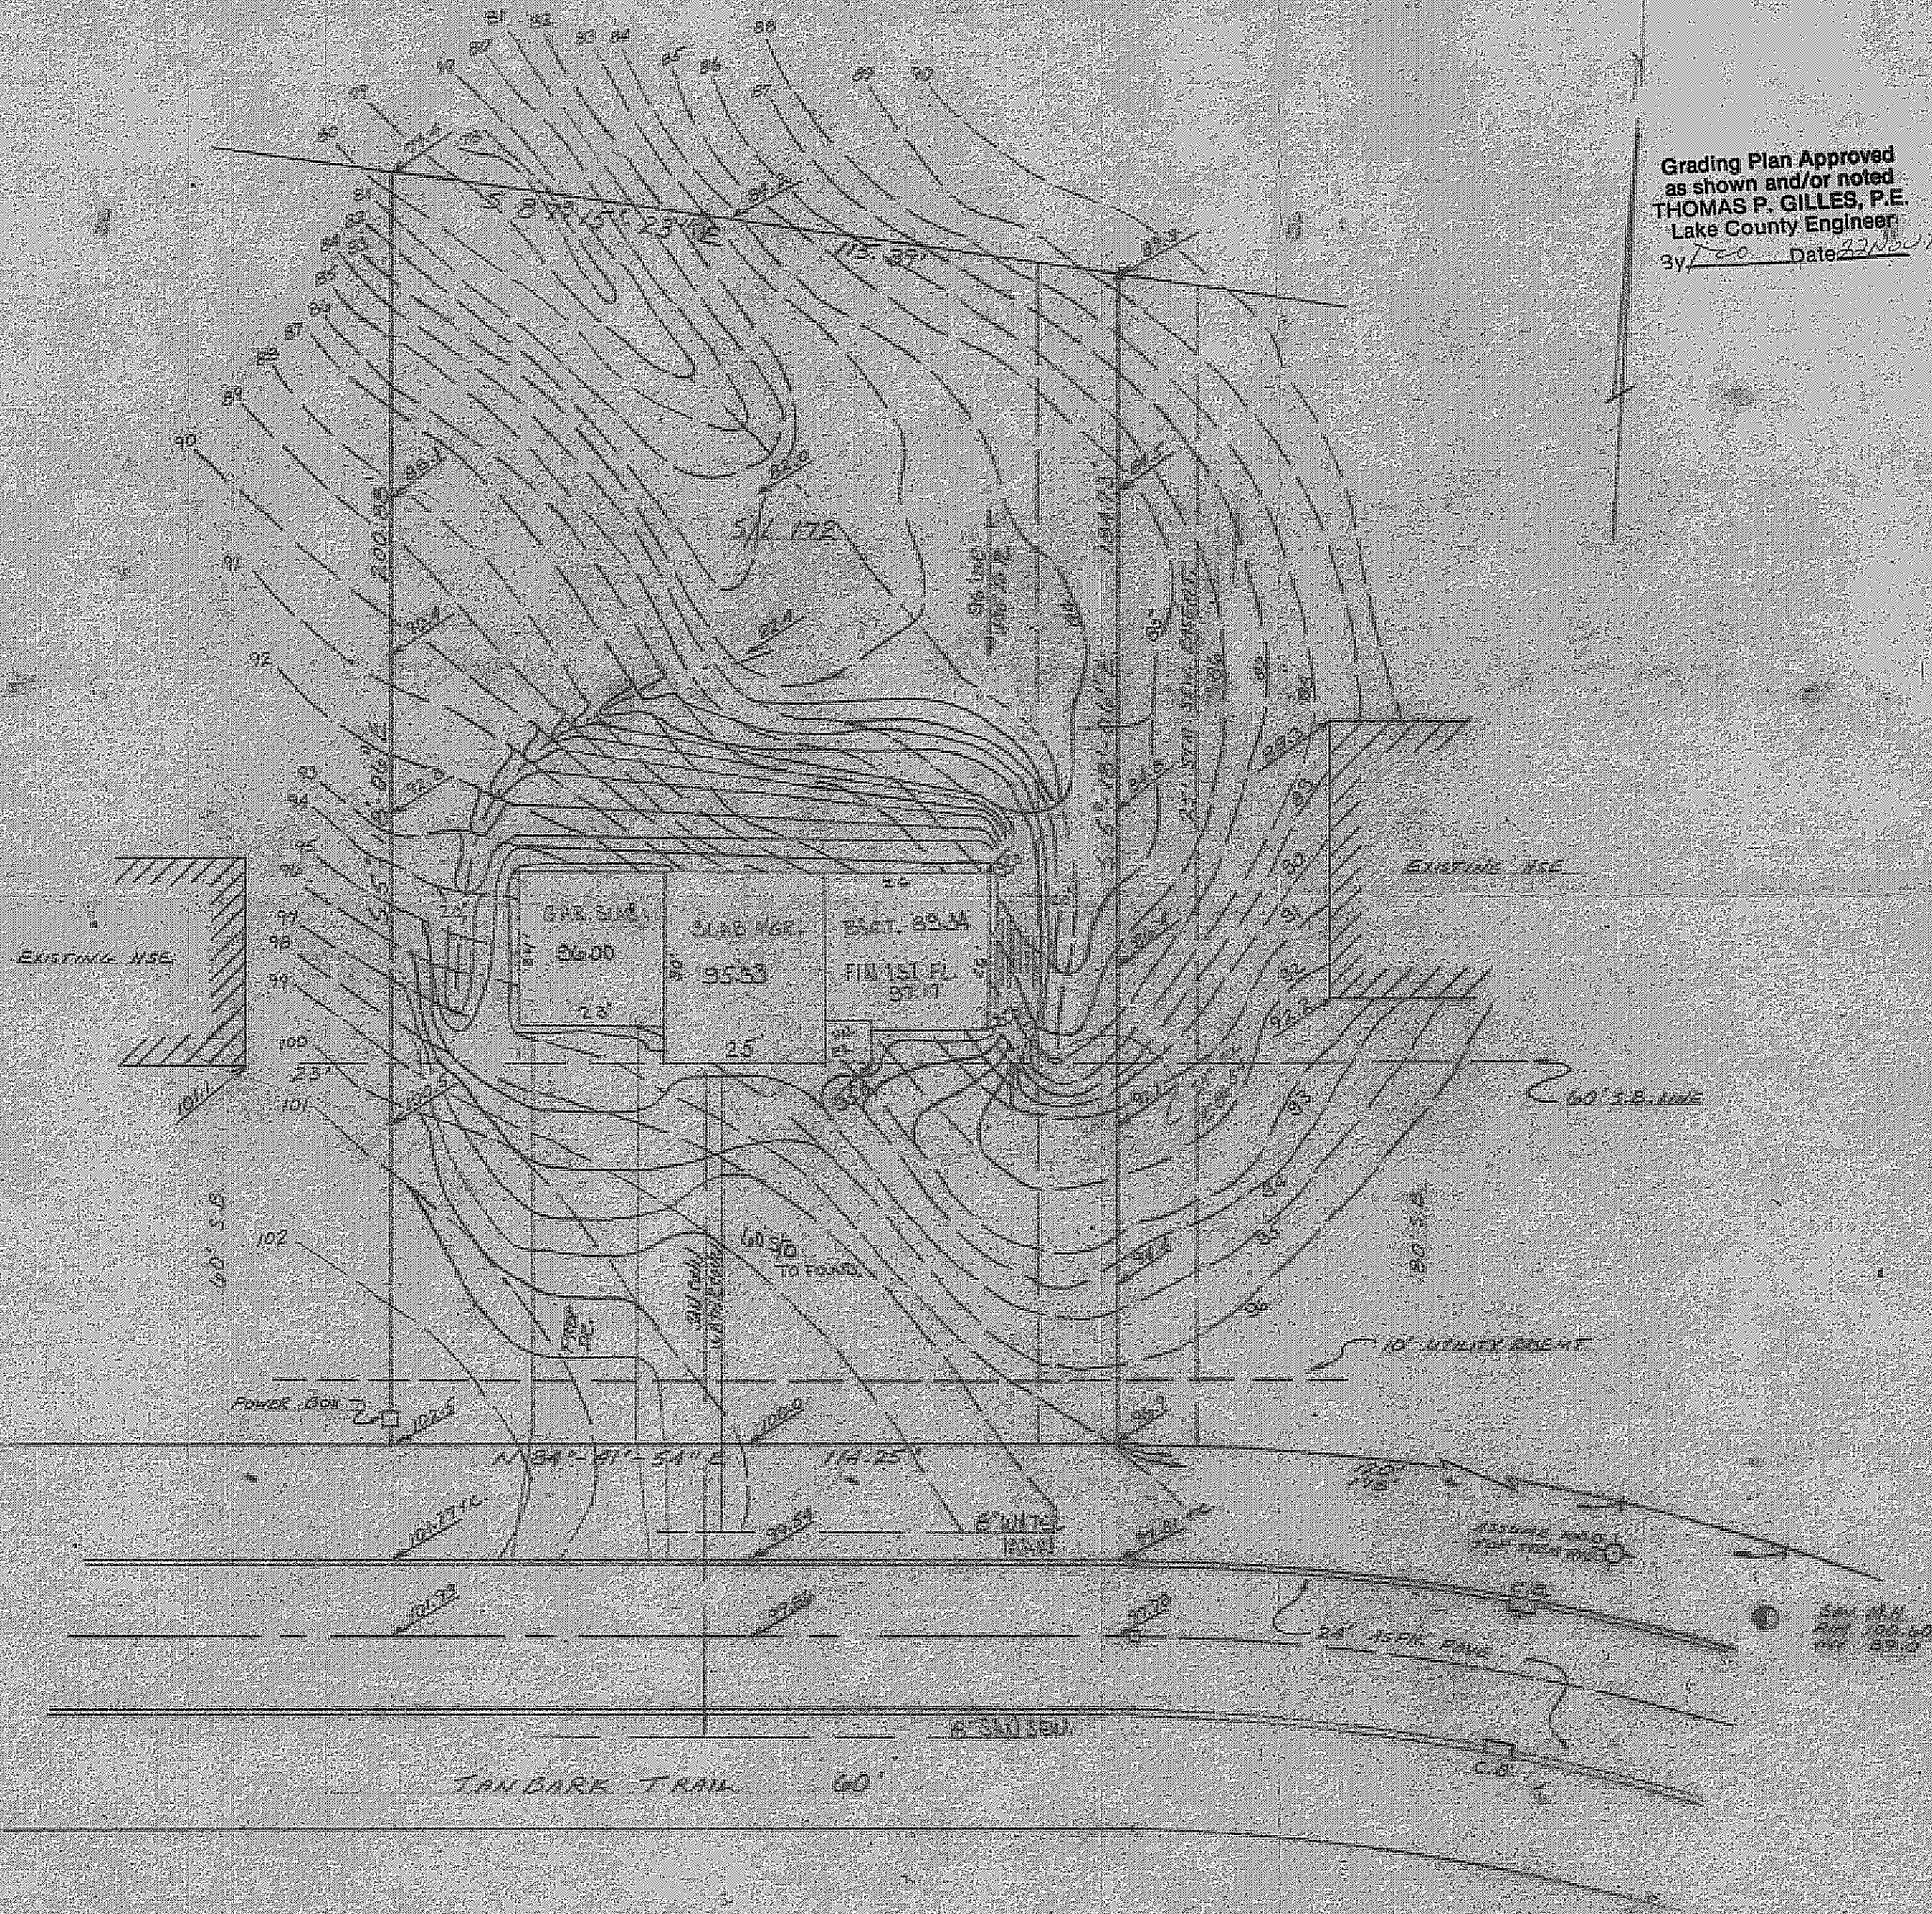

SITE PLAN			
CONCORD TOWNSHIP LAKE COUNTY, OHIO			
FOR: ROY SLAYTON		OWNER	
CLIENT	ADDRESS	STREET	CITY
MORLEY HILLS #3		LOT	TRACT
SUBDIVISION V-36 NAME		VOLUME	PAGE
172 VOL 30 TANBARK		PERM. PARCEL NO.	STREET
SUBLOT NO.		STREET	ZIP

LEGEND			
SANITARY MANHOLE	WATER VALVE (GAS)		
STORM MANHOLE	WATER METER (GAS)		
INLET OR CATCH BASIN	AS BUILT ELEVATION		
HYDRANT	INDICATES DIRECTION OF SURFACE DRAINAGE		
EXISTING CONTOURS			
PROPOSED CONTOURS			
EXIST. ELEV.	100.0	PROP. ELEV.	

REMARKS			
ALL BOUNDARY DATA SHOWN WAS OBTAINED FROM (DEEDS, RECORDED SUBDIVISION PLAT OR OTHER PUBLIC RECORDS)			
LOCATIONS AS SHOWN OF ADJACENT WELLS AND SEPTIC TANKS OBTAINED FROM LAKE COUNTY HEALTH DEPARTMENT.			

DESIGN CERTIFICATION			
THIS PLAT WAS PREPARED BY ME, AND IS CORRECT TO THE BEST OF MY KNOWLEDGE AND BELIEF.			
NAME	JOHN C. SKONECZNY	REGISTRATION NO.	S-6856

CHECK LIST			
NO. OF BEDROOMS	WATER MAIN SIZE, LOCATION		
DIMENSIONS	SAN. SEWER SIZE % GR. LOC.		
BEARINGS	SAN. MH. CAST ELEV. INV. ELEV.		
TIE TO NEAREST STREET	SAN. CONN. SIZE, LOC. DEPTH		
SUBLOT NO. PARCEL NO.	STORM SEWER SIZE % GR. LOC.		
SURROUNDING OWNERS	STORM MH. CAST ELEV. INV. ELEV.		
BLDG. DIMENSIONS, FIN. GR.	PAV'T TYPE GRADE CURBS		
BLDG. TIES FLR. GRADES	GAS LINE LOC. SIZE PRESSURE		
APRON TYPE WIDTH THICKNESS	SEPTIC TANK LOCATION & DUPLICATION		
SIDEWALK TYPE WIDTH THICKNESS	WELL LOCATION		
CULVERT TYPE DIA. LENGTH	ISOLATION RADIUS FROM WELL		
ROCK OUTCROPPINGS			
OVERHANGS			

REVISIONS			PLAN PREPARED BY:	
NO.	DATE	BY	JOHN C. SKONECZNY	
1			REG. SURVEYOR	
2				
3			DRAWN BY	SCALE 1"=20'
4			CHK'D	DATE 11-17-77
5			CREW CHIEF	APP'D.

"AS BUILT" CERTIFICATION	
I, HEREBY CERTIFY THAT THE CIRCLED GRADES AND EXISTING FINISH GRADES CHECKED IN FIELD ON 19 BY AND ARE CORRECT TO THE BEST OF MY KNOWLEDGE AND BELIEF.	
REGISTERED SURVEYOR	REG. NO.

3488

ZONING PERMIT

APPROVED 11-16-77

SE van Dusen