

Grading Plan Approved
as shown and/or noted
by THOMAS P. GILLES, P.E.
Lake County Engineer
Date 1-13-93
241 MIN. DRIVEWAY
APPROX

Lower W. & Majest. Wastcell
V 757-1019 847-92

- A. To be brought to finished grade
1. Septic tank manhole covers
2. Splitter box cover
3. Distribution box cover
- B. No footer drains or downspouts
- C. To be discharged into septic tanks
- D. To be discharged into septic tanks

SEWER DISPOSAL PERMIT MUST BE
OBTAINED BY A LAKE COUNTY LICENSED
INSTALLER BEFORE INSTALLATION IS
STARTED.

Noted and Assumed
LAKE COUNTY GENERAL HEALTH DEPARTMENT
Date 1-13-93
JOEL LUCKA, E.S., P.E.
Health Commissioner
JL 1037 JLV

LOW YIELD WATER
FITTINGS REQUIRED
ON ALL:
Shower Head
Toilet

SCALE 1" = 20'

ZONING PERMIT #093-7366
ISSUED 1-14-93
SUBJECT TO APPROVAL BY:
Lake County Sanitary Eng. ☐
Lake County Eng. Dept. ☒
Lake County Planning Comm. ☐
Lake County Bldg. Dept. ☐

SITE PLAN

CONCEDED LAKE COUNTY, OHIO

FOR: Pat. Final CLIENT OWNER

ADDRESS STREET CITY ZIP

CONCEDED LAKE COUNTY, OHIO

SUBDIVISION SHEET NO. 15 DATE 12-12-92 TRACT


VOLUME 25 PAGE 1 WILLIAMS RD. STREET

PERMANENT PARCEL NO.

CERTIFICATION

THIS PLAN WAS PREPARED BY ME,
AND IS CORRECT TO THE BEST OF
MY KNOWLEDGE.

JESSIE A. GREENE P. E. 6462
NAME REGISTRATION NO.

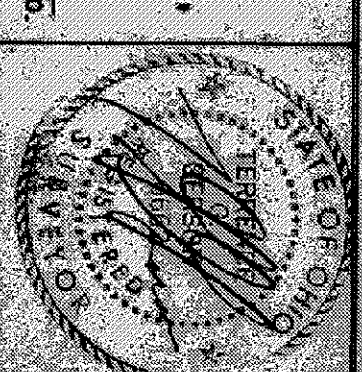

LEGEND

- SANITARY MANHOLE --- WATER VALVE (B&S)
- STORM MANHOLE --- WATER METER (B&S)
- INLET OR CATCH BASIN --- AS BUILT ELEVATION
- HYDRANT ---
- EXISTING CONTOURS ---
- PROPOSED CONTOURS ---
- EXIST. ELEV. --- 100.00 --- PROP. ELEV.
- INDICATES DIRECTION OF SURFACE DRAINAGE


"AS BUILT" CERTIFICATION

I, HEREBY CERTIFY THAT THE CIRCLED GRADES ARE
EXISTING FINISHED GRADES CHECKED IN THE FIELD ON
1-9-93 AND ARE CORRECT TO THE
BEST OF MY KNOWLEDGE.

NAME REGISTRATION NO.

PLAN PREPARED BY
WM. R. GRAY ASSOCIATES, INC.

REVISIONS	DATE	BY	DATE	BY
1	1-13-93	JLV	1-13-93	JLV

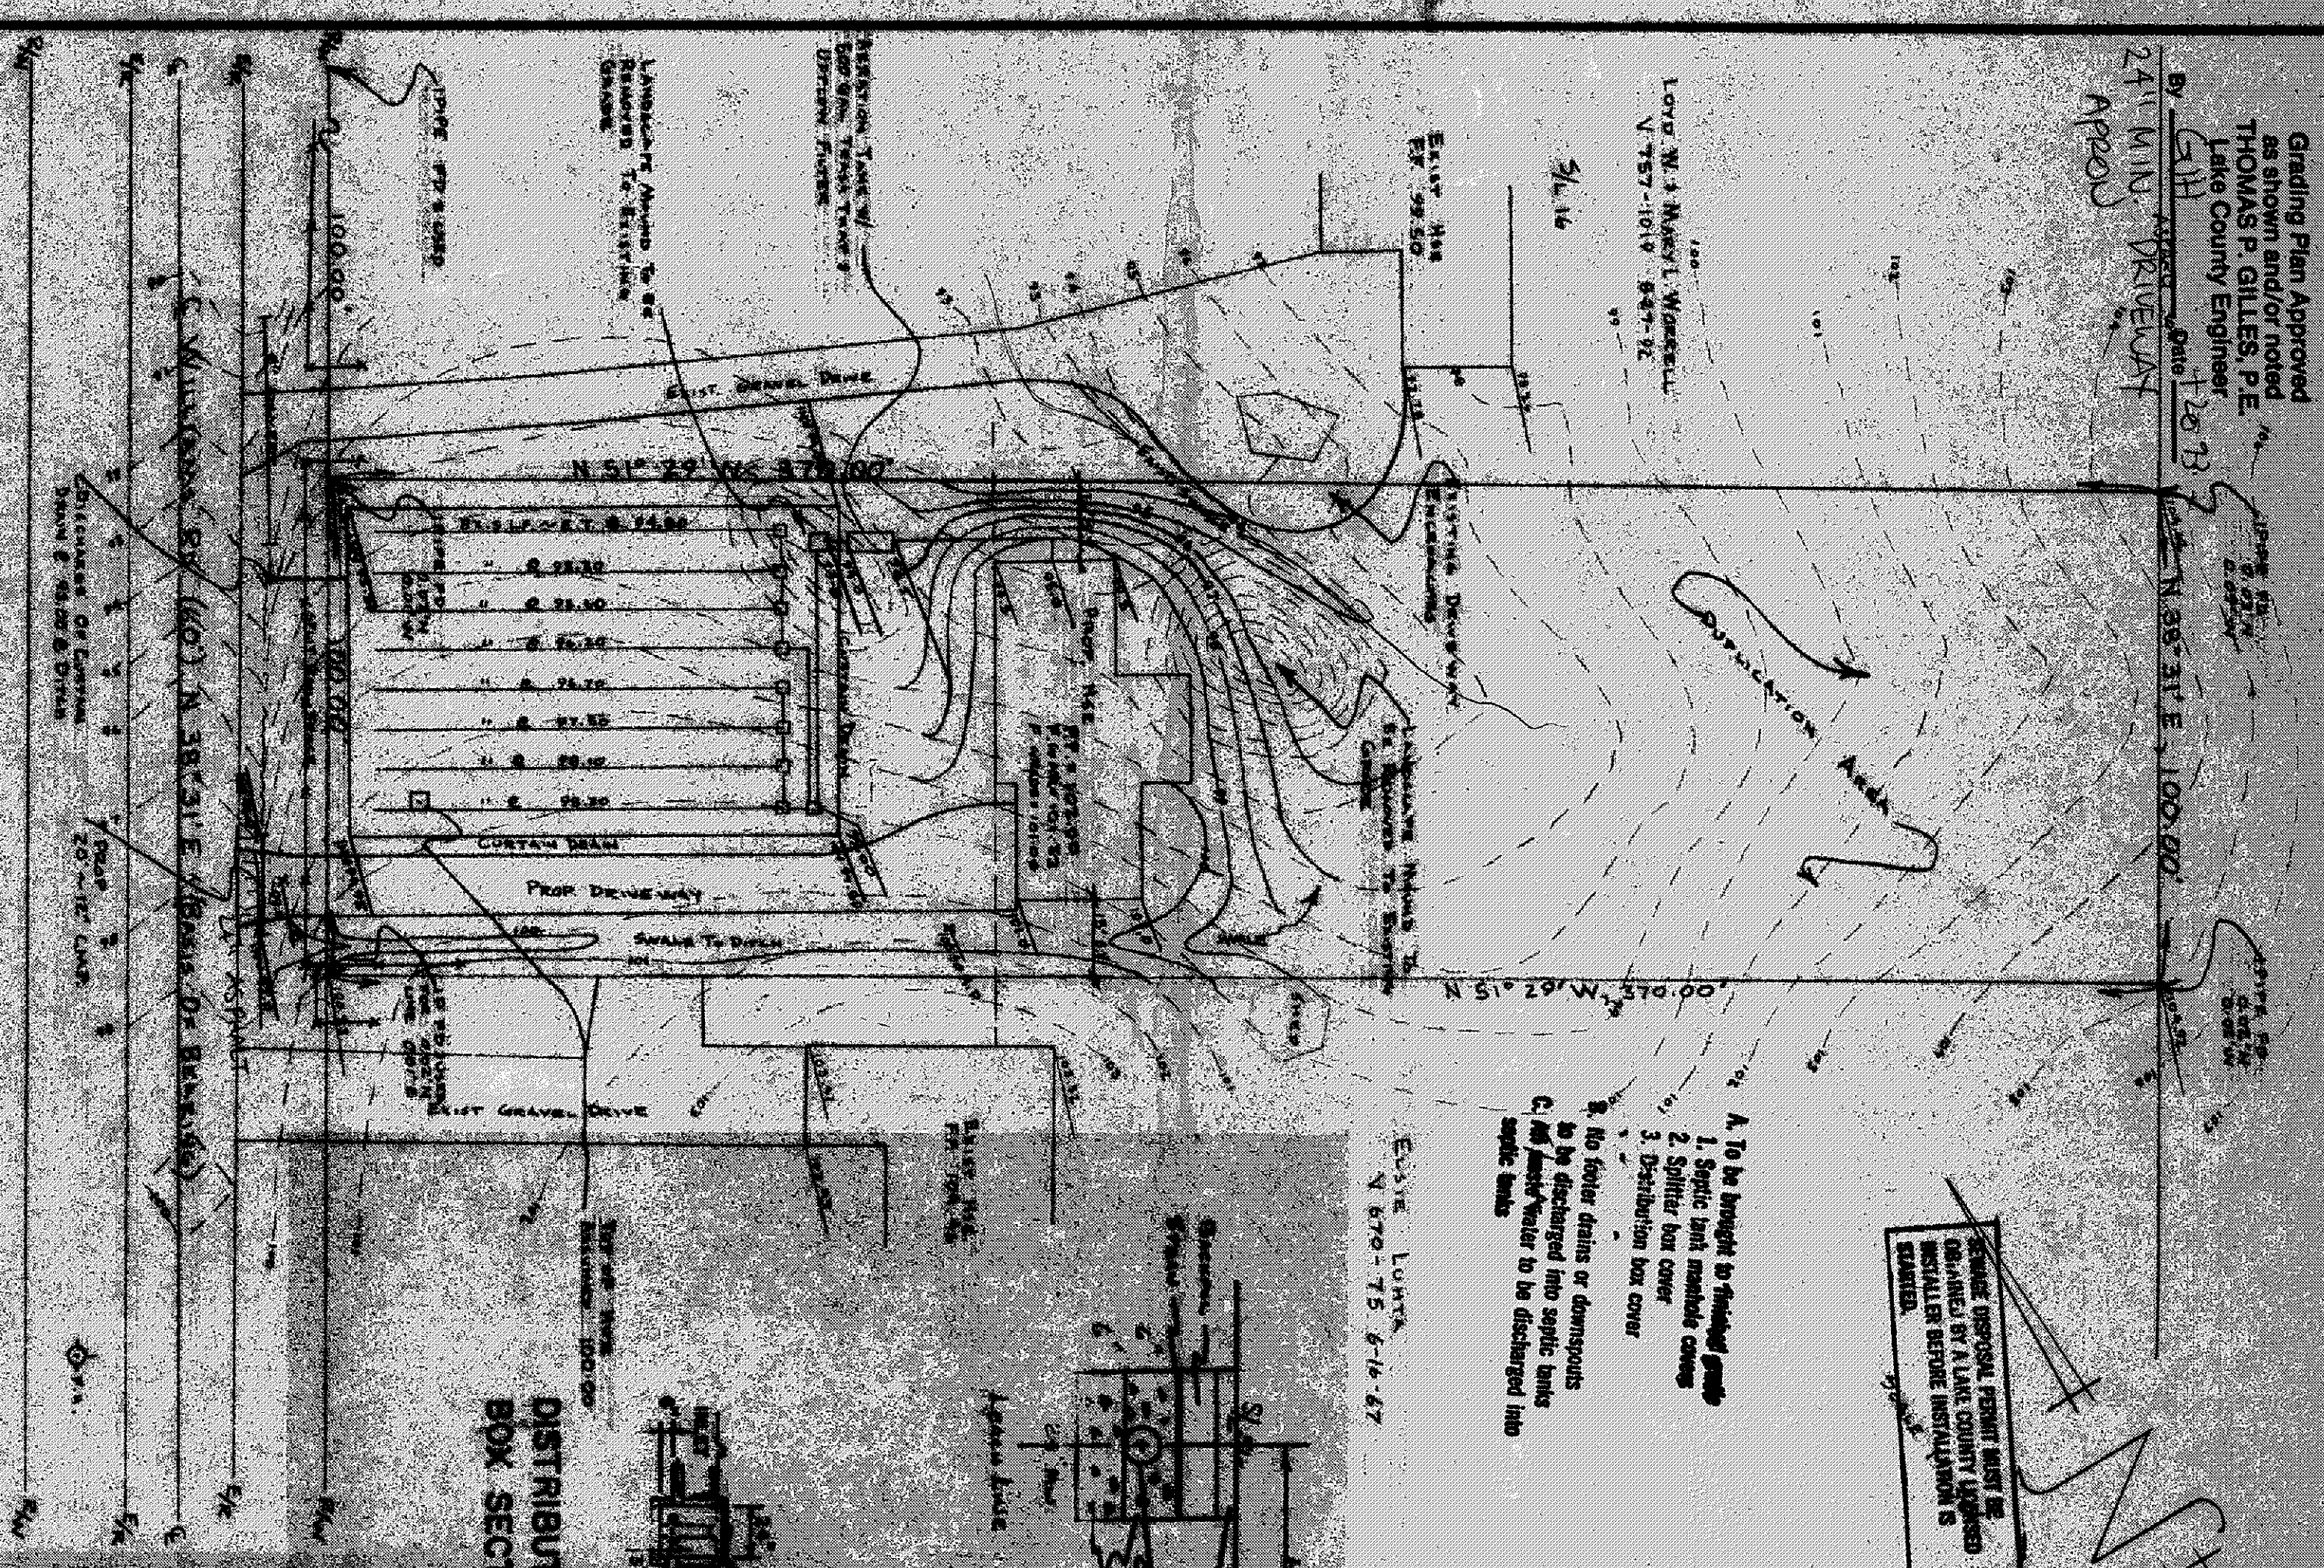

DISTRIBUTION
BOX SECTION

SPLITTER
BOX SECTION

1. The undersigned hereby certifies that
the topographic and elevation represents
an actual field topographic survey made by
me on the 18th day of December, 1992 and
that the elevations were taken at appropriate
intervals and that as of that date they
reflected as indicated herein.

Registered Surveyor

Reg. No.