


JOHN C. SKONIECZNY
7739 VIEWMOUNT DR.
PAINESVILLE, OHIO 44071
PH. 352-7742



I CERTIFY THAT THIS PLAN
WAS PREPARED BY ME AND
IS CORRECT TO THE BEST OF
MY KNOWLEDGE AND BELIEF

Grading Plan Approved
as shown and/or noted
THOMAS P. GILLESPIE, P.E.
Lake County Engineer
By Date
By Date

SITE PLAN FOR:
IDEAL AMERICAN HOMES, INC.
SCALE: 1" = 20'
DATE: SEPT 92
APPROVED BY: [Signature]
JOB # 92-1526
DRAWING NUMBER 92-1079

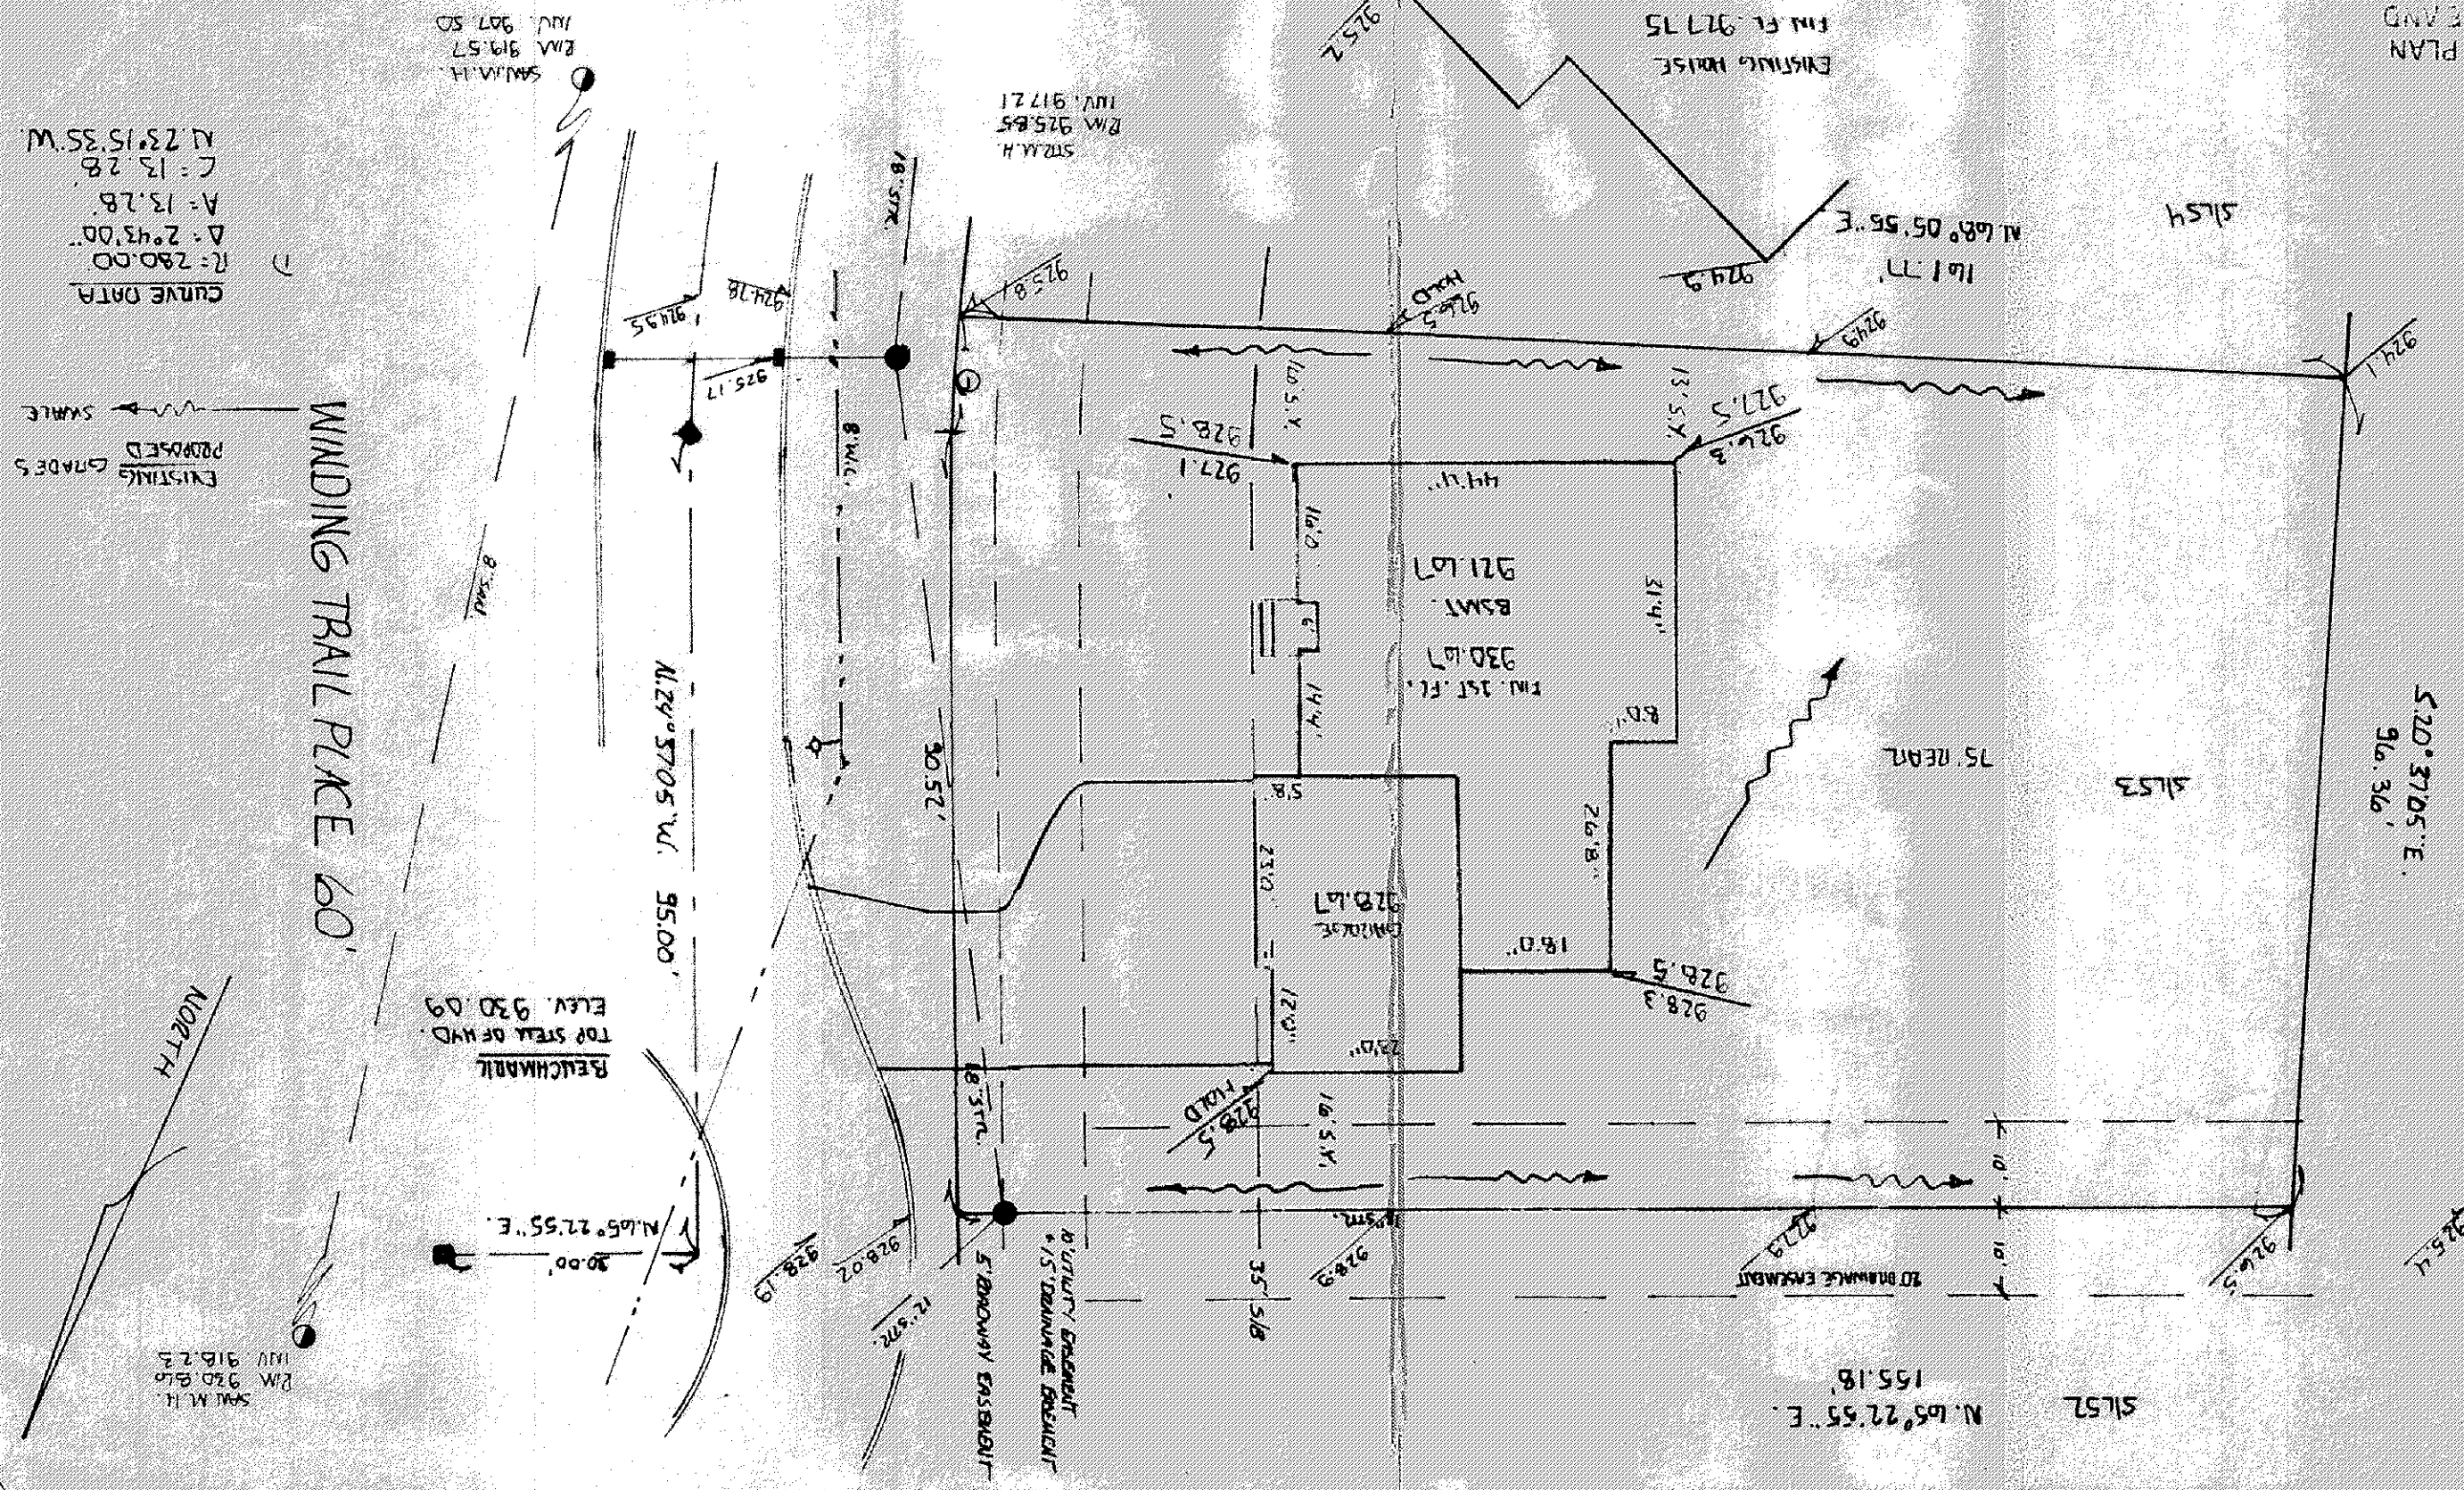

CURVE DATA
R = 280.00
Δ = 2°43'00"
A = 13.28'
C = 13.28'
N 23°15'35" W

WINDING TRAIL PLACE 60'
EXISTING GRADES
PROPOSED GRADES
SWALE

NORTH
