
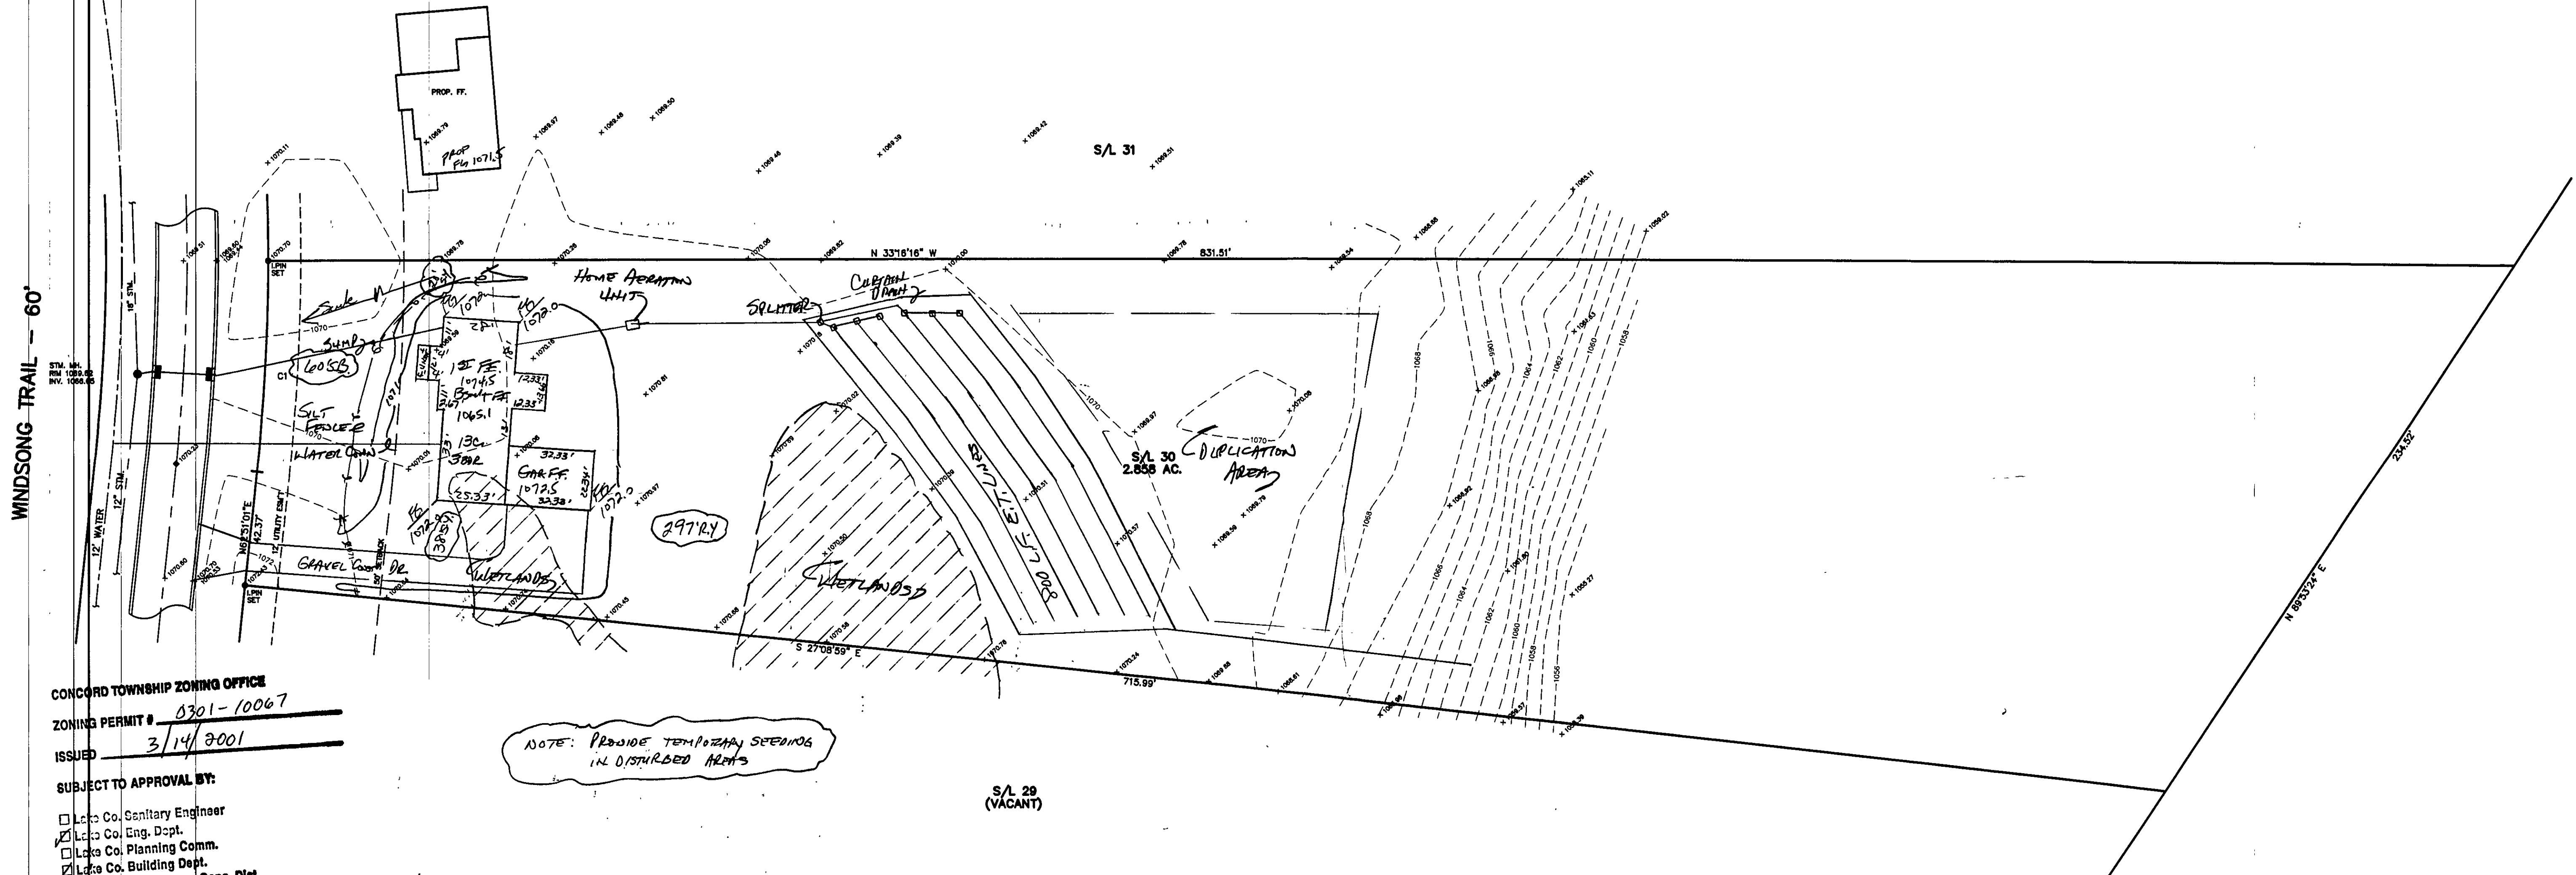
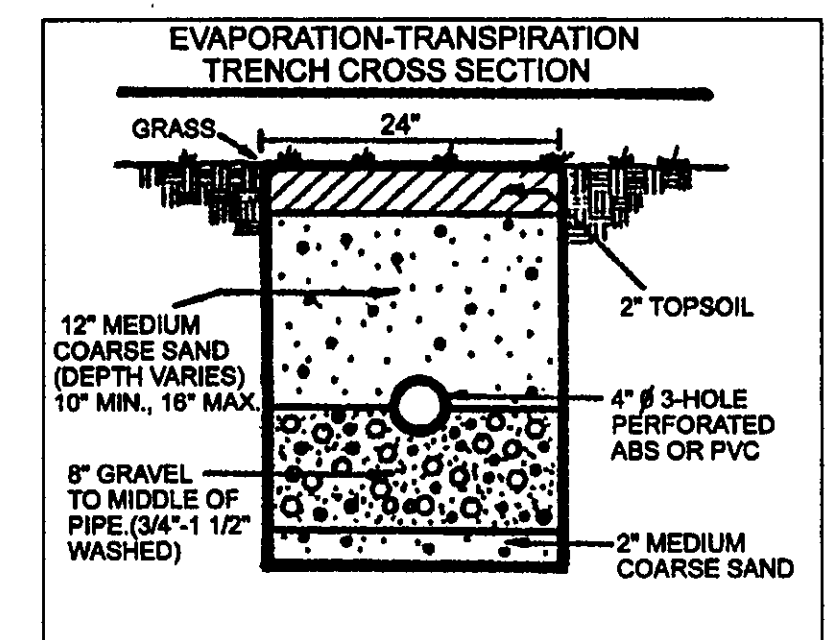


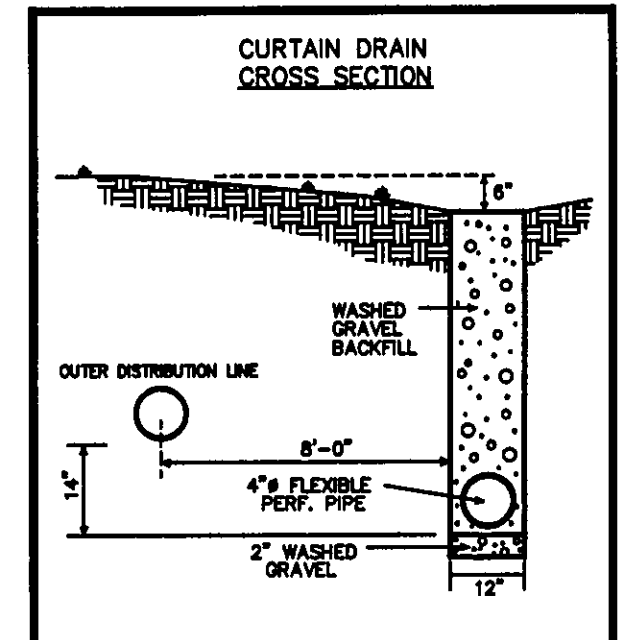


CONCORD TOWNSHIP ZONING OFFICE
ZONING PERMIT # 0301-10067
ISSUED 3/14/2001

- SUBJECT TO APPROVAL BY:
- ☐ Lake Co. Sanitary Engineer
 - ☒ Lake Co. Eng. Dept.
 - ☐ Lake Co. Planning Comm.
 - ☒ Lake Co. Building Dept.
 - ☒ Lake Co. Soil & Water Cons. Dist.

NOTE: PROVIDE TEMPORARY SEEDING IN DISTURBED AREAS

REVIEWED AND ACCEPTED
LAKE COUNTY GENERAL
HEALTH DISTRICT
Date 2-21-01 BY [Signature]

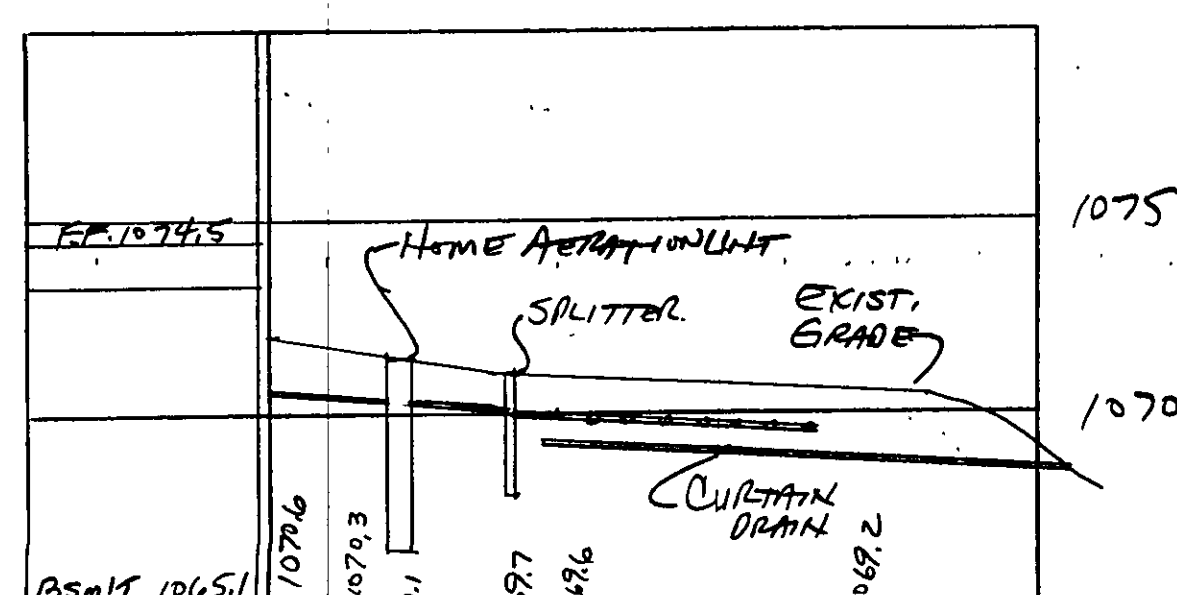

HYDRAULIC PROFILE
HORIZ: 1"=30' VERT: 1"=5'

NOTE: TEMPORARY SEEDING REQUIRED IN DISTURBED AREAS.


"I, the undersigned hereby certify that this topography indicated by 6", 1", or 2" contours, and elevations shown hereon represent an actual field survey made by me on the 23rd day of Jan. 2001 and that the elevations were taken at appropriate intervals and that as of that date they existed as indicated hereon."

Harry Jones #6343
Name Reg. No.

C1: R=730.00'
L=77.99'
T=39.03'
D=06°07'17"
C=77.95'
N59°47'22"E

BM-NAIL IN TREE S/L 30
ELEV.=1072.41

Grading Plan Approved
as shown and/or noted
JAMES R. GILLS, P.E.
Lake County Engineer
By T.A.M. Date 3-16-01
1. Scale as shown
2. WETLAND DISTURBANCE SHALL BE Approved by L.C.S.W.C.D.
3. ROOF DRAINS SHALL DISCHARGE TO SPLASH BLOCKS.

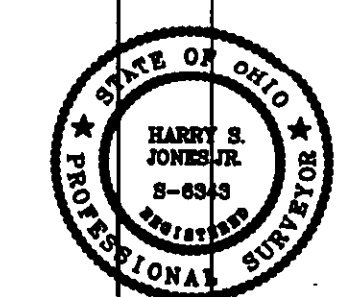

REV. NO.	DESCRIPTION	DATE	BY	CHK'D
1	REVISED SEPTIC TO OPERATION	2/12/01	HT	HT
2	ADDED WETLANDS, REVISED SEPTIC	2/14/01	HT	HT

babcock BABCOCK, JONES AND ASSOCIATES, INC
CIVIL ENGINEERS - SURVEYORS - LAND PLANNERS
PAINESVILLE OHIO 44077

DATE	1/24/01
DESIGN BY	H.J.
DRAWN BY	T.R.
APPROVED BY	H.J.

SITE PLAN
FOR
SHAMROCK CONSTRUCTION
S/L 30 STANFORD SPRINGS SUB.
CONCORD TOWNSHIP LAKE COUNTY

SCALE	1"=30'
JOB NO.	98-185-30
SHEET	1 OF 1