

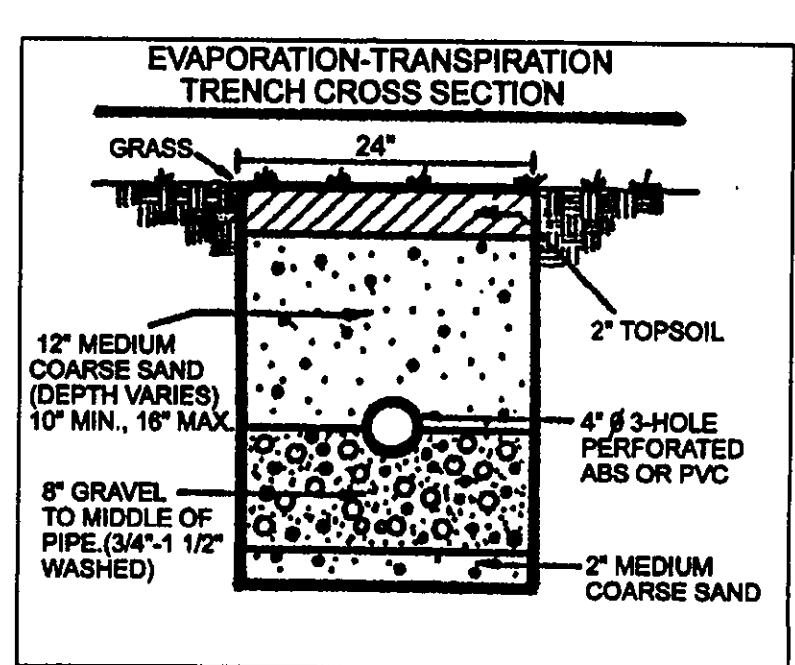
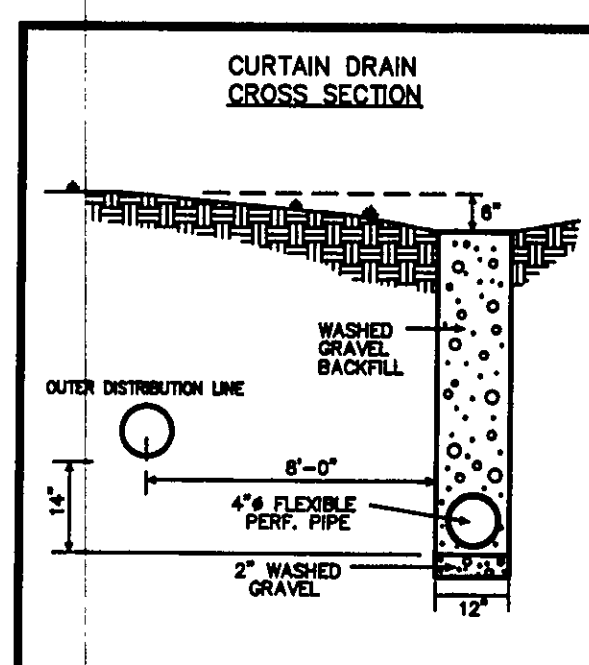


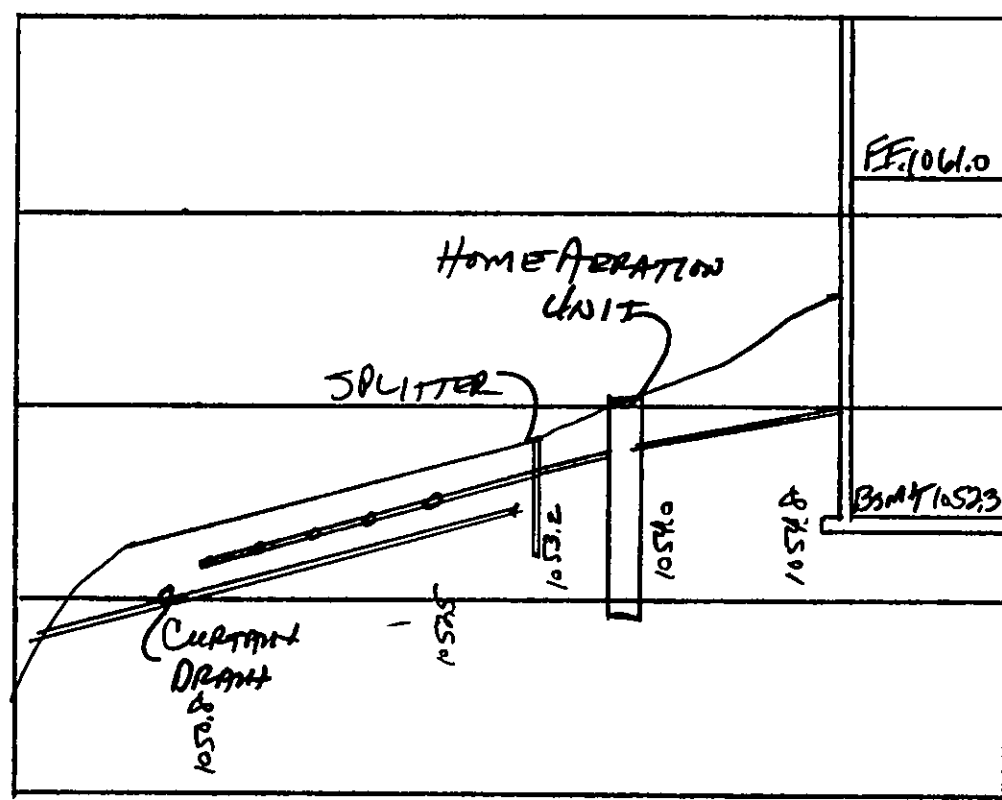

US ROUTE 6 - (60')

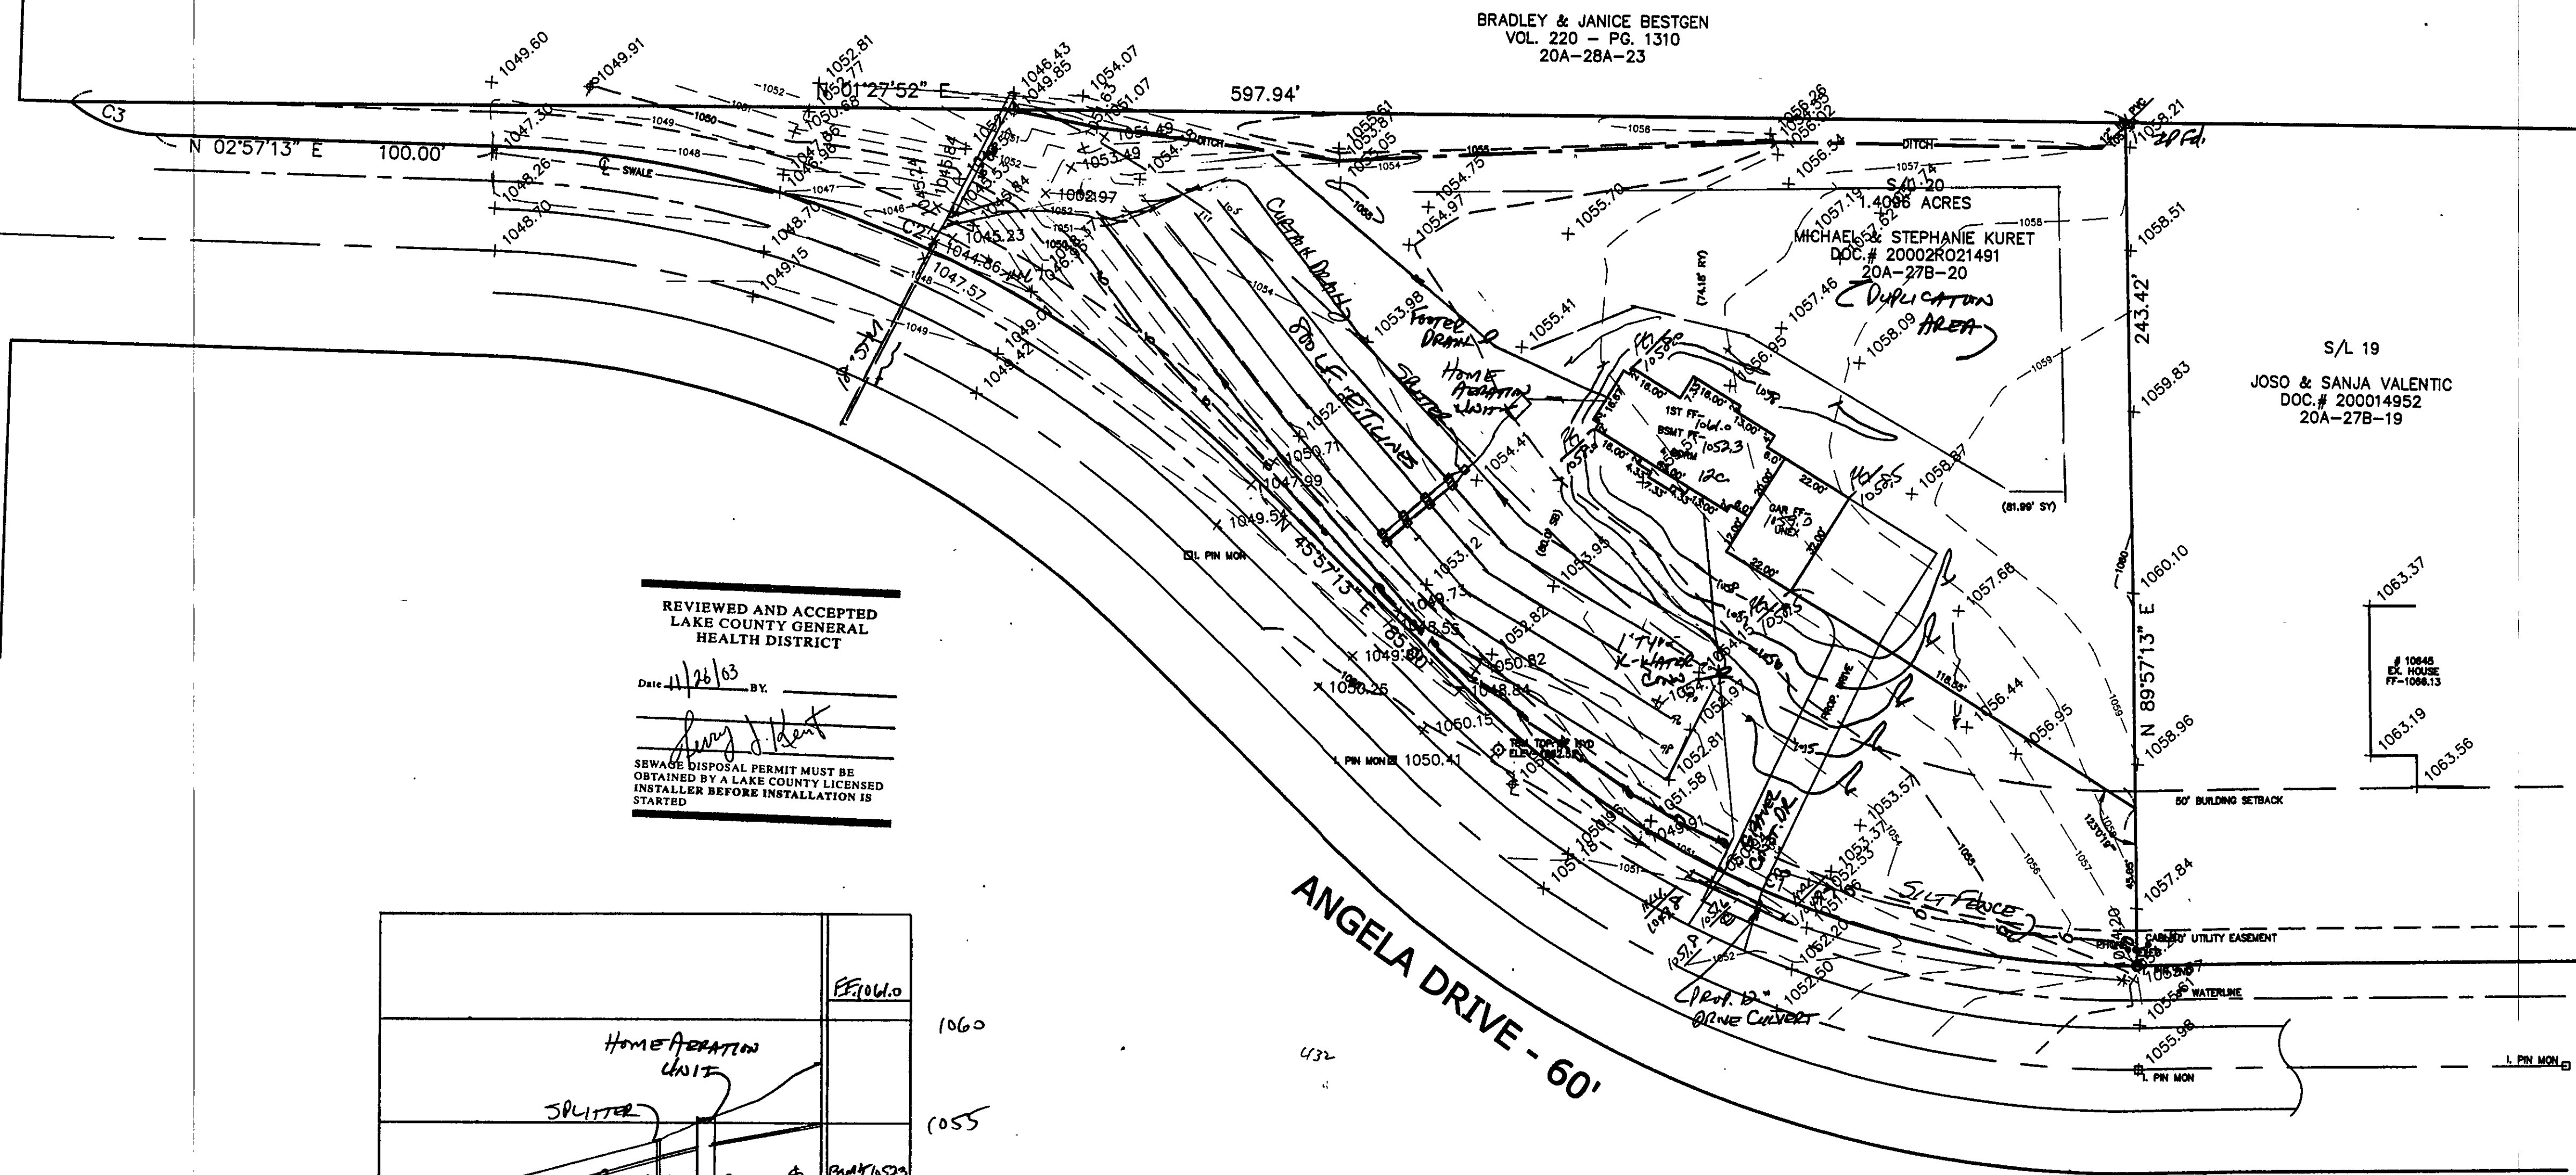

CURVE	LENGTH	RADIUS	TANGENT	CHORD	BEARING	DELTA
C1	216.75	270.00	114.81	210.99	S22°27'13"W	42°36'26"
C2	247.66	330.00	129.99	241.89	N24°27'13"E	42°36'26"
C3	26.98	40.00	14.02	26.47	S22°16'36"W	38°38'38"

SURVEYOR CERTIFICATION

THIS PLAT REPRESENTS A SURVEY WHICH MEETS STANDARDS FOR A BOUNDARY SURVEY IN THE STATE OF OHIO AS SPECIFIED IN THE ADMINISTRATIVE CODE CHAPTER 4733-37

SURVEYED ON Oct. 27, 2003 BY ED HEDENFORD UNDER THE SUPERVISION OF HARRY JONES P.S. # 6343, ALL IRON PINS SHOWN HEREON WERE EITHER FOUND OR SET AS NOTED.

[Signature] P.S. # 6343 DATE: 10/30/03

THE TOPOGRAPHY, INDICATED BY 1' CONTOURS, AND ELEVATIONS SHOWN HEREON, REPRESENT AN ACTUAL FIELD SURVEY MADE BY ED HEDENFORD ON 10/27/03. THE ELEVATIONS WERE TAKEN AT APPROPRIATE INTERVALS AND AS OF THE ABOVE DATE THEY EXISTED AS INDICATED HEREON.

[Signature] P.S. # 6343 DATE: 10/30/03


Stormwater Management Plan
Approved as shown and/or noted
JAMES R. GILLS, P.E.
County Drainage Engineer
By 6343 Date 11/26/03

Subject to approval by:

- ☒ Zoning Department
- ☒ LC General Health District
- ☒ LC Soil & Water Conservation District
- ☒ LC Building Department (final approval)

TBM TOP OF HYD
ELEV-1052.52

EXISTING UTILITIES NOTE:
THE SIZE AND LOCATION, BOTH HORIZONTAL AND VERTICAL OF THE UNDERGROUND UTILITIES SHOWN HEREON, HAVE BEEN OBTAINED BY A SEARCH OF AVAILABLE RECORDS. VERIFICATION BY FIELD OBSERVATION HAS BEEN CONDUCTED WHERE PRACTICAL. HOWEVER, BABCOCK, JONES AND ASSOCIATES, INC. DOES NOT GUARANTEE THE COMPLETENESS NOR ACCURACY THEREOF.

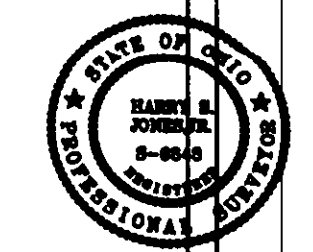

REV. NO.	DESCRIPTION	DATE	BY	CHK'D
1	REVISED PER LC HEALTH DEPT	11/26/03	HJ	TD

bj BABCOCK, JONES AND ASSOCIATES, INC
CIVIL ENGINEERS - SURVEYORS - LAND PLANNERS
PAINESVILLE OHIO 44077

DATE 10/29/03
DESIGN BY HJ
DRAWN BY NS
APPROVED BY HJ

SITE PLAN
FOR
ALEXANDRA HOMES
S/L 20 ANGELA DRIVE PARCEL 20A-27B-20
CITY OF KIRTLAND LAKE COUNTY STATE OF OHIO

SCALE 1"=30'
JOB NO. 00-095-20
SHEET 1 OF 1