

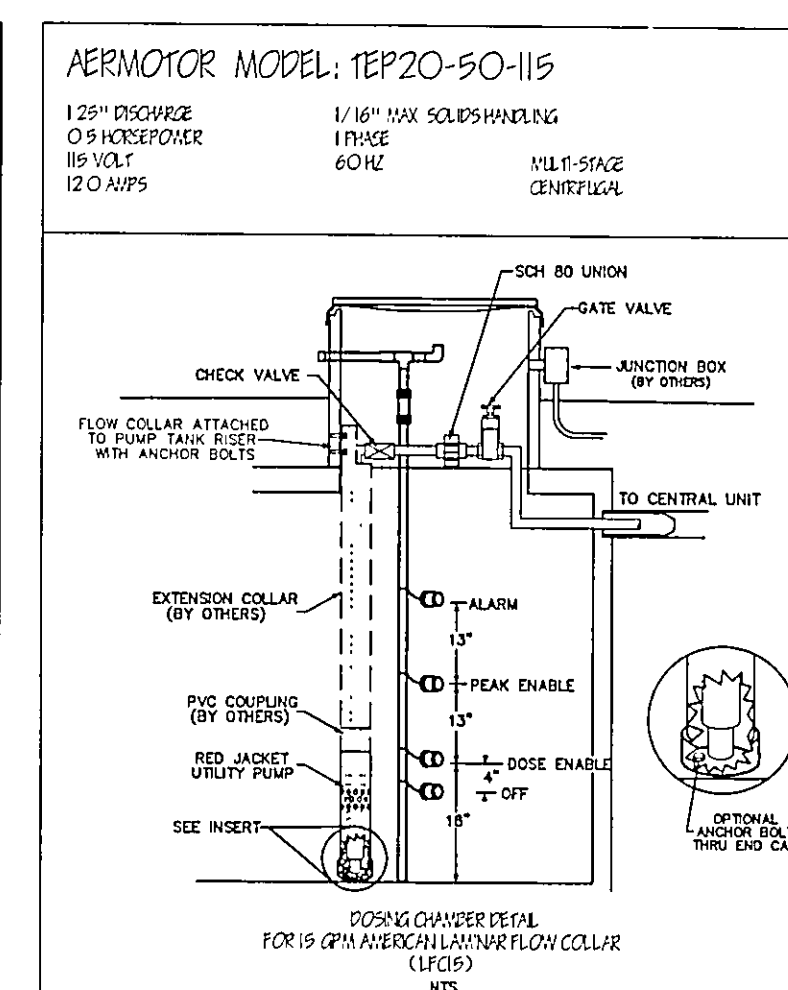
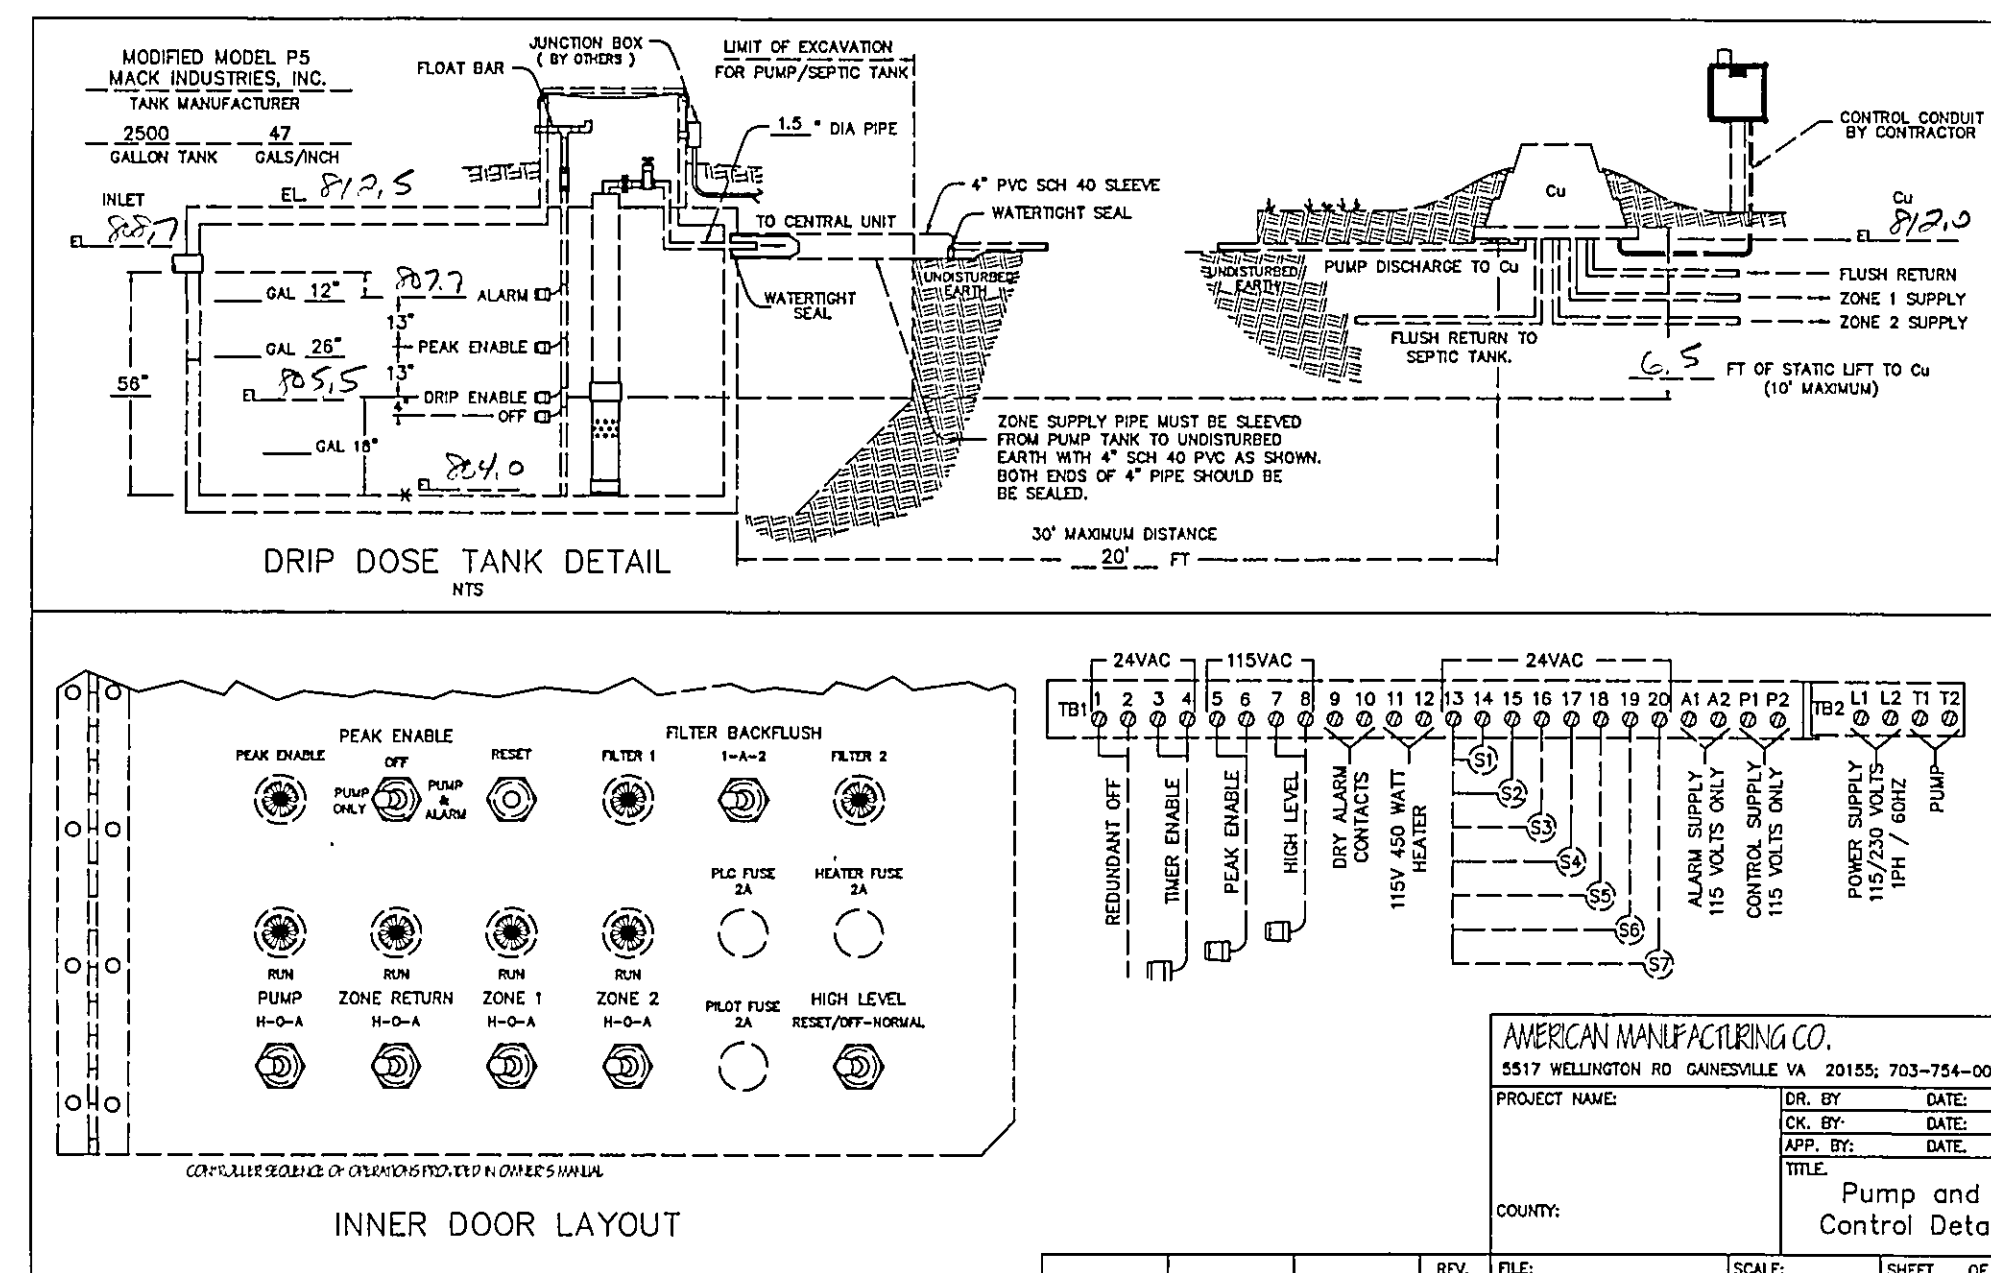
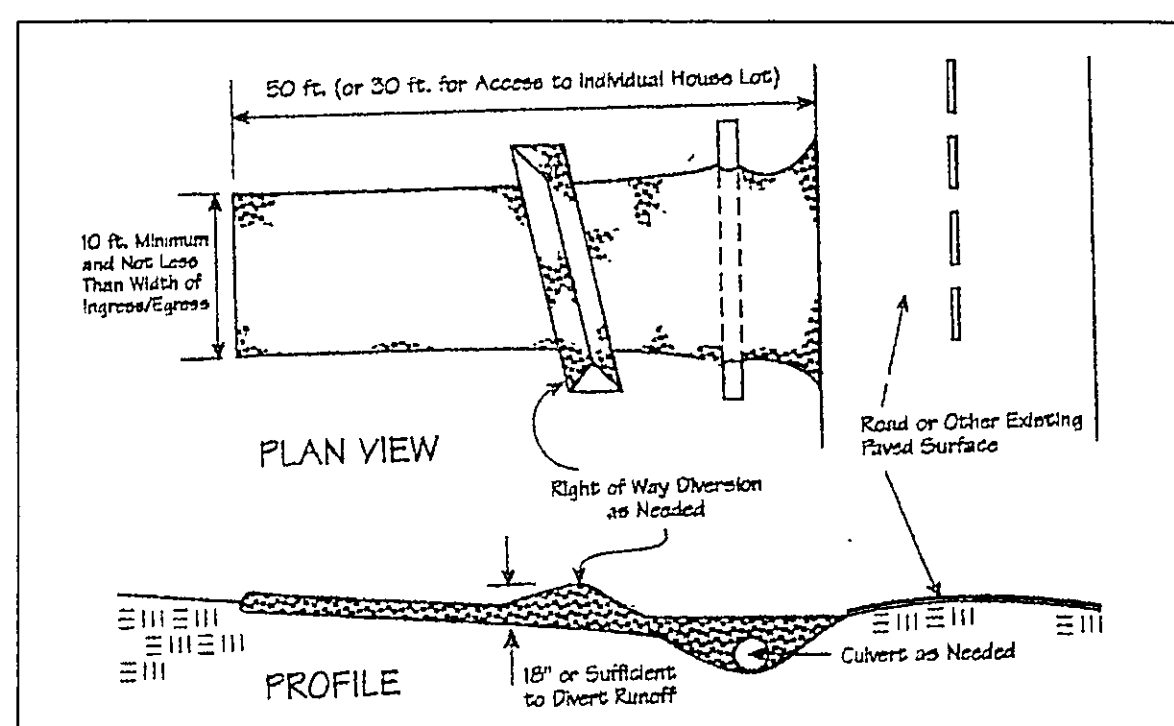


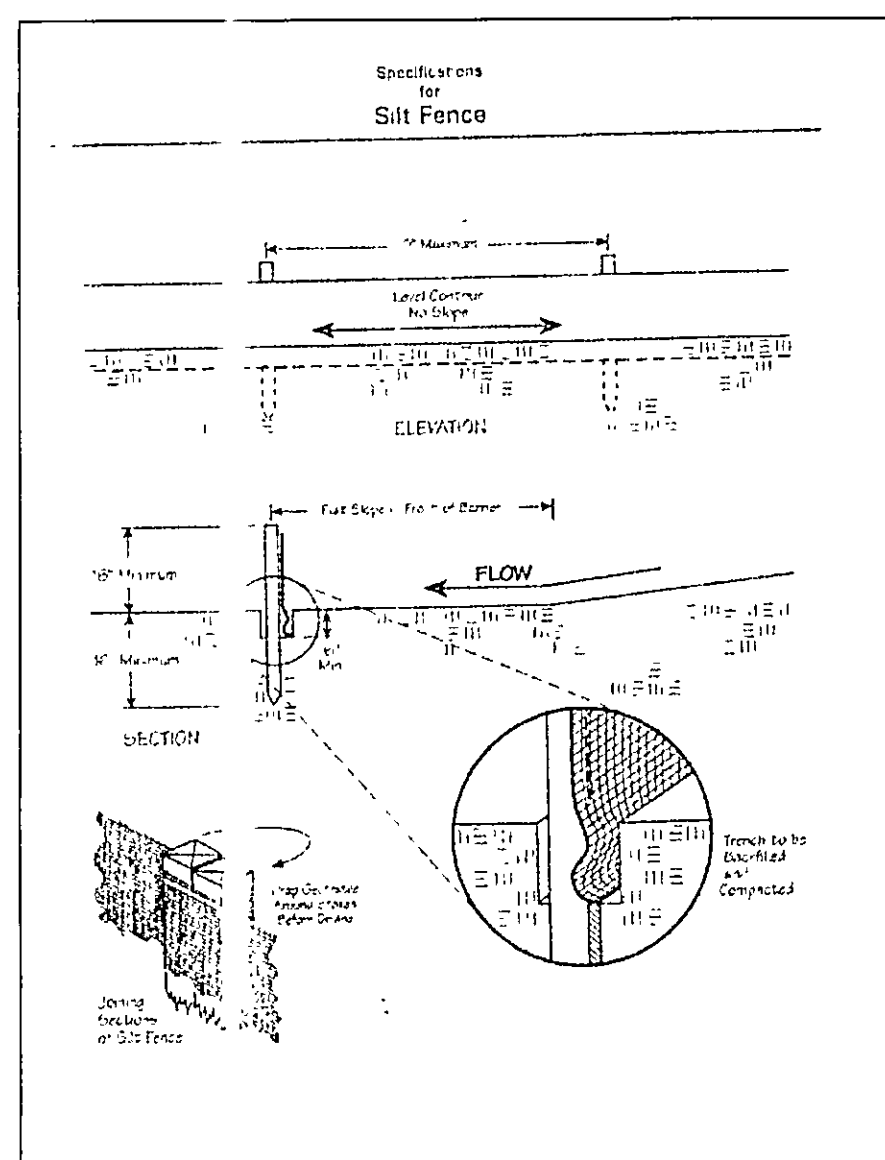

Temporary Seeding Species Selection			
Seeding Dates	Species	Lb./1,000 ft. ²	Per Ac.
March 1 to August 15	Oats	3	4 bushel
	Tall Fescue	1	40 lb.
	Annual Ryegrass	1	40 lb.
	Perennial Ryegrass	1	40 lb.
	Tall Fescue	1	40 lb.
	Annual Ryegrass	1	40 lb.
August 16 to November 1	Rye	3	2 bushel
	Tall Fescue	1	40 lb.
	Annual Ryegrass	1	40 lb.
	Wheat	3	2 bushel
	Tall Fescue	1	40 lb.
	Annual Ryegrass	1	40 lb.
	Perennial Ryegrass	1	40 lb.
	Tall Fescue	1	40 lb.
	Annual Ryegrass	1	40 lb.
November 1 to Spring Seeding	Use much only, seeding practices or dormant seeding.		

Note: Other approved species may be substituted.

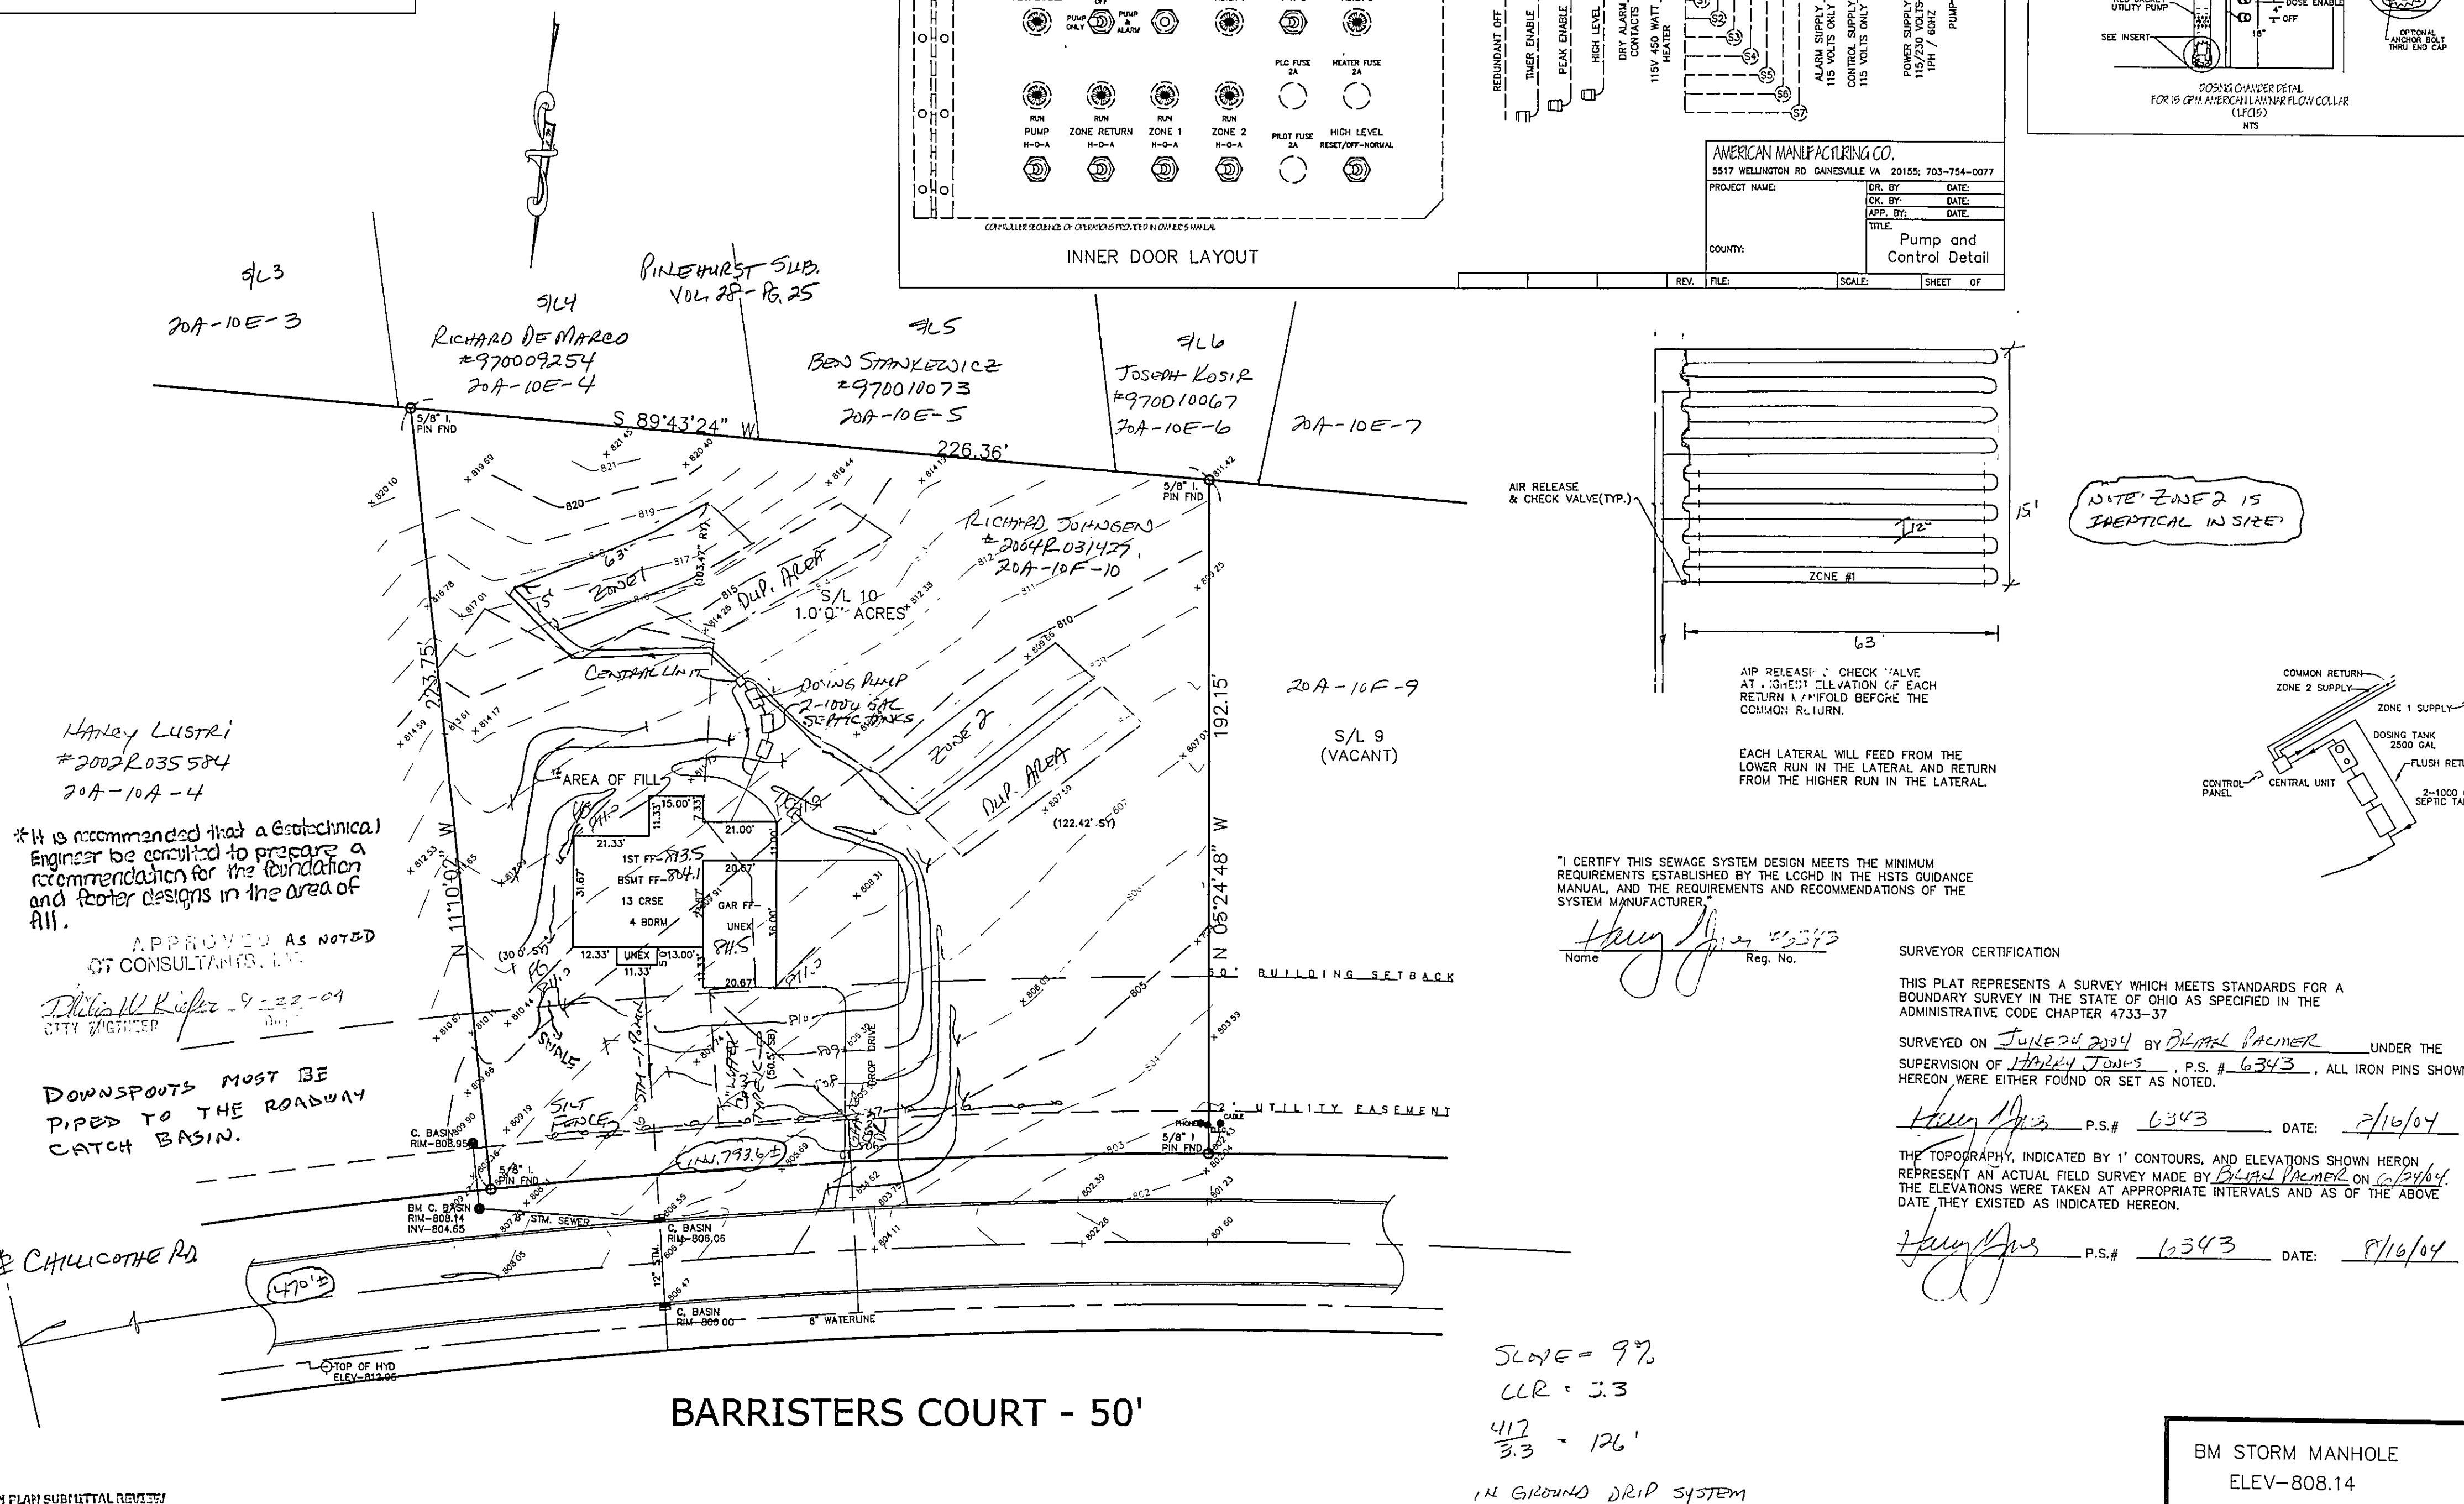

Erosion and Sediment Control Schedule

Ingress—Egress

A stone access drive complete with under lying geo-textile fabric (20 feet wide and 50 feet long) for ingress and egress at the site shall be installed. This drive shall be only entrance and exit to the site.

Silt Fence

A silt fence shall be installed prior to any earthwork activities at the site in the locations shown on the site plan as well as along the front of any lot that slopes towards the street.

Temporary Seeding

Disturbed areas of the site that are to remain idle for more than thirty(30) days shall be properly seeded and straw mulched within seven(7) days of completion of initial grading. Temporary seeding and mulching over a thirty(30) foot strip of the entire front of the lot shall be maintained on the site once initial grading is complete.

Stabilization of critical areas within fifty(50) feet of any stream or wetland shall be complete within two(2) days of the disturbance if the site is to remain inactive for longer than fourteen(14) days.

Mulching

Straw-mulch shall be applied at a rate of 1 bale per every ten (10) feet of curb, at a width of thirty(30) feet to the entire length of the lot. Wood chips may also be used but must be spread at a minimum depth of four inches over the thirty-foot width and must be accompanied by a properly installed silt fence.

Maintenance

Erosion and sediment controls shall be inspected every seven(7) days with 24 hours of a 0.5" or greater rainfall event. Necessary repairs shall be made at this time.

Necessary repairs shall be made at this time.

DWP DISTRIBUTION PLAN SUBMITTAL REVIEW

Drip distribution area has been field
verified and protected with marking tape

Plans submitted to LCGHD and meet design criteria

Hydraulic calculations verified and accurate


Date 9-14-4 Name Dan O
9.14.4 Dej
9-14-4 DOL
 Move zone 2 25' from
 zone 1

By D.S. Date 10/4/04

By L.S. Date 10/4/04

CURVE	LENGTH	RADIUS	TANGENT	CHORD	BEARING	DELTA
C1	203.36	2025.00	101.77	203.28	N81°42'31"E	05°45'14"

EXISTING UTILITIES NOTE:
THE SIZE AND LOCATION, BOTH HORIZONTAL AND VERTICAL
OF THE UNDERGROUND UTILITIES SHOWN HEREON, HAVE BEEN
OBTAINED BY A SEARCH OF AVAILABLE RECORDS.
VERIFICATION BY FIELD OBSERVATION HAS BEEN CONDUCTED
WHERE PRACTICAL, HOWEVER, BABCOCK, JONES AND ASSOCIATES
INC. DOES NOT GUARANTEE THE COMPLETENESS NOR ACCURACY
THEREOF.

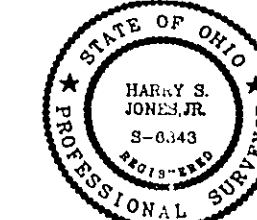

RE	2.	DESCRIPTION	DATE	BY	CHK'D
		REVISED SEPTIC SYSTEM	7/29/04	N.S.	H.J.
		REVISED HOUSE	8/12/04	N.S.	H.J.
		REVISED DR	8/27/04	HT	HT
		REVISED PER L.C. HENRY DEPT	9/1/04	HT	HT
		REVISED PER STRANICK	9/1/04	HT	HT

h

BABCOCK, JONES AND ASSOCIATES, INC

CIVIL ENGINEERS – SURVEYORS – LAND PLANNERS

PAINESVILLE OHIO 44077

PHONE: 440-357-1811 FAX: 440-357-9173

DATE	6/28/04
------	---------

DESIGN BY

DRAWN BY

[illegible]

SITE PLAN

EQ

VAL HOMES

S/L 10 BARRISTERS COURT VOL. 44 – PG. 4
CITY OF KIRTLAND LAKE COUNTY STATE OF OHIO

SCALE 1" = 30'

JOB No.

04-149-10

SHEET / OF

1	2
---	---