


 
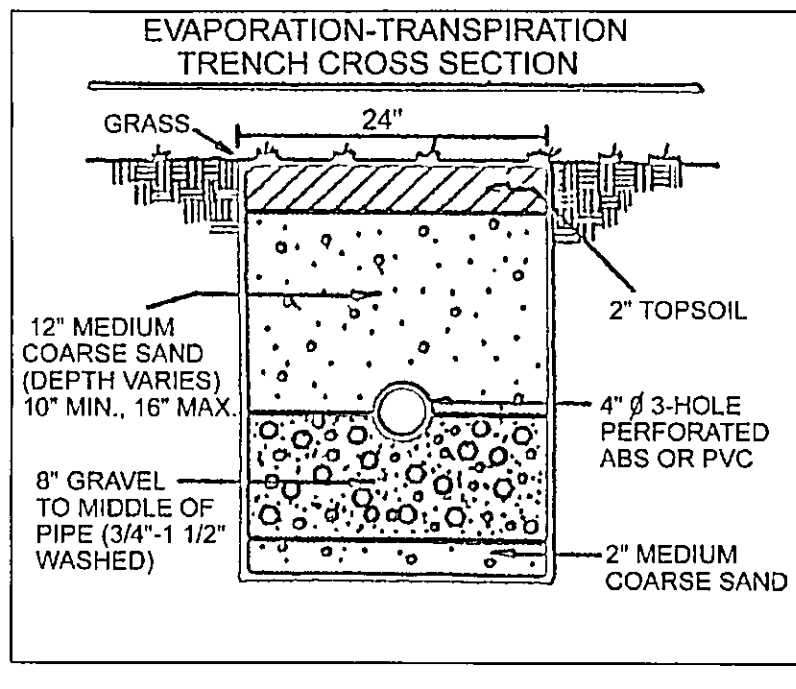
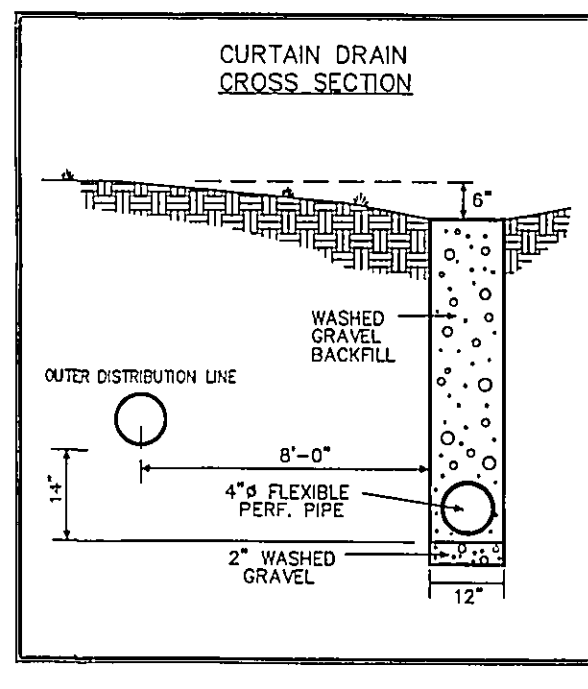


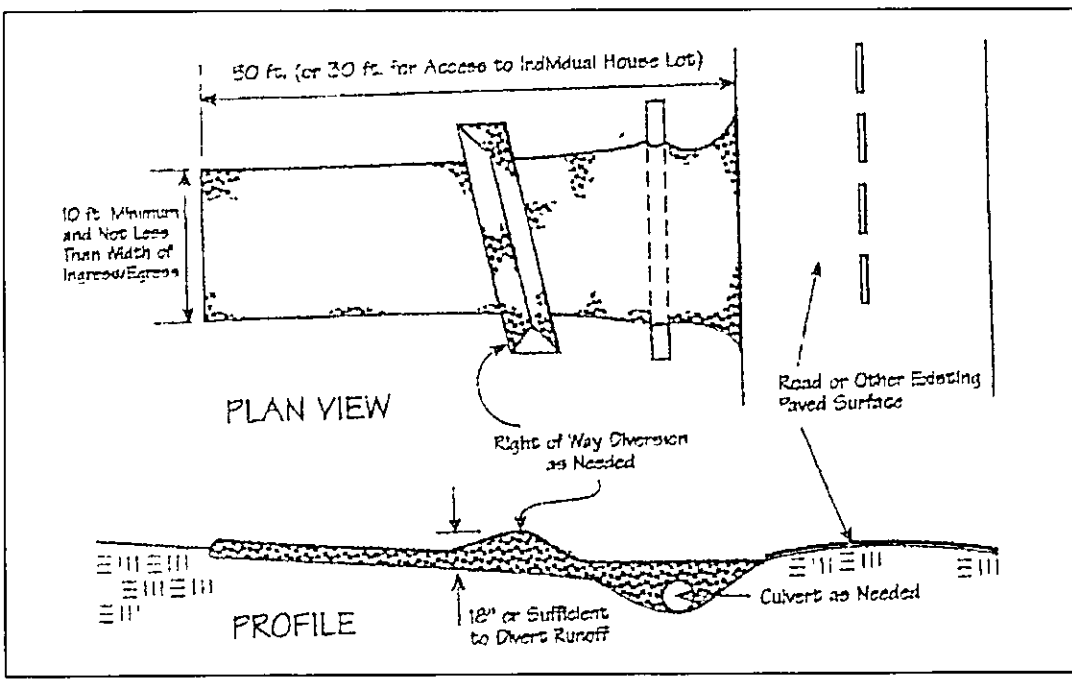

Temporary Seeding Species Selection				
Seeding Dates	Species	Lb / 1,000 ft ²	Per Ac.	
March 1 to August, 15	Oats	3	4 bushels	
	Tall Fescue	1	40 lb	
	Annual Ryegrass	1	40 lb	
	Perennial Ryegrass	1	40 lb	
	Tall Fescue	1	40 lb	
August 16 to November 1	Rye	3	2 bushels	
	Tall Fescue	1	40 lb	
	Annual Ryegrass	1	40 lb	
	Wheat	3	2 bushels	
	Tall Fescue	1	40 lb	
November 1 to Spring Seeding	Perennial Ryegrass	1	40 lb	
	Tall Fescue	1	40 lb	
	Annual Ryegrass	1	40 lb	
	Perennial Ryegrass	1	40 lb	
	Annual Ryegrass	1	40 lb	

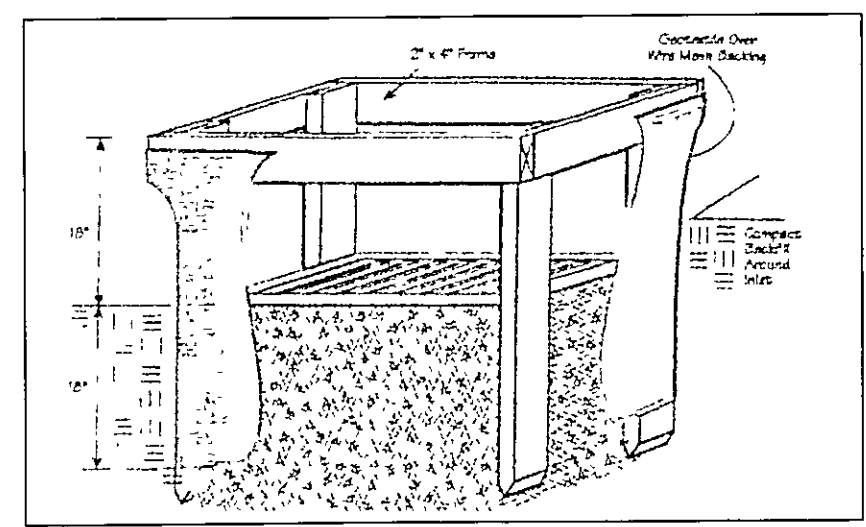

CURVE TABLE						
CURVE	LENGTH	RADIUS	TANGENT	CHORD	BEARING	DELTA
C1	297.36	680.00	151.10	295.00	N03°16'37"E	25°03'20"
C2	131.14	710.00	65.76	130.95	N08°53'58"E	10°34'57"

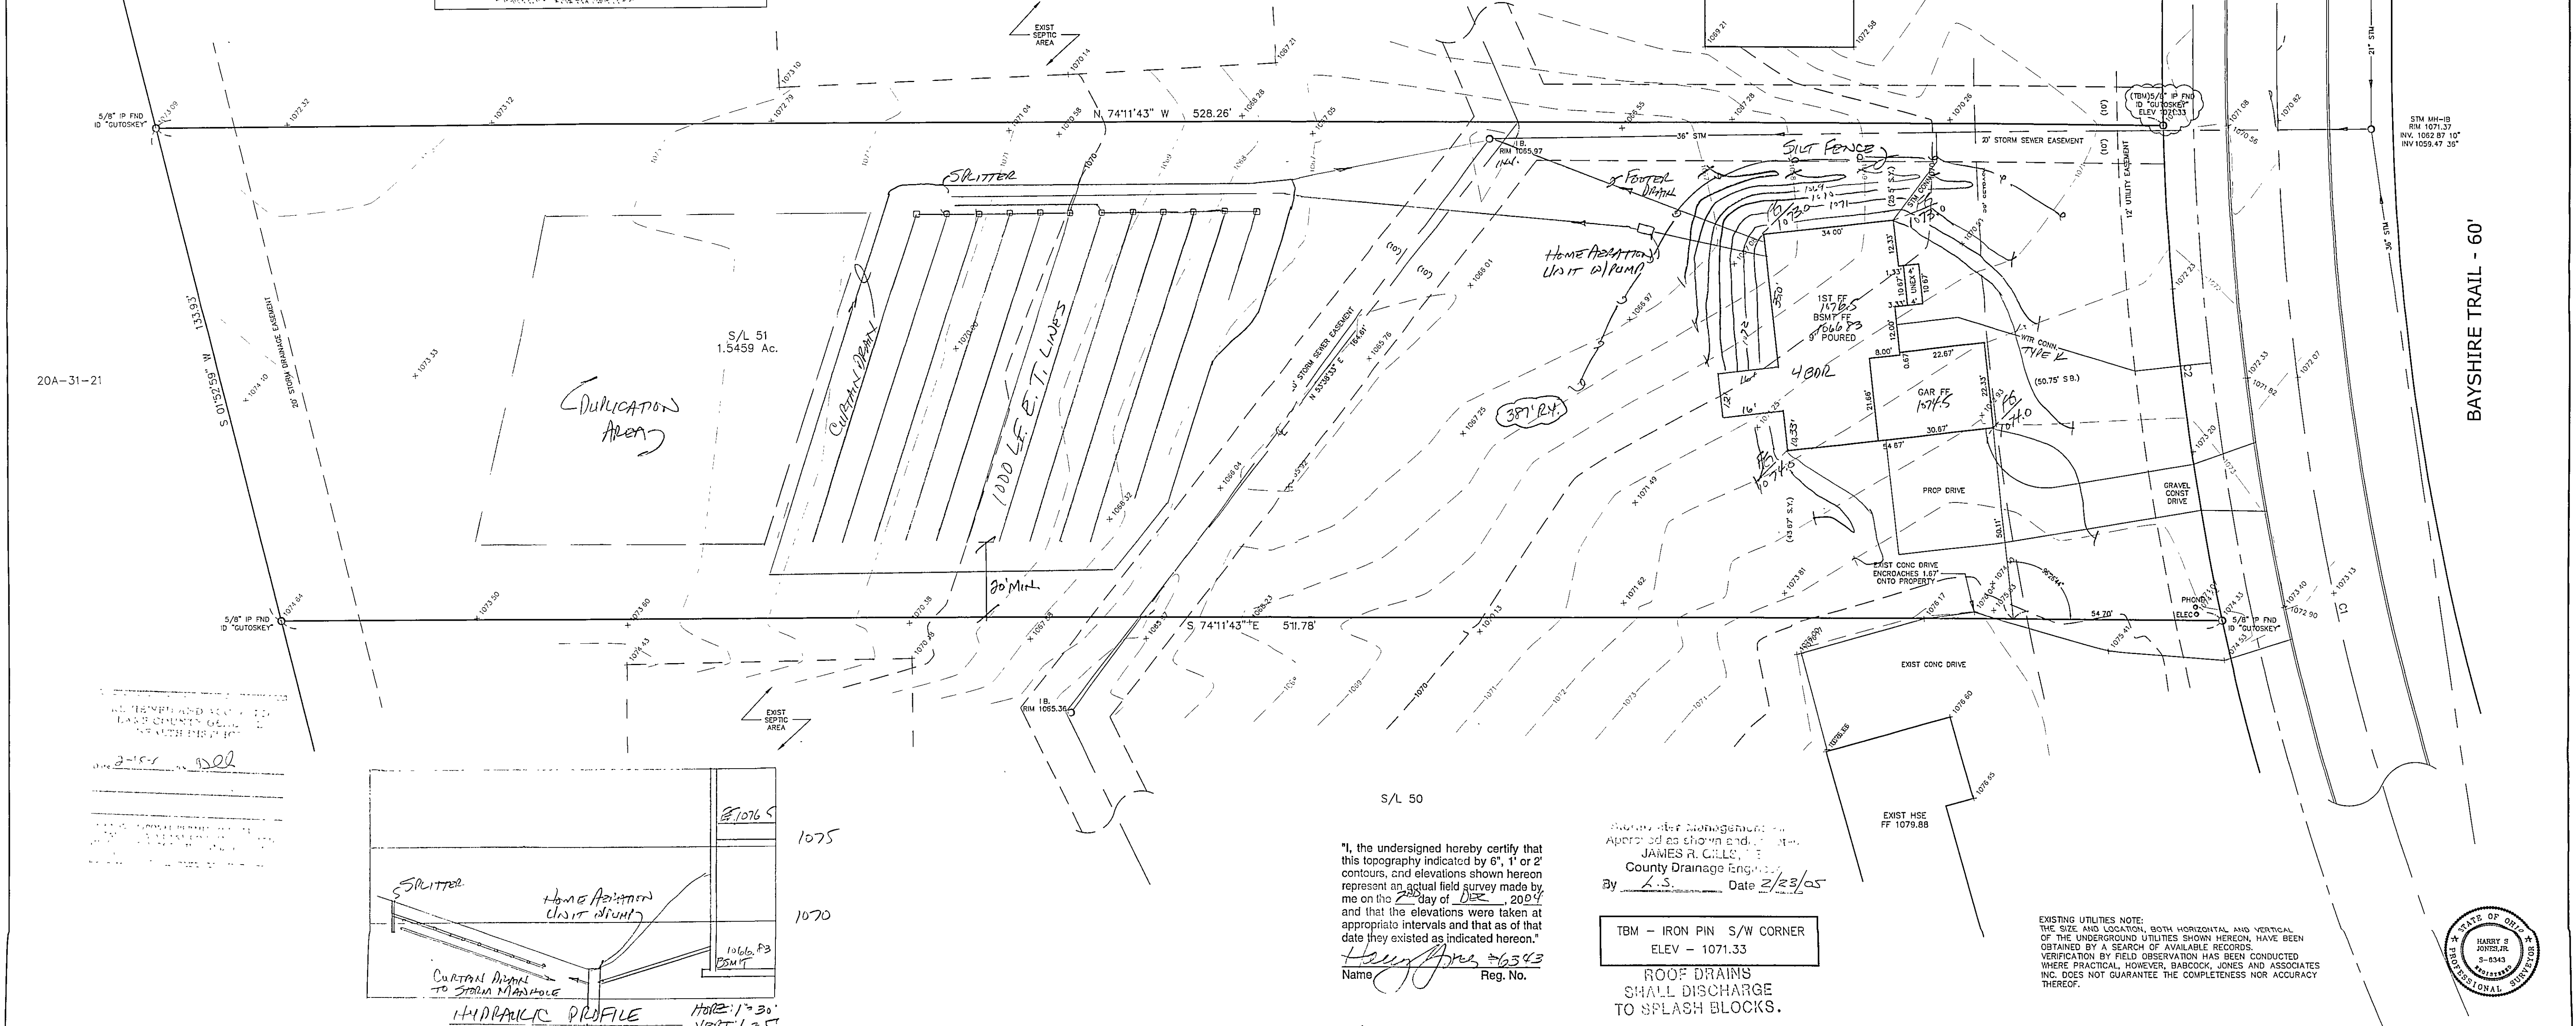

REV. NO.	DESCRIPTION	DATE	BY	CHK'D
1	REVISED FOUNDATIONS	1-28-05	HT	TF
2	REVISIONS FOR L.C. PERMIT DEPT	2-12-05	HT	TF

DATE	12/13/04
DESIGN BY	H.J.
DRAWN BY	B.P.
APPROVED BY	H.J.
CREW CHIEF	W.B.

BABCOCK, JONES AND ASSOCIATES, INC.
CIVIL ENGINEERS - SURVEYORS - LAND PLANNERS
PAINESVILLE OHIO 44077

SITE PLAN
FOR
KNEZ CONSTRUCTION

S/L 51 BAYSHIRE TRAIL (ROCKING HORSE SUB III)
CITY OF KIRTLAND LAKE COUNTY STATE OF OHIO

SCALE 1"=20'

JOB NO 98-061-51

SHEET 1 OF 1

"I, the undersigned hereby certify that this topography indicated by 6", 1" or 2" contours, and elevations shown hereon represent an actual field survey made by me on the 22nd day of DEC, 2004 and that the elevations were taken at appropriate intervals and that as of that date they existed as indicated hereon."

Harry S. Jones, Jr.

Survey for Management and Approval as shown and stated by
County Drainage Engineer
By *L.S.* Date *2/23/05*

TBM - IRON PIN S/W CORNER
ELEV - 1071.33

ROOF DRAINS SHALL DISCHARGE TO SPLASH BLOCKS.

EXISTING UTILITIES NOTE:
THE SIZE AND LOCATION, BOTH HORIZONTAL AND VERTICAL, OF THE UNDERGROUND UTILITIES SHOWN HEREON, HAVE BEEN OBTAINED BY A SEARCH OF AVAILABLE RECORDS. VERIFICATION BY FIELD OBSERVATION HAS BEEN CONDUCTED WHERE PRACTICAL, HOWEVER, BABCOCK, JONES AND ASSOCIATES, INC. DOES NOT GUARANTEE THE COMPLETENESS NOR ACCURACY THEREOF.

