
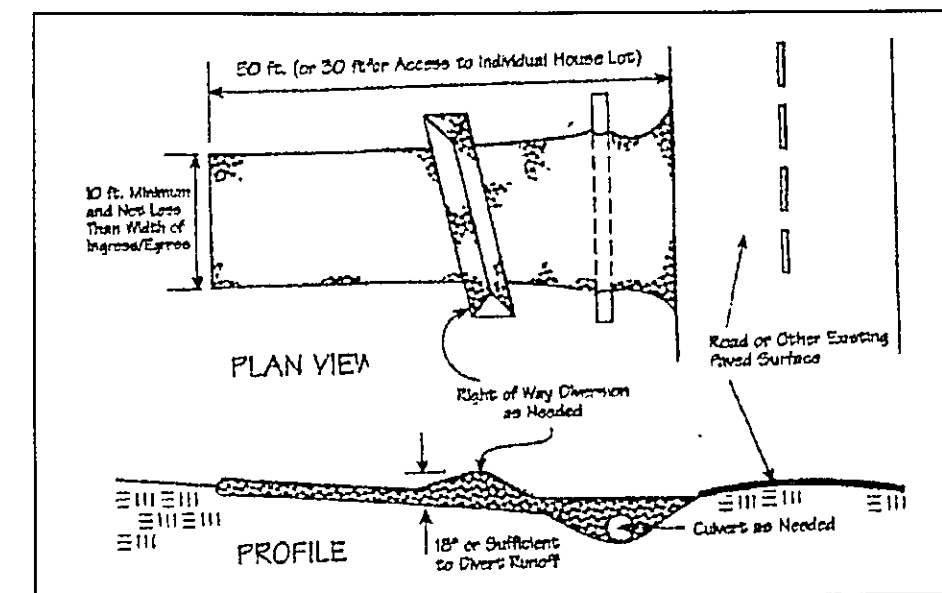
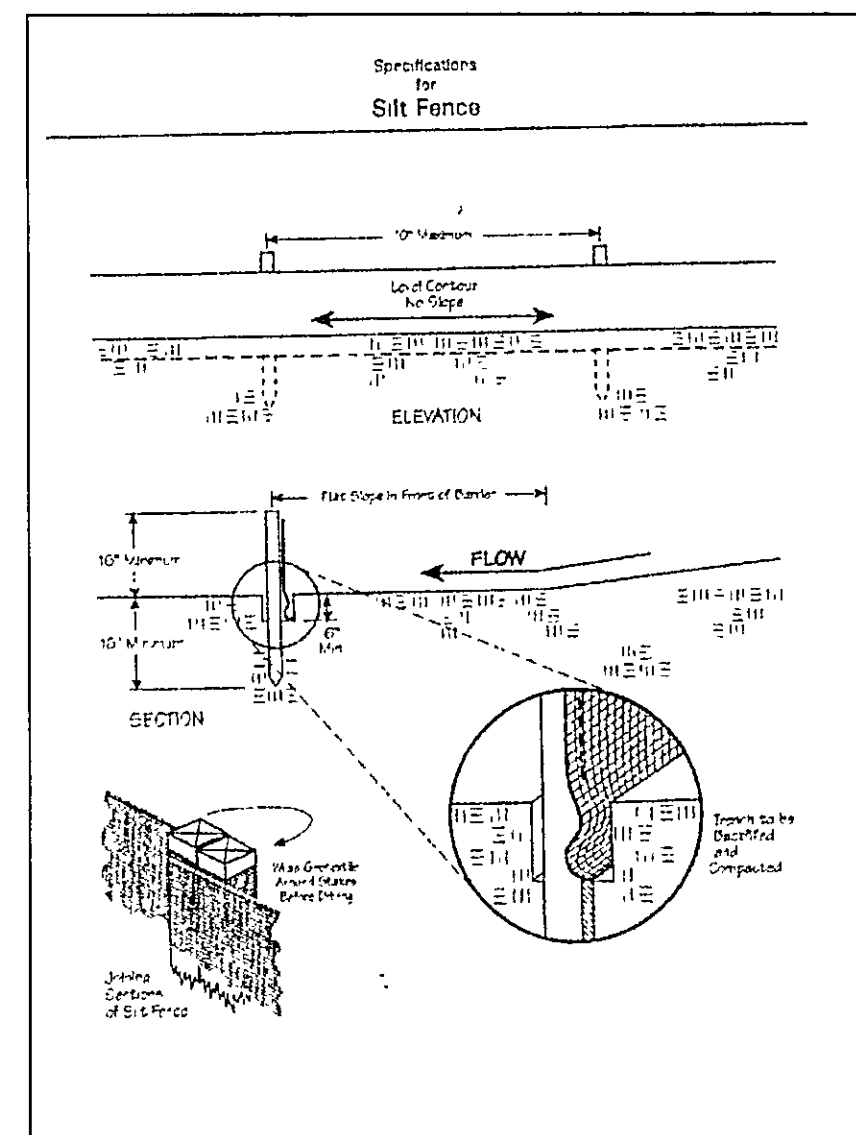


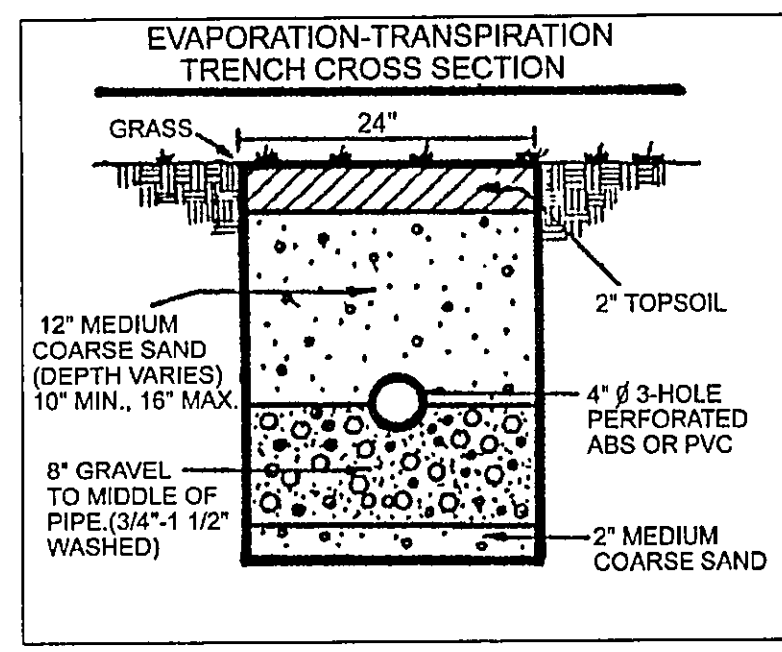


Temporary Seeding Species Selection			
Seeding Dates	Species	Lb./1,000 ft. ²	Per Ac.
March 1 to August 15	Oats	3	4 bushel
	Tall Fescue	1	40 lb.
	Annual Ryegrass	1	40 lb.
	Perennial Ryegrass	1	40 lb.
	Tall Fescue	1	40 lb.
August 16 to November 1	Annual Ryegrass	1	40 lb.
	Rye	3	2 bushel
	Tall Fescue	1	40 lb.
	Annual Ryegrass	1	40 lb.
	Wheat	3	2 bushel
	Tall Fescue	1	40 lb.
	Annual Ryegrass	1	40 lb.
November 1 to Spring Seeding	Perennial Ryegrass	1	40 lb.
	Tall Fescue	1	40 lb.
	Annual Ryegrass	1	40 lb.

Use much only, sodding practices or dormant seeding.

Note: Other approved seed species may be substituted

CONSUMERS OHIO WATER COMPANY
DOC.# 200000477
20A-14G-4

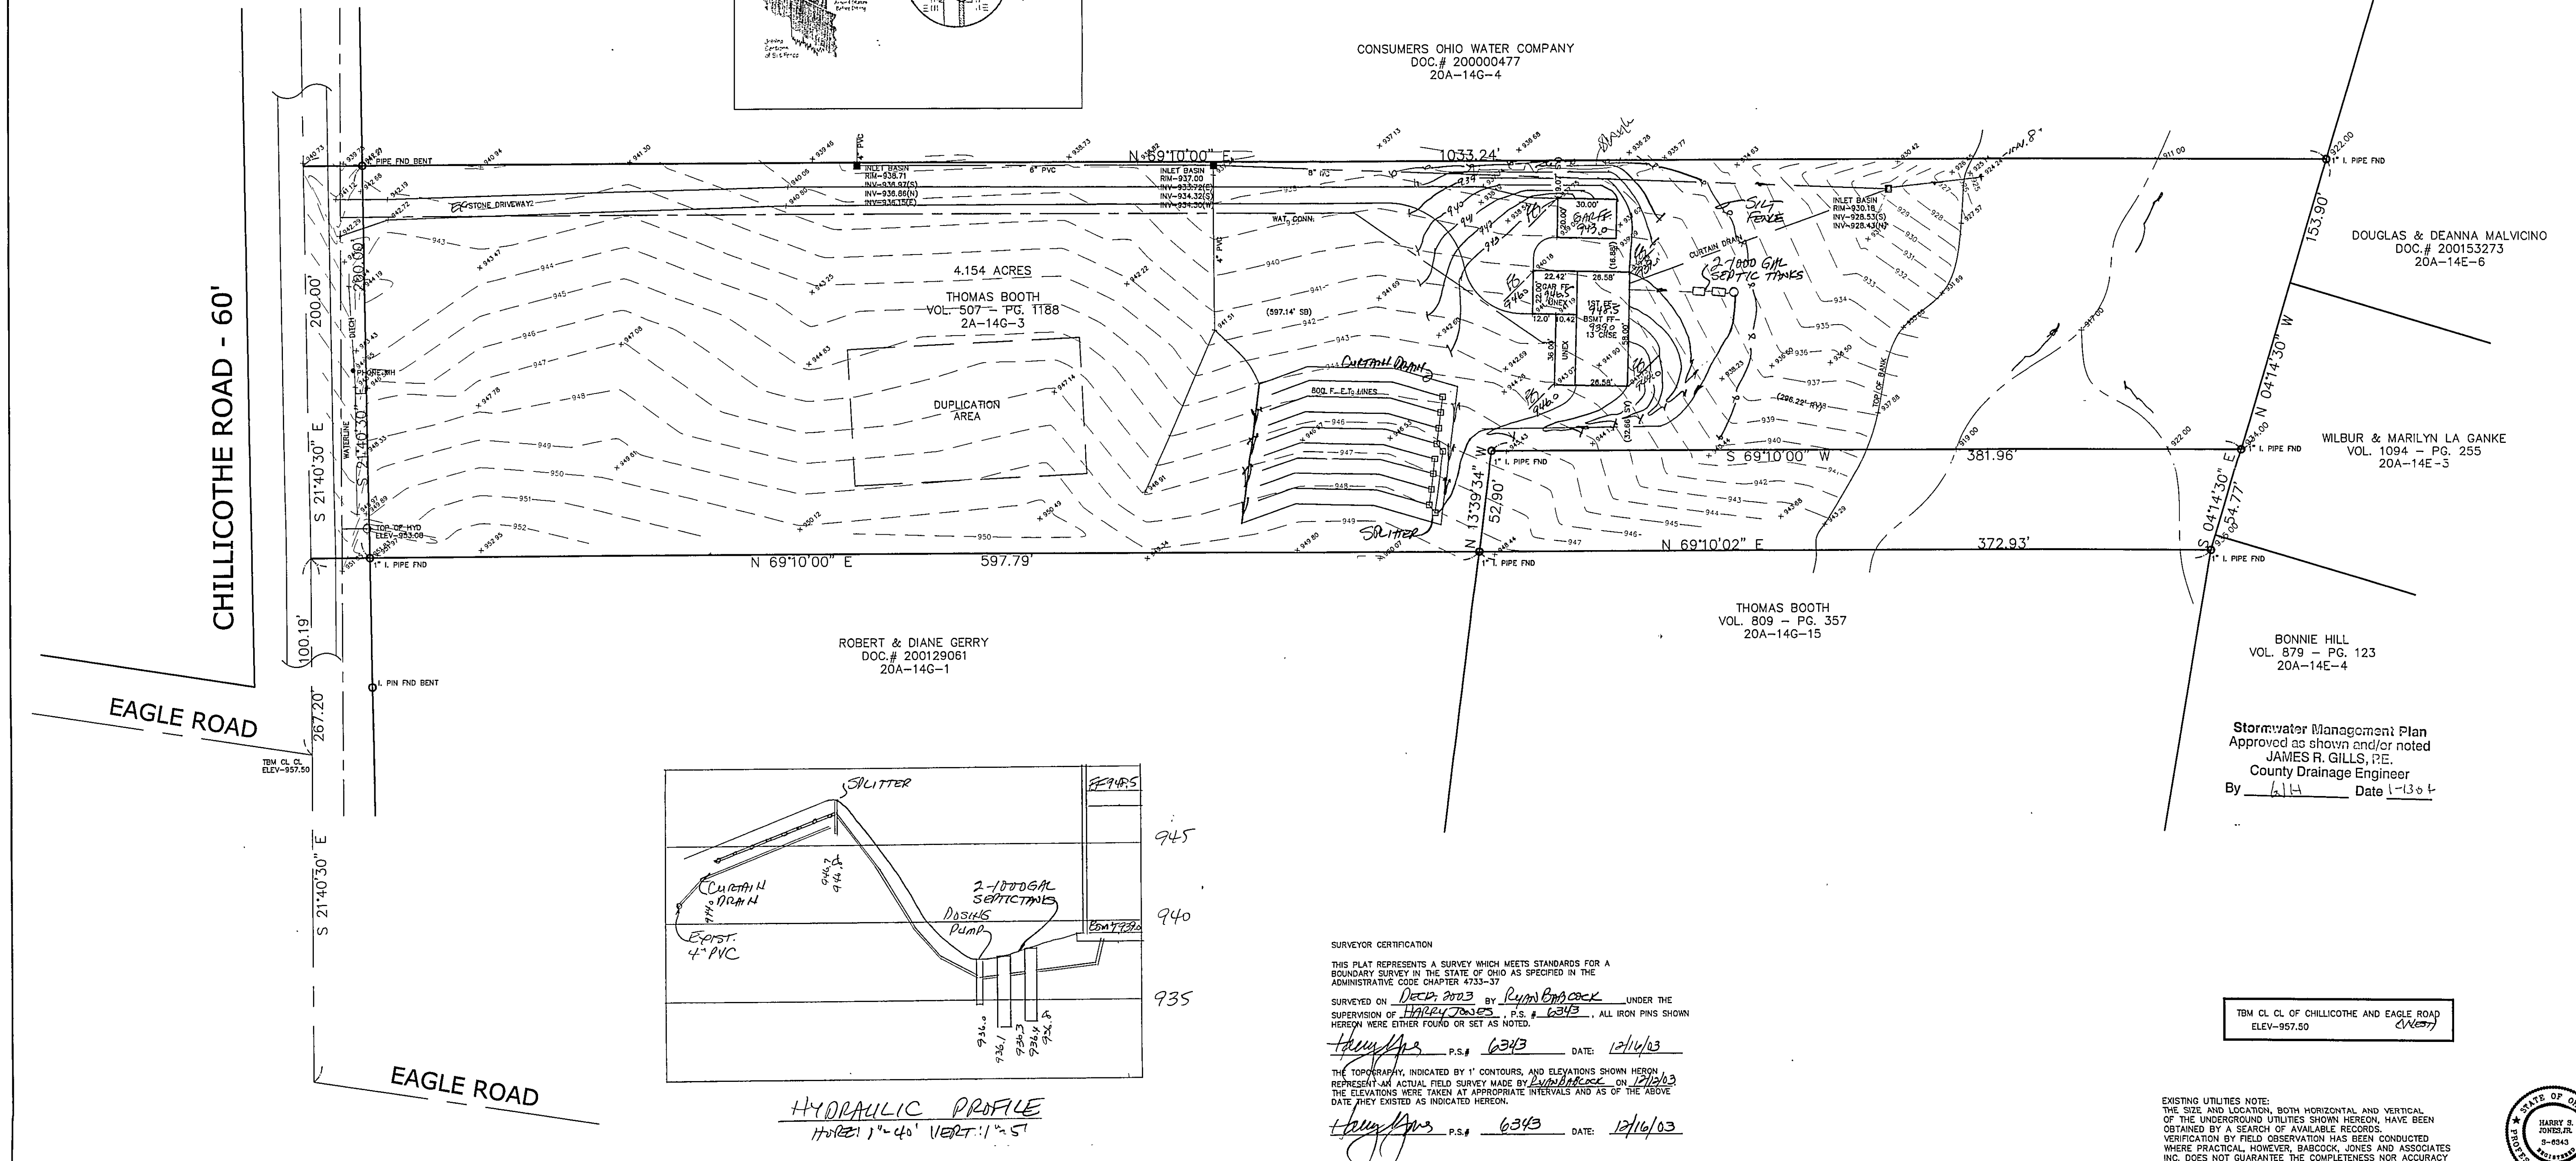

EXISTING UTILITIES NOTE:
THE SIZE AND LOCATION, BOTH HORIZONTAL AND VERTICAL,
OF ALL UNDERGROUND UTILITIES SHOWN HEREON, HAVE BEEN
OBTAINED BY SEARCH OF AVAILABLE RECORD.
VERIFICATION BY FIELD OBSERVATION HAS BEEN CONDUCTED
WHERE PRACTICAL, HOWEVER, BABCOCK, JONES AND ASSOCIATES
INC. DOES NOT GUARANTEE THE COMPLETENESS NOR ACCURACY
THEREOF.



REV NO.	DESCRIPTION	DATE	BY	CHK'D
1	ADDED LAKE COUNTY DETAILS	1/12/04	N.S.	H.J.

b2

BABCOCK, JONES AND ASSOCIATES, INC
CIVIL ENGINEERS - SURVEYORS - LAND PLANNERS
PAINESVILLE OHIO 44077

DATE	12/16/03
DESIGN BY	HJ
DRAWN BY	NS
APPROVED BY	HJ

SITE PLAN
FOR
TOM BOOTH
PARCEL 20A-14G-3 CHILLICOTHE ROAD
CITY OF KIRTLAND LAKE COUNTY STATE OF OHIO

SCALE	
1"=40'	
JOB NO	
03-295	
SHEET	OF
1	1