

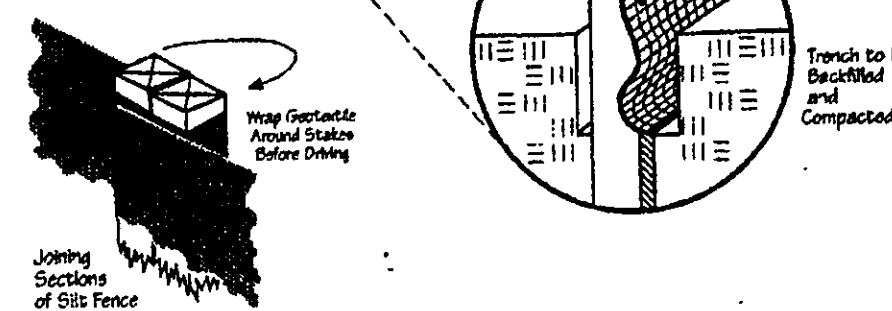
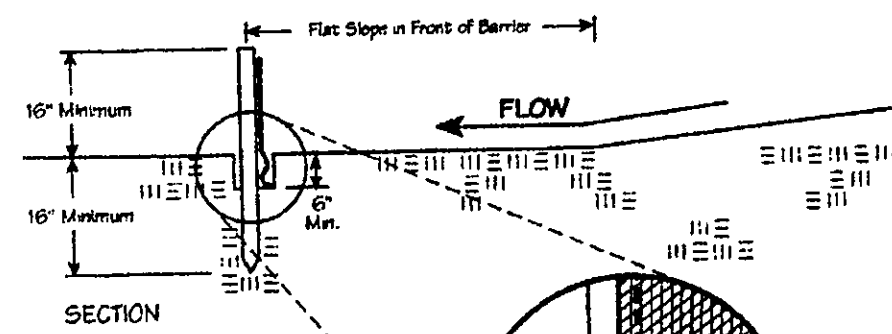


Specifications for Silt Fence

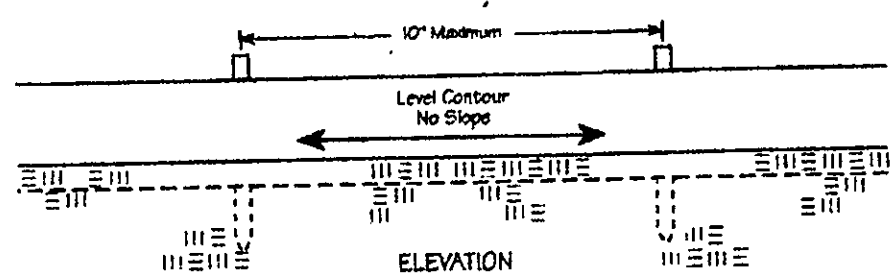





Temporary Seeding Species Selection			
Seeding Dates	Species	Lb./1,000 ft. ²	Per Ac.
March 1 to August 15	Oats	3	4 bushel
	Tall Fescue	1	40 lb.
	Annual Ryegrass	1	40 lb.
	Perennial Ryegrass	1	40 lb.
	Tall Fescue	1	40 lb.
August 16 to November 1	Rye	3	2 bushel
	Tall Fescue	1	40 lb.
	Annual Ryegrass	1	40 lb.
	Wheat	3	2 bushel
	Tall Fescue	1	40 lb.
November 1 to Spring Seeding	Perennial Ryegrass	1	40 lb.
	Tall Fescue	1	40 lb.
	Annual Ryegrass	1	40 lb.
	Wheat	3	2 bushel
	Tall Fescue	1	40 lb.
Note: Other approved seed species may be substituted.			

CURVE TABLE						
CURVE	LENGTH	RADIUS	TANGENT	CHORD	BEARING	DELTA
C1	230.68	600.00	116.78	229.26	S54°36'31"E	22°01'42"
C2	220.10	375.00	113.32	216.95	S07°33'47"W	33°37'41"
C3	120.70	630.00	60.54	120.52	S54°55'55"E	10°58'39"
C4	43.60	30.00	26.66	39.86	N18°46'59"W	83°15'45"
C5	170.81	405.00	86.70	169.55	S10°46'19"W	24°09'54"

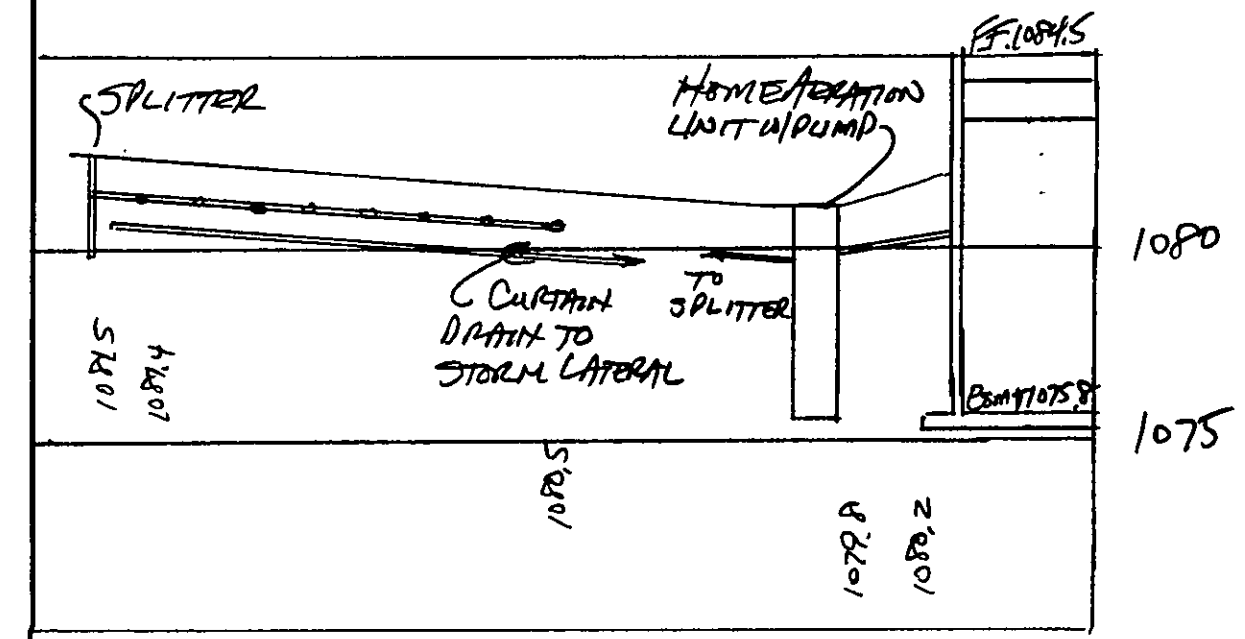

HYDRAULIC PROFILE
HORIZ. 1"=20' VERT. 1"=5'

REV. NO.	DESCRIPTION	DATE	BY	CHK'D

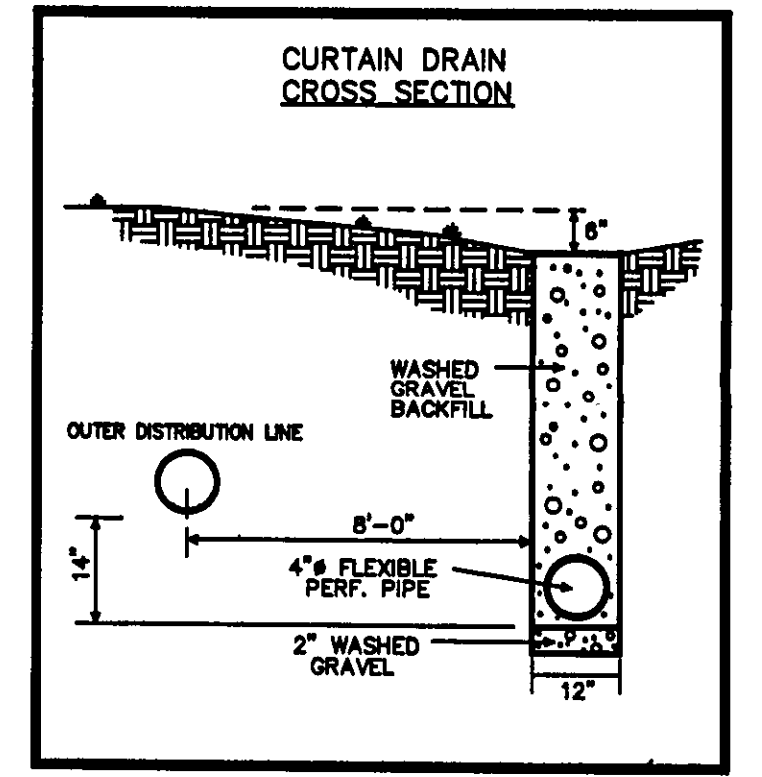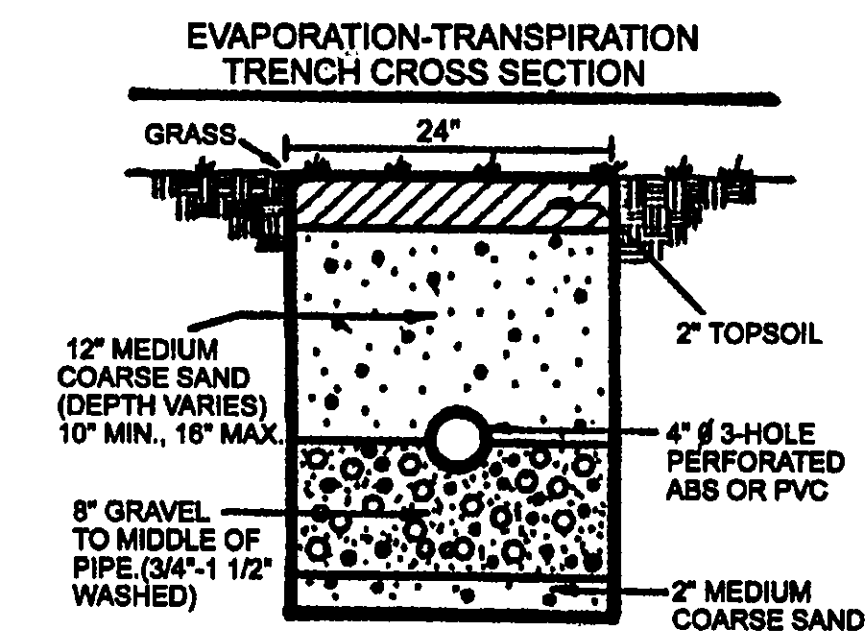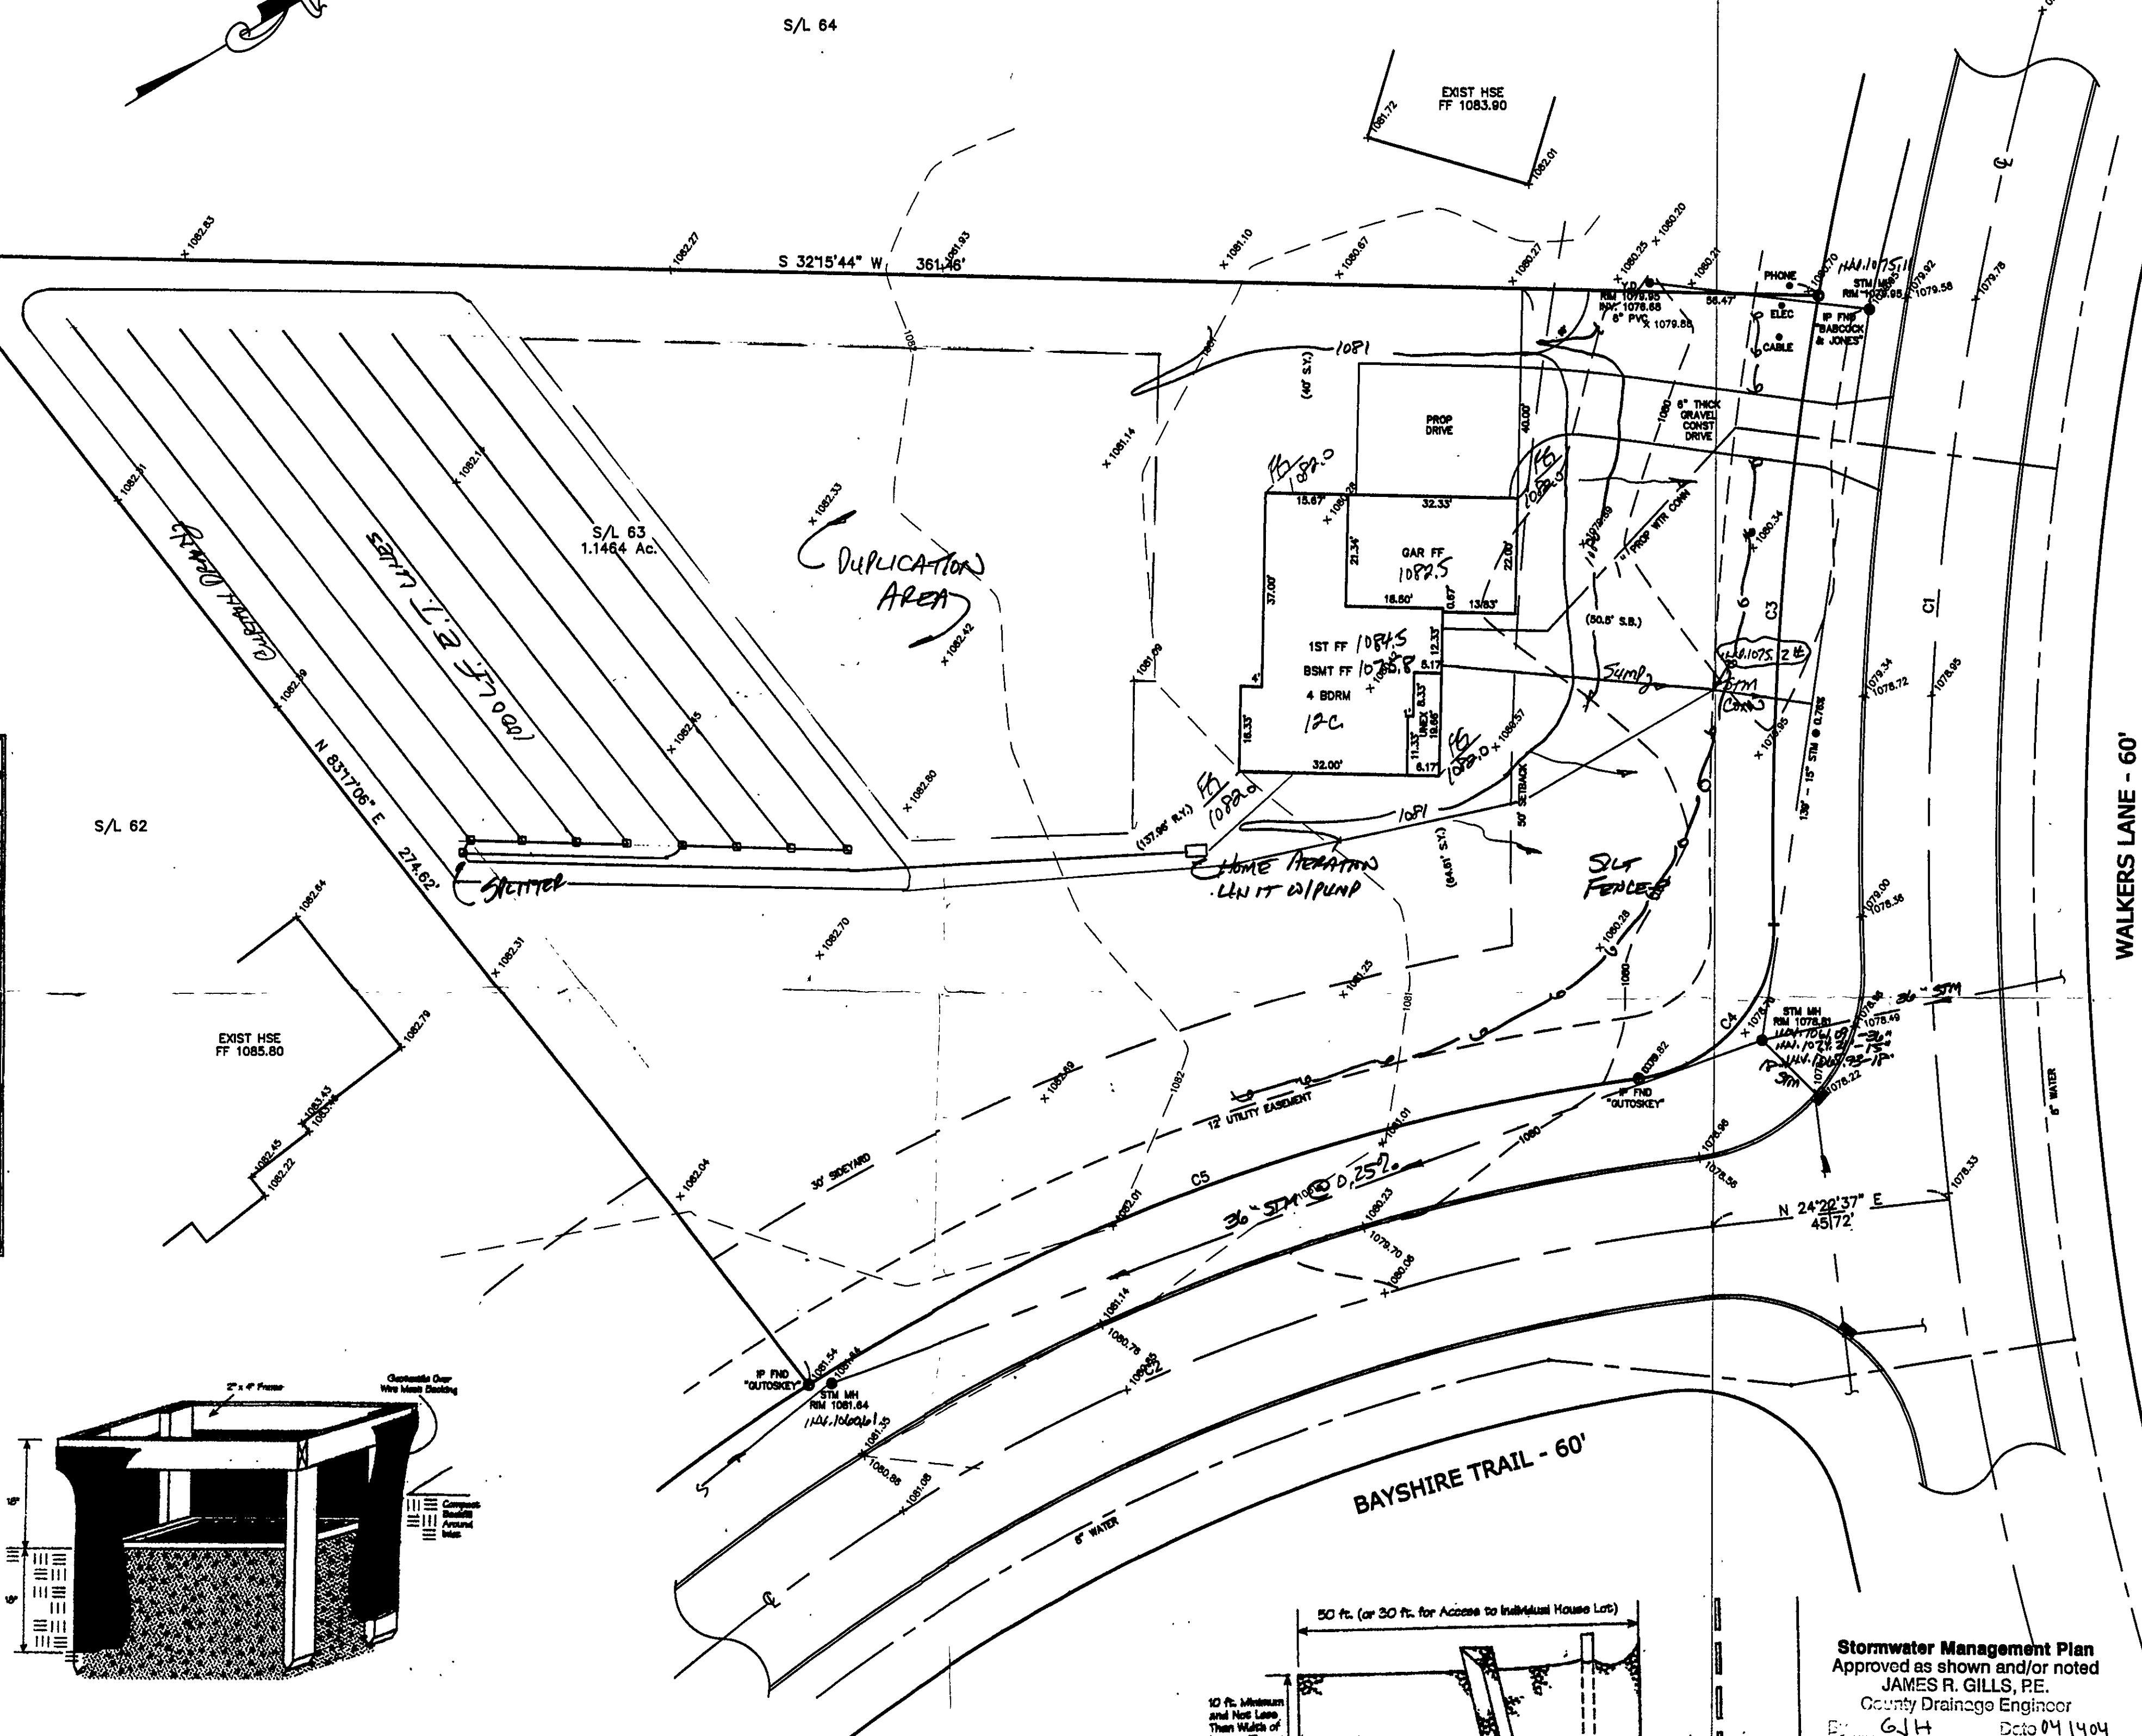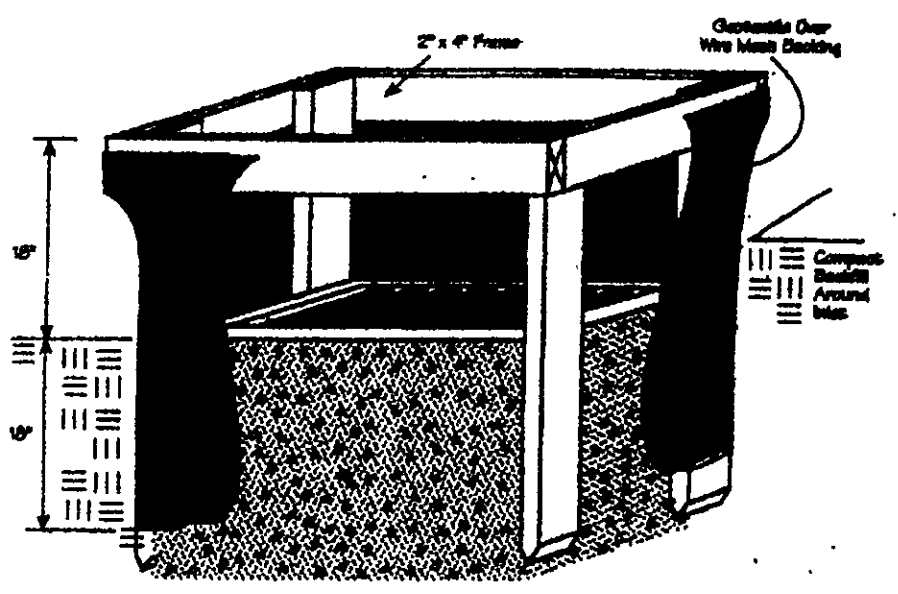

SURVEYOR CERTIFICATION
THIS PLAT REPRESENTS A SURVEY WHICH MEETS STANDARDS FOR A BOUNDARY SURVEY IN THE STATE OF OHIO AS SPECIFIED IN THE ADMINISTRATIVE CODE CHAPTER 4733-37.
DATE: 4/14/04
THE TOPOGRAPHY, INDICATED BY 1' CONTOURS, AND ELEVATIONS SHOWN HEREON REPRESENT AN ACTUAL FIELD SURVEY MADE BY THE SURVEYOR. THE ELEVATIONS WERE TAKEN AT APPROPRIATE INTERVALS AND AS OF THE ABOVE DATE, THEY EXISTED AS INDICATED HEREON.
DATE: 4/14/04

Stormwater Management Plan
Approved as shown and/or noted
JAMES R. GILLS, P.E.
County Drainage Engineer
By: [Signature] Date: 04/14/04

- Subject to approval by:**
- ☐ Zoning Department
 - ☐ LC General Health District
 - ☐ LC Soil & Water Conservation District
 - ☐ LC Building Department (final approval)

NOTING UTILITIES NOTE:
THE SIZE AND LOCATION, BOTH HORIZONTAL AND VERTICAL, OF ALL UNDERGROUND UTILITIES SHOWN HEREON, HAVE BEEN OBTAINED BY A SEARCH OF AVAILABLE RECORDS. WHERE PRACTICAL, HOWEVER, BABCOCK, JONES AND ASSOCIATES, INC. DOES NOT GUARANTEE THE COMPLETENESS NOR ACCURACY THEREOF.

