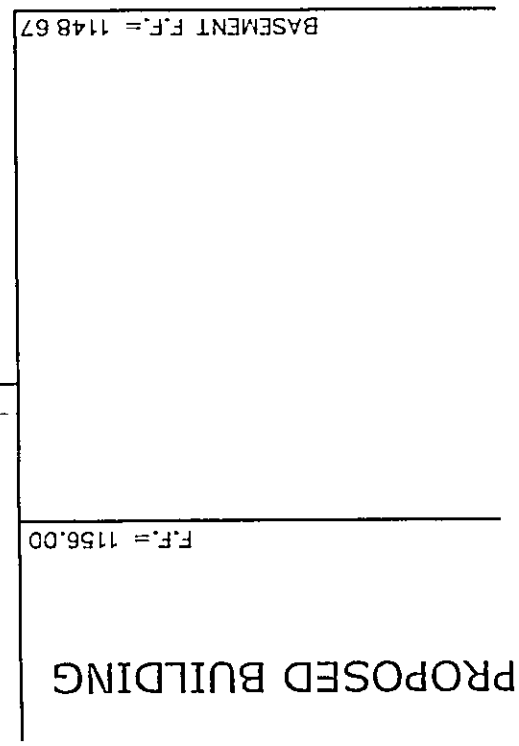


Grading Plan Approved  
as shown and/or noted  
JAMES R. GILLS, P.E.  
Lake County Engineer  
By: Y.S. Date: 6/21/05

|   |  |                                                               |  |                                             |  |                     |  |                     |  |
|---|--|---------------------------------------------------------------|--|---------------------------------------------|--|---------------------|--|---------------------|--|
| Site Plan<br>S/L 24 of the Highland Trail Subdivision for<br>Cianfaglione Builders, Inc.<br>Leroy Township ~ Lake County ~ Ohio |  | Drawn By: JML<br>Checked By:<br>Approved By:<br>Date: 12/8/04 |  | Scale:<br>Horiz. 1" = 30'<br>Vert. 1" = 10' |  | Sheet No. 1<br>Of 2 |  | Filename: 04-099\cb |  |
|---|--|---------------------------------------------------------------|--|---------------------------------------------|--|---------------------|--|---------------------|--|

Site Plan

S/L 24 of the Highland Trail Subdivision for  
Cianfaiglione Builders, Inc.  
Leroy Township ~ Lake County ~ Ohio