

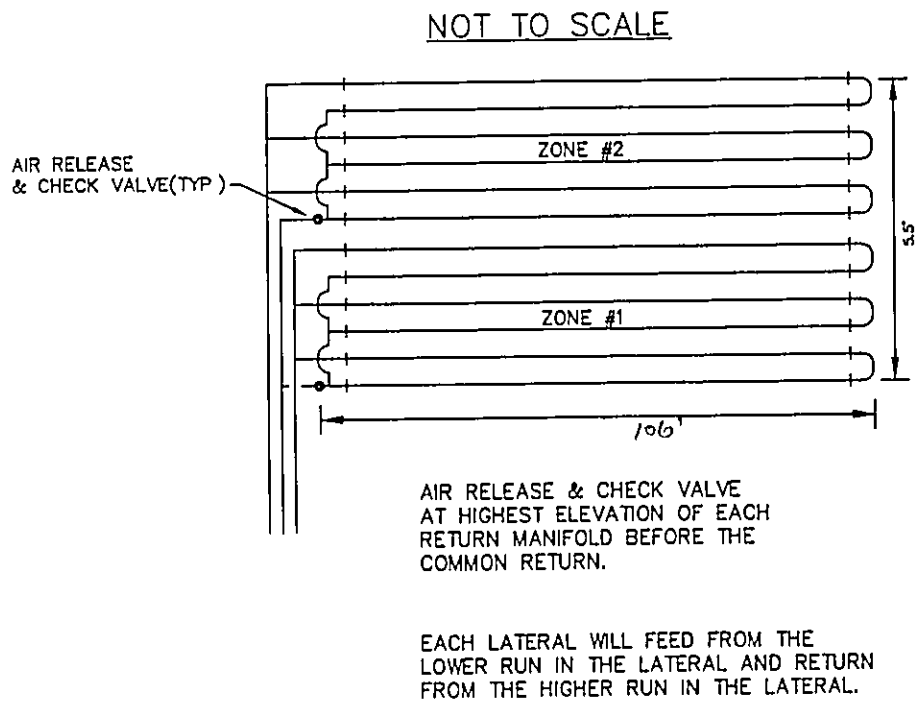
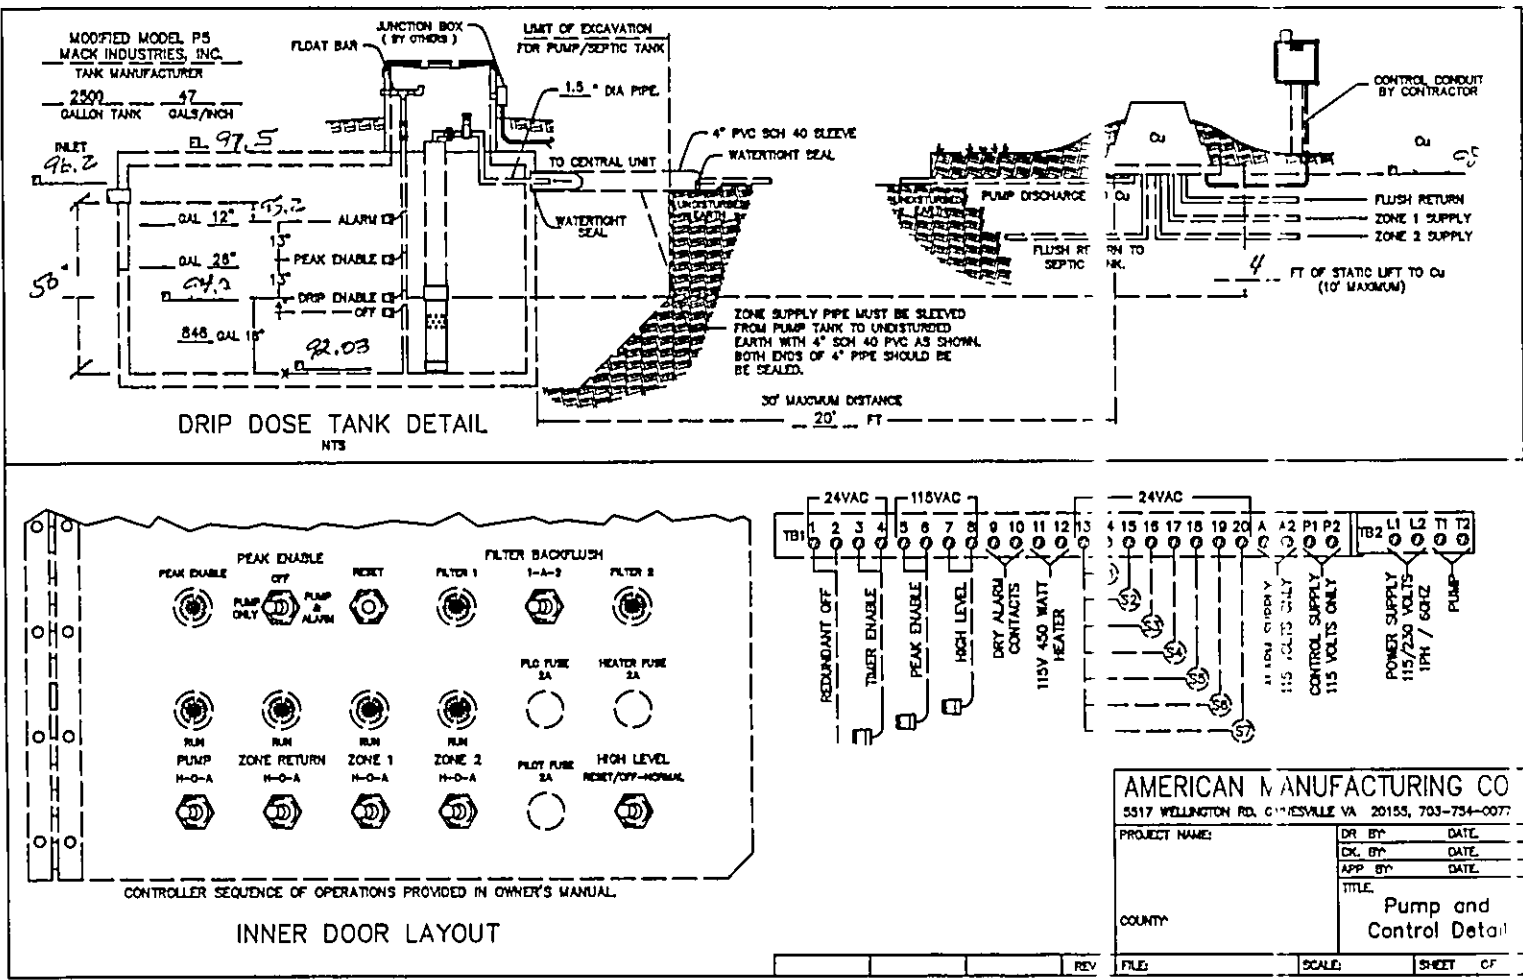
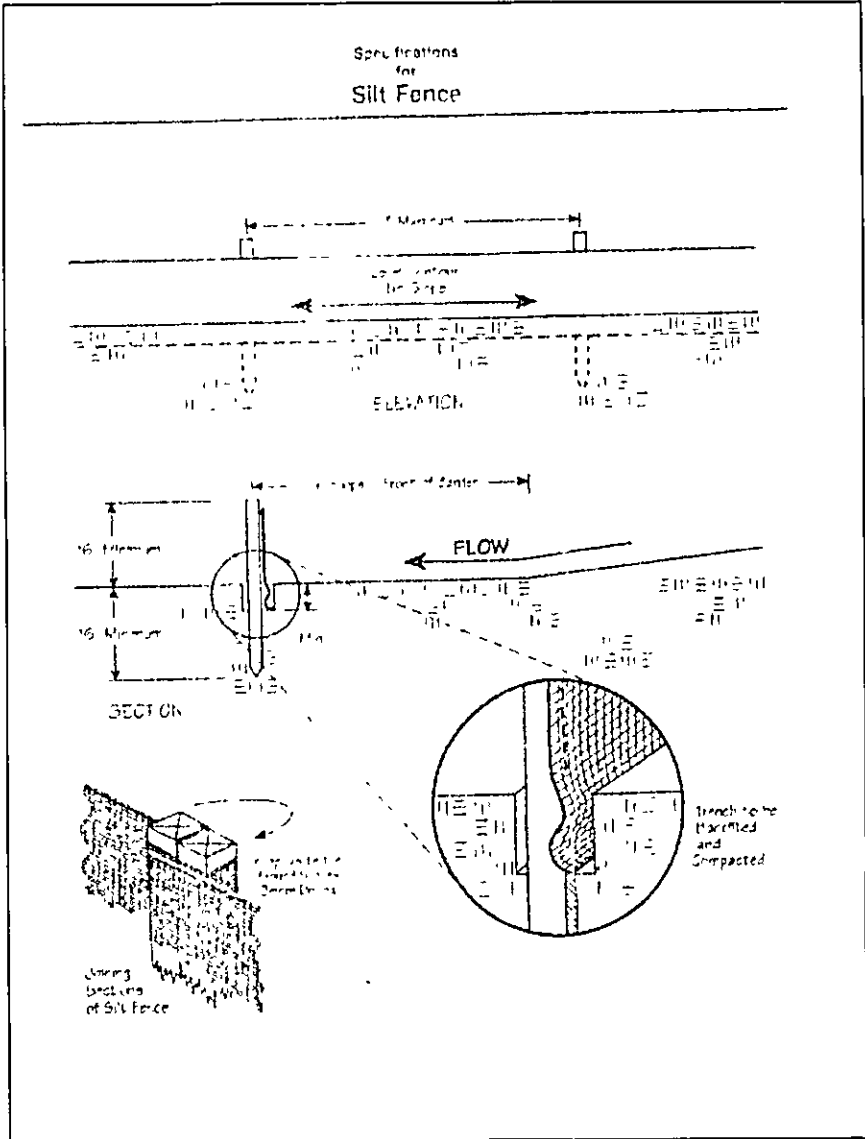
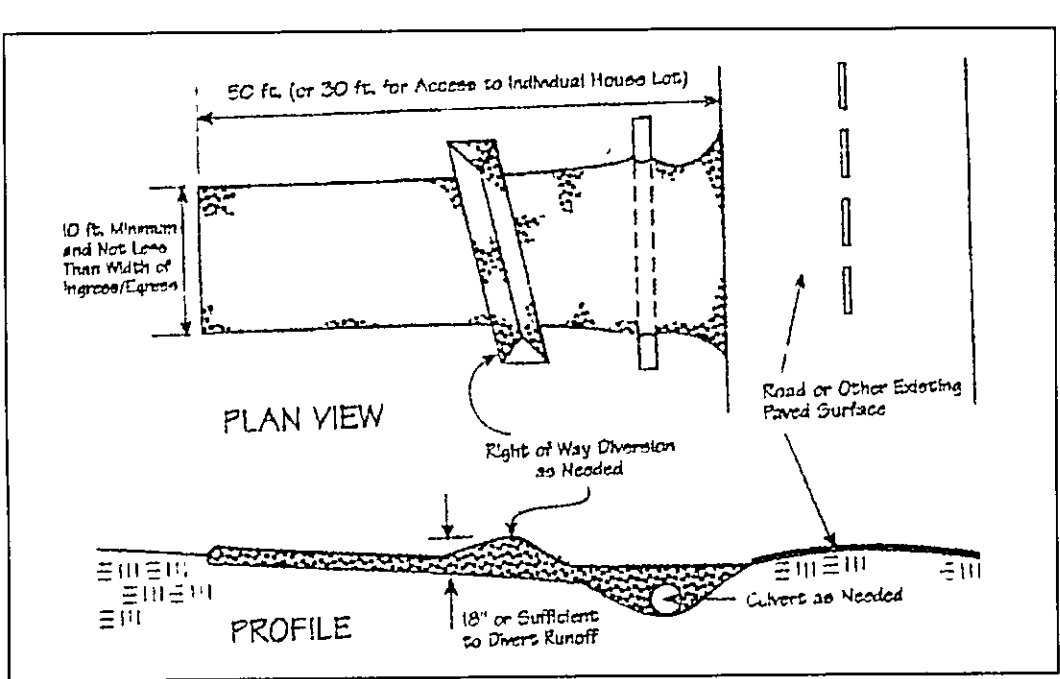


Temporary Seeding Species Selection			
Seeding Dates	Species	Lb / 1,000 ft. ²	Per Ac
March 1 to August 15	Oats	3	4 bushel
	Tall Fescue	1	40 lb.
	Annual Ryegrass	1	40 lb.
	Perennial Ryegrass	1	40 lb.
August 16 to November 1	Rye	3	2 bushel
	Tall Fescue	1	40 lb.
	Annual Ryegrass	1	40 lb.
	Perennial Ryegrass	1	40 lb.
November 1 to Spring Seeding	Wheat	3	2 bushel
	Tall Fescue	1	40 lb.
	Annual Ryegrass	1	40 lb.
	Perennial Ryegrass	1	40 lb.
Note: Other approved seed species may be substituted.			

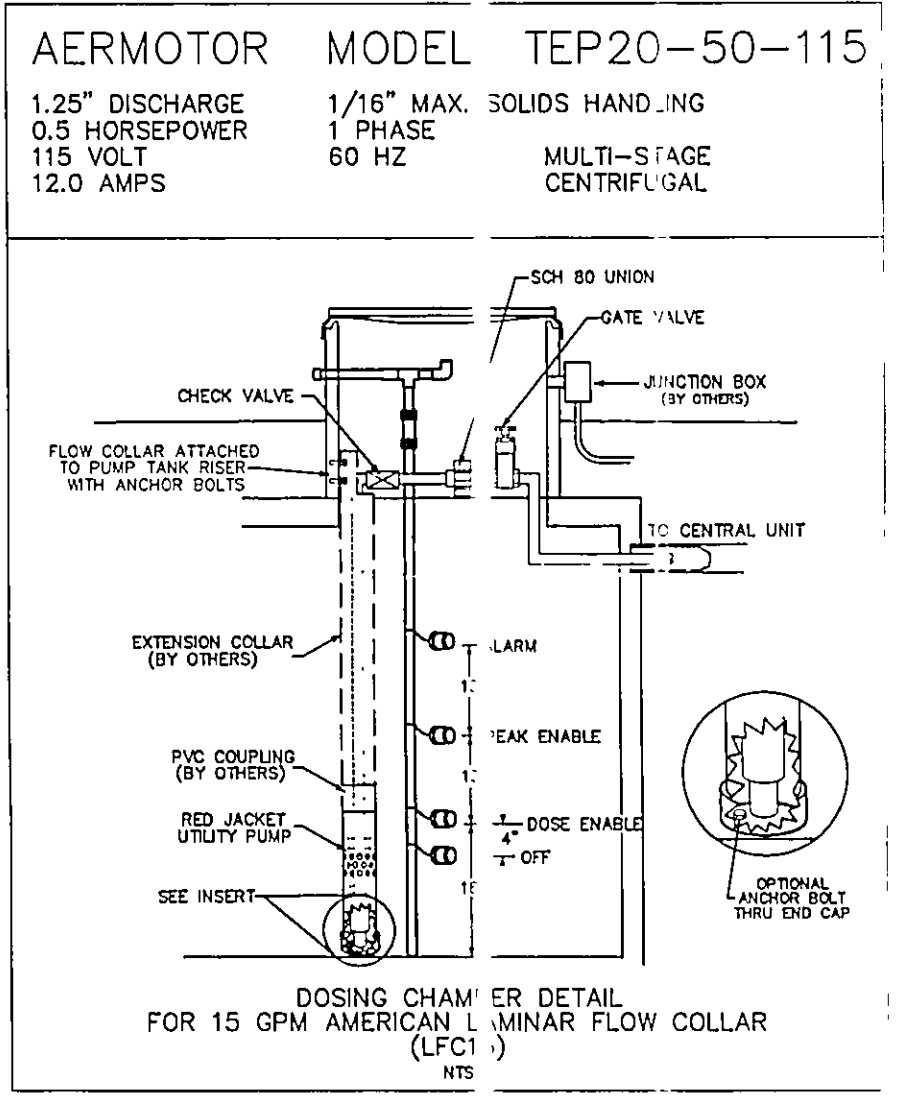

"I CERTIFY THIS SEWAGE SYSTEM DESIGN MEETS THE MINIMUM REQUIREMENTS ESTABLISHED BY THE LCGHD IN THE HSTS GUIDANCE MANUAL, AND THE REQUIREMENTS AND RECOMMENDATIONS OF THE SYSTEM MANUFACTURER."

Name William J. Pitt Reg. No. 16343

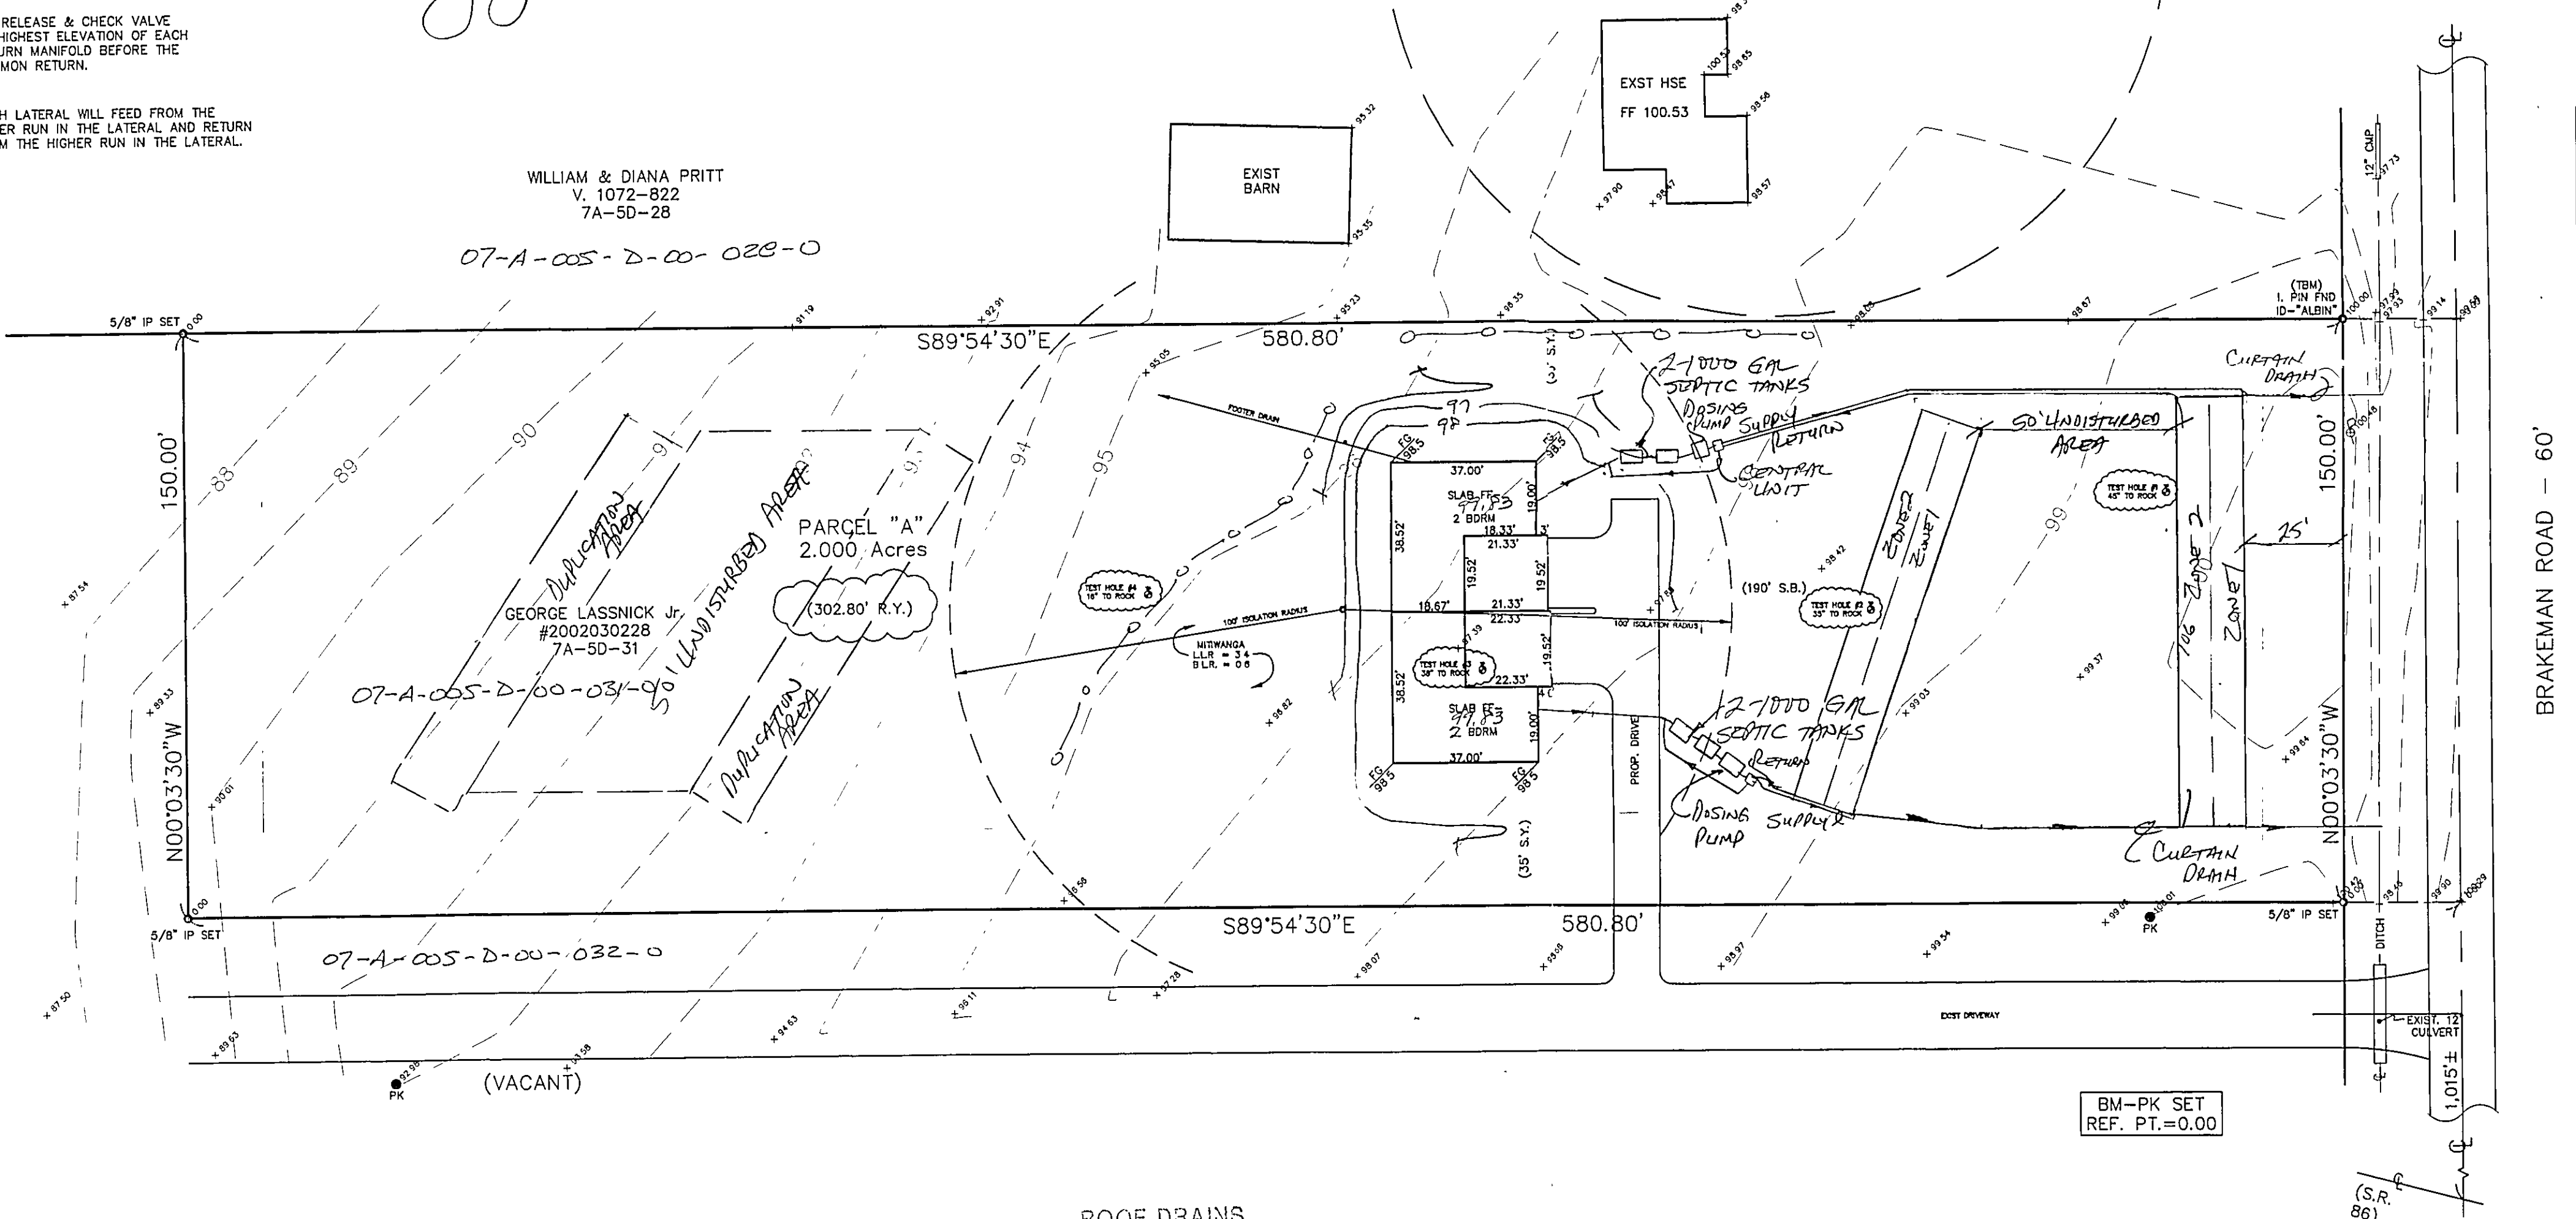

"I, the undersigned hereby certify that this topography indicated by 6", 1", or 2" contours, and elevations shown hereon represent an actual field survey made by me on the 28th day of March 2004, and that the elevations are taken at appropriate intervals and that as of that date they existed as indicated hereon."

Name William J. Pitt Reg. No. 16343

TBM - TOP OF IRON PIN @ N.E. CORN R
ELEV - 100.00

LLR = 24 $\frac{240}{2.4} = 100'$ MOUND. 100' + 3' + 3' = 106' LONG x 17.7' WIDE.
40' to ROCK - IN FRONT

ROOF DRAINS SHALL DISCHARGE TO SPLASH BLOCKS.

Stormwater Management Plan
Approved as shown and/or noted
JAMES R. GILLIS, P.E.
County Drainage Engineer
By L.S. Date 8/17/04

DESCRIPTION	DATE	BY	CHK'D
ADDED BUILDINGS	4/4/02	B.P.	H.J.
ADDED MOUND SYSTEMS	7/16/02	H.J.	H.J.
REVISED SEPTIC	7/19/02	H.J.	H.J.
REVISED SEPTIC	1/21/03	H.J.	H.J.
REVISED DUPLEX	4/17/04	N.S.	H.J.

6	ADDED DRIP SEPTIC	6/22/04	117	117
7	Revised DRIP ZONES	6/22/04	117	117
8	Revised	8/2/04	117	117
9		8/10/04	117	117

bj BABCOCK, JONES AND ASSOCIATES, INC
CIVIL ENGINEERS - SURVEYORS - LAND PLANNERS
PAINESVILLE OHIO 44077

DATE	3/26/02
DESIGN BY	H.J.
DRAWN BY	B.P.
APPROVED BY	H.J.

SITE PLAN
FOR
GEORGE LASSNICK
LEROY TOWNSHIP LAKE COUNTY STATE OF OHIO

SCALE	1" = 30'
JOB NO	00-018-
SHEET	OF
1	2

This project is exempt from
the project review
requirements of the
Ohio SWCD (17)

EXISTING UTILITIES NOTE:
THE SIZE AND LOCATION, BOTH HORIZONTAL AND VERTICAL, OF THE UNDERGROUND UTILITIES SHOWN HEREON, HAVE BEEN OBTAINED BY A SEARCH OF AVAILABLE RECORDS. VERIFICATION BY FIELD OBSERVATION HAS BEEN CONDUCTED WHERE PRACTICAL, HOWEVER, BABCOCK, JONES AND ASSOCIATES, INC. DOES NOT GUARANTEE THE COMPLETENESS OR ACCURACY THEREOF.

