


LEROY TOWNSHIP



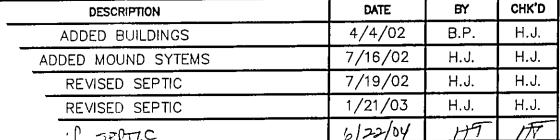

BABCOCK, JONES AND ASSOCIATES, INC

CIVIL ENGINEERS - SURVEYORS - LAND PLANNERS

PAINESVILLE OHIO 44077

DAIL	3/26/02	Ì
DESIGN BY	H.J.	
DRAY/N BY	B.P.	
APPROVED BY	H.J.	

SITE PLAN FOR GEORGE LASSNICK

LAKE COUNTY

SCALE NO E

JOB NO 02- 018
SHEET 0F

2 2

STATE OF OHIO