




|           |                       |                 |                          |       |          |                         |  |
|-----------|-----------------------|-----------------|--------------------------|-------|----------|-------------------------|--|
| SHEET NO. | MIKE & CHRISTY HERMAN | TITLE           | SITE PLAN<br>CARTER ROAD | DATE  | 10/18/62 | REVISIONS               |  |
| DWG. NO.  |                       | LERROY TOWNSHIP | LAKE COUNTY              | DATE  |          | Revised Per Engineering |  |
|           |                       | DRAWN BY        | CHECKED BY               | SCALE |          |                         |  |

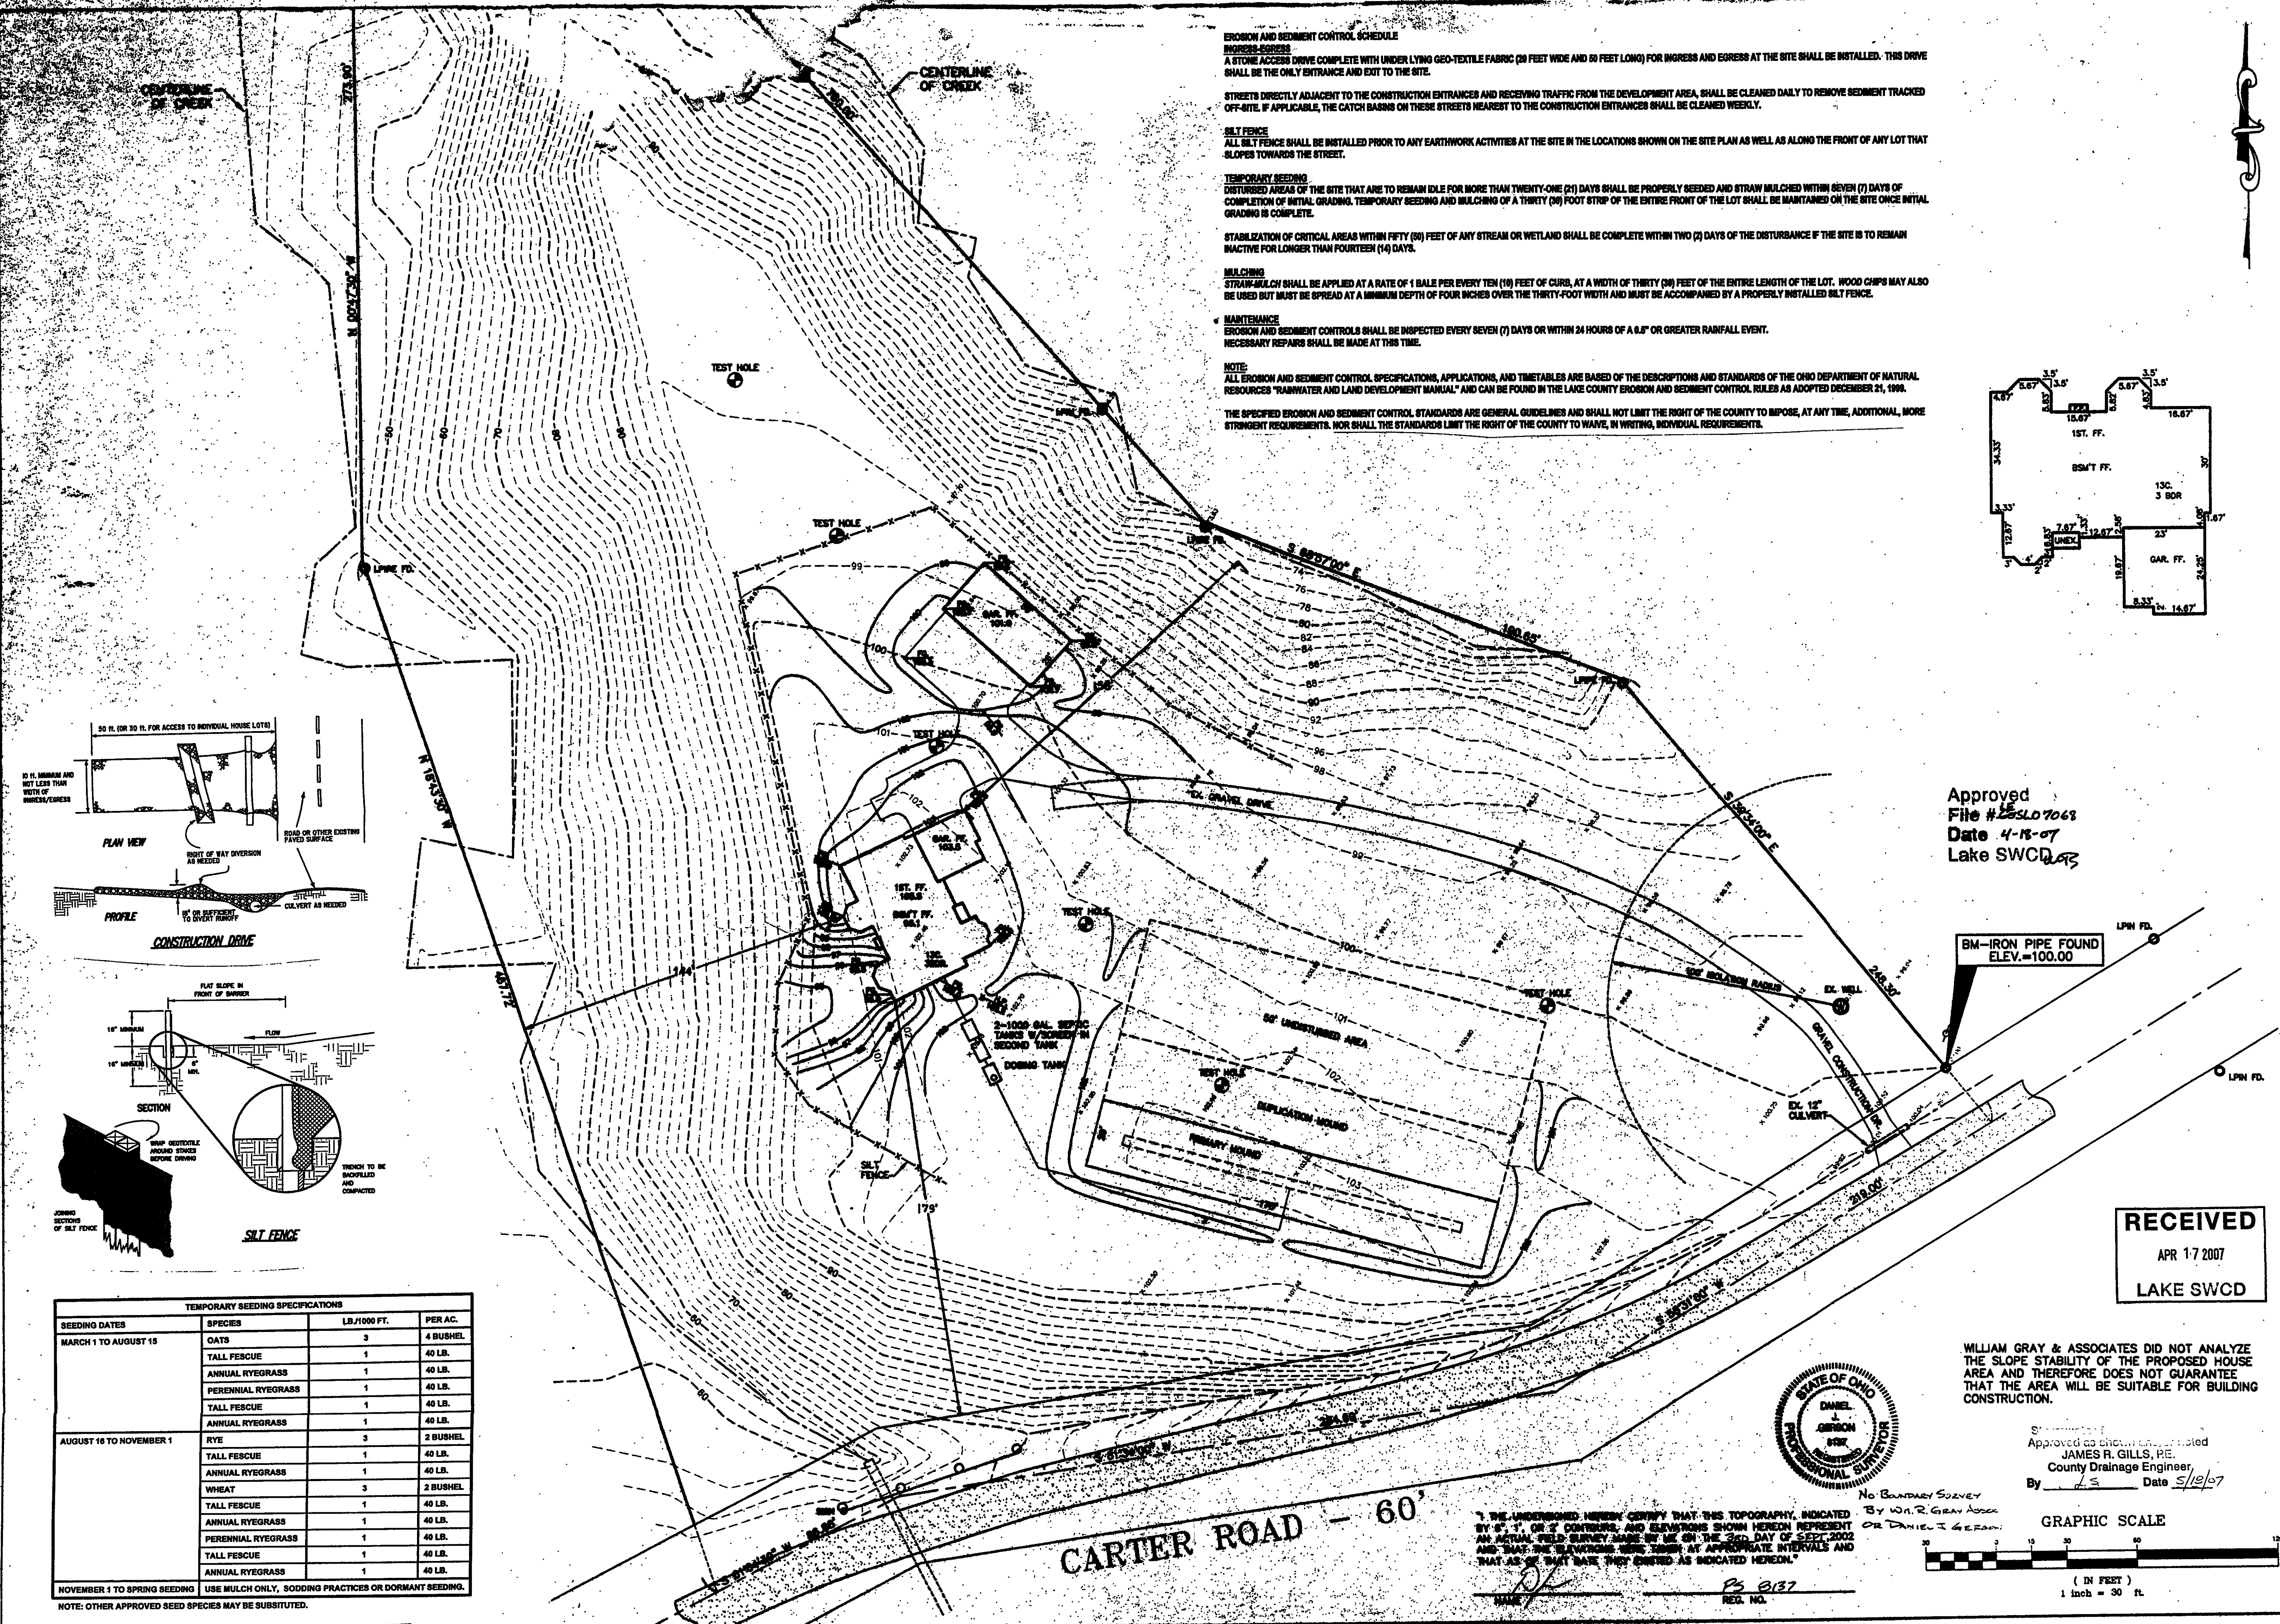

**WILLIAM R. GRAY ASSOCIATES, INC.**  
 7519 MENTOR AVE. MENTOR, OHIO 44060  
 (440) 946-1616