
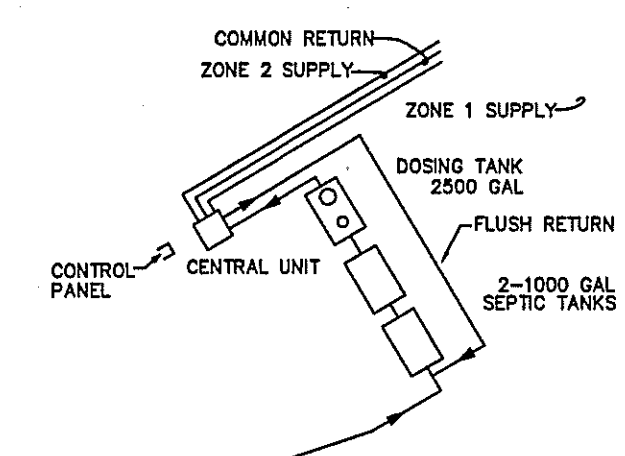
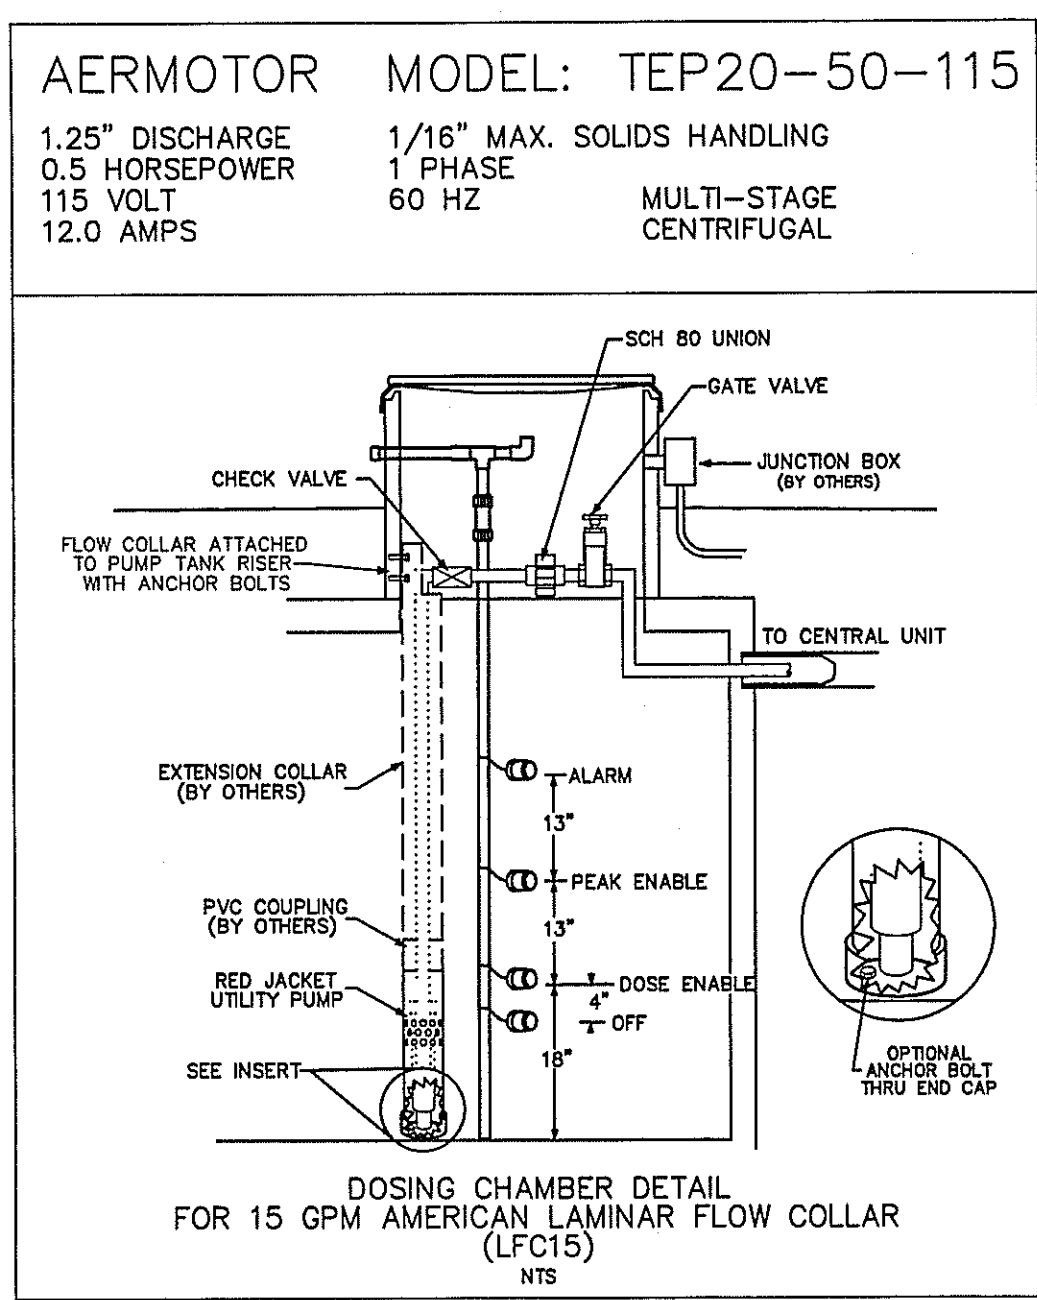



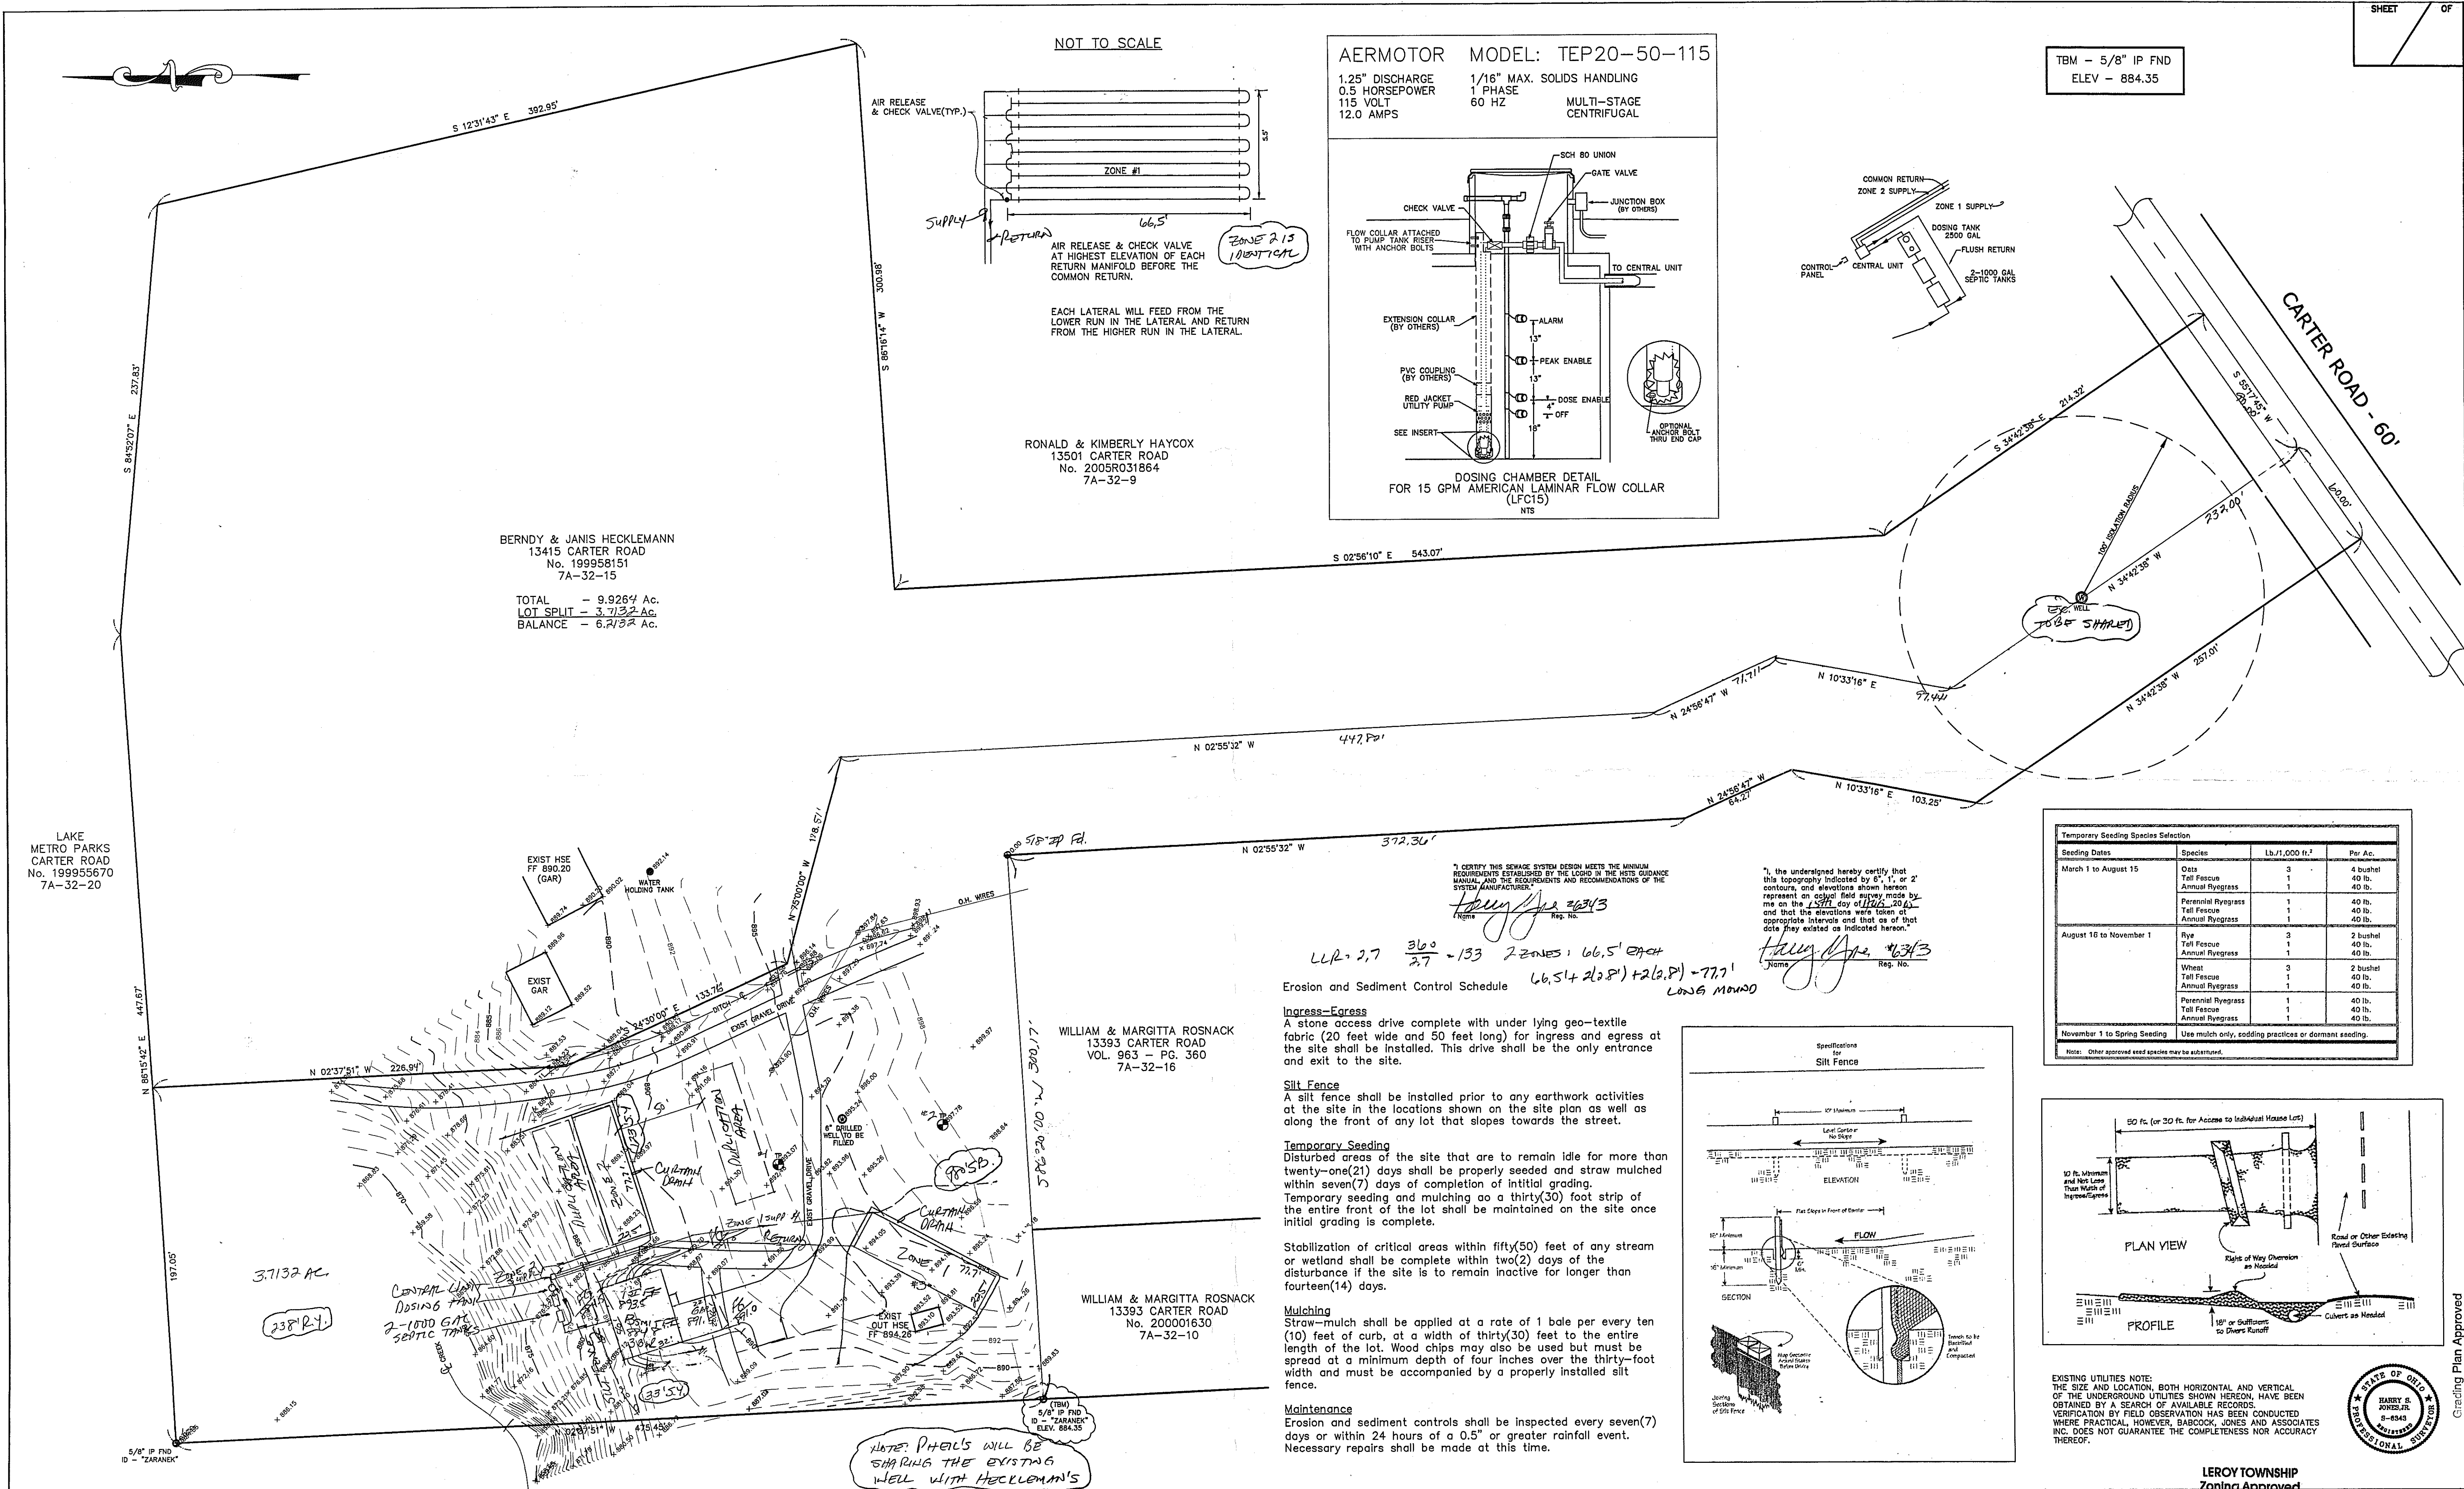


TBM - 5/8" IP FND
ELEV - 884.35

Temporary Seeding Species Selection

Seeding Dates	Species	Lb./1,000 ft. ²	Per Ac.
March 1 to August 15	Oats	3	4 bushel
	Tall Fescue	1	40 lb.
	Annual Ryegrass	1	40 lb.
	Perennial Ryegrass	1	40 lb.
August 16 to November 1	Rye	3	2 bushel
	Tall Fescue	1	40 lb.
	Annual Ryegrass	1	40 lb.
	Wheat	3	2 bushel
November 1 to Spring Seeding	Tall Fescue	1	40 lb.
	Annual Ryegrass	1	40 lb.
	Perennial Ryegrass	1	40 lb.
	Wheat	3	2 bushel

Note: Other approved seed species may be substituted.

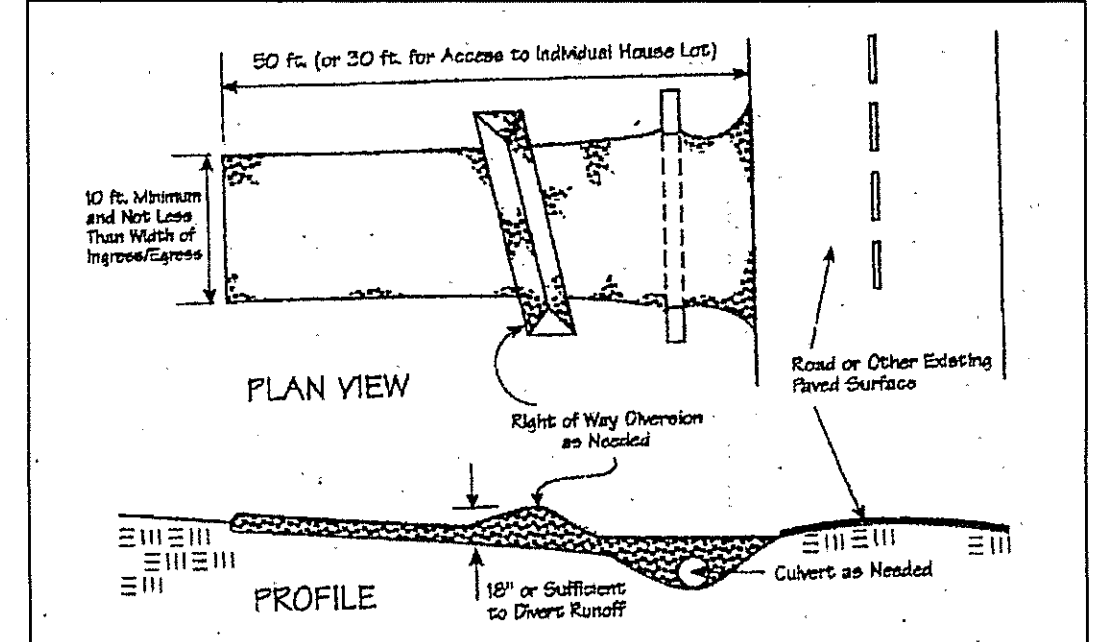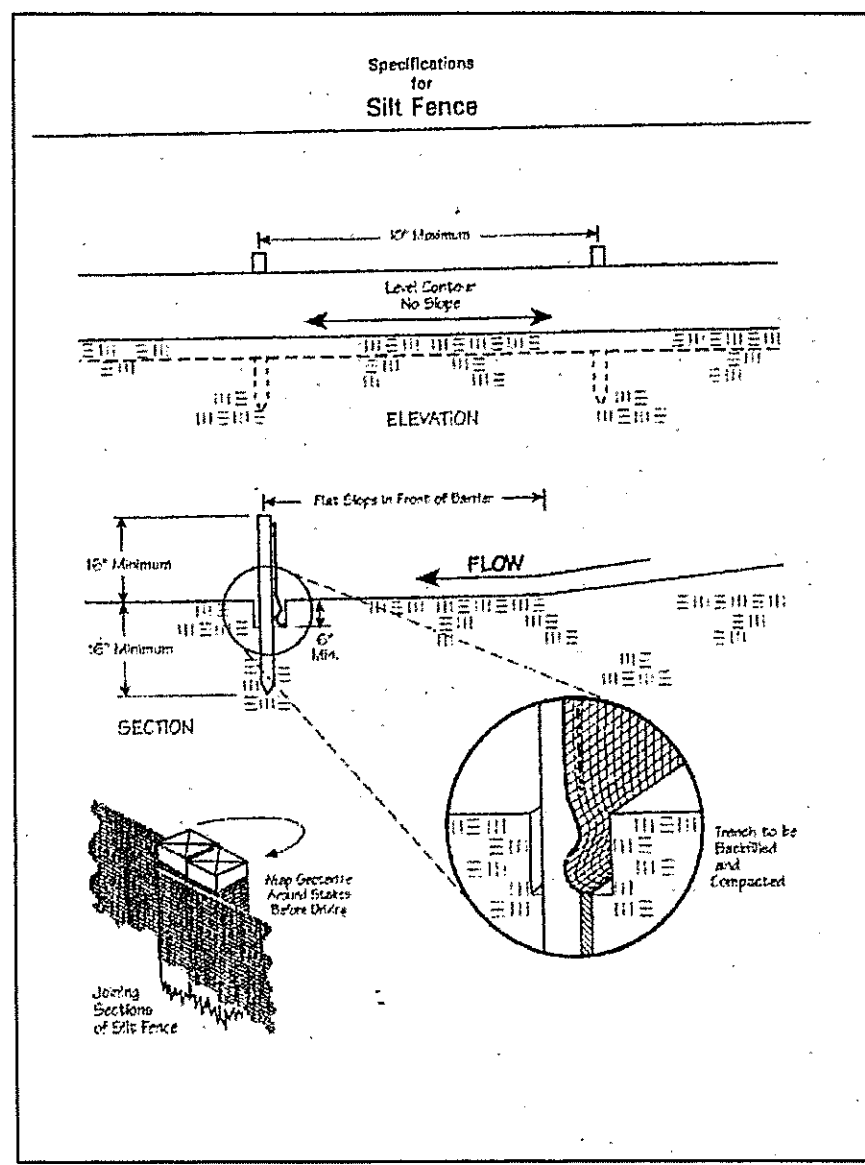

EXISTING UTILITIES NOTE:
THE SIZE AND LOCATION, BOTH HORIZONTAL AND VERTICAL OF THE UNDERGROUND UTILITIES SHOWN HEREON, HAVE BEEN OBTAINED BY A SEARCH OF AVAILABLE RECORDS. VERIFICATION BY FIELD OBSERVATION HAS BEEN CONDUCTED WHERE PRACTICAL. HOWEVER, BABCOCK, JONES AND ASSOCIATES, INC. DOES NOT GUARANTEE THE COMPLETENESS NOR ACCURACY THEREOF.



REVISIONS

REV. NO.	DESCRIPTION	DATE	BY	CHK'D
1	CHANGES SEPTIC SYS. TO MOUND SYS.	11/11/05	B.P.	H.J.
2	REVISION ZONE 2	12/01/05	H.J.	H.J.
3	REVISION PER STAMBEY	12/9/05	H.J.	H.J.
4	REVISION HOUSE	5/18/06	H.J.	H.J.
5	REVISION LOT DIMENSIONS	6/7/06	H.J.	H.J.

babcock, jones and associates, inc.
CIVIL ENGINEERS - SURVEYORS - LAND PLANNERS
PAINESVILLE OHIO 44077

DATE 9/6/05
DESIGN BY H.J.
DRAWN BY B.P.
APPROVED BY H.J.
CREW CHIEF W.B.

LEROY TOWNSHIP Zoning Approved

SITE PLAN FOR SAMANTHA PHEIL
CARTER ROAD (P.P.# 7A-32-15)
LAKE COUNTY OHIO

SCALE 1"=40'
JOB NO 05-177
SHEET 1 OF 2