

JAMES J. GREGORY J. MONTE
VOL. 343, PL. 1137


5/1 43
VACANT
LOW YIELD WATER
FIXTURES REQUIRED
ON ALL:

Shower, Head
Toilet

- A. To be brought to finished grade
1. Septic tank manhole covers
2. Splitter box cover
3. Distribution box cover
- B. No footer drains or downspouts
1. To be discharged into septic tanks
2. All waste water to be discharged into septic tanks


RONALD & LISA HARTMAN
VOL. 228, PG. 904

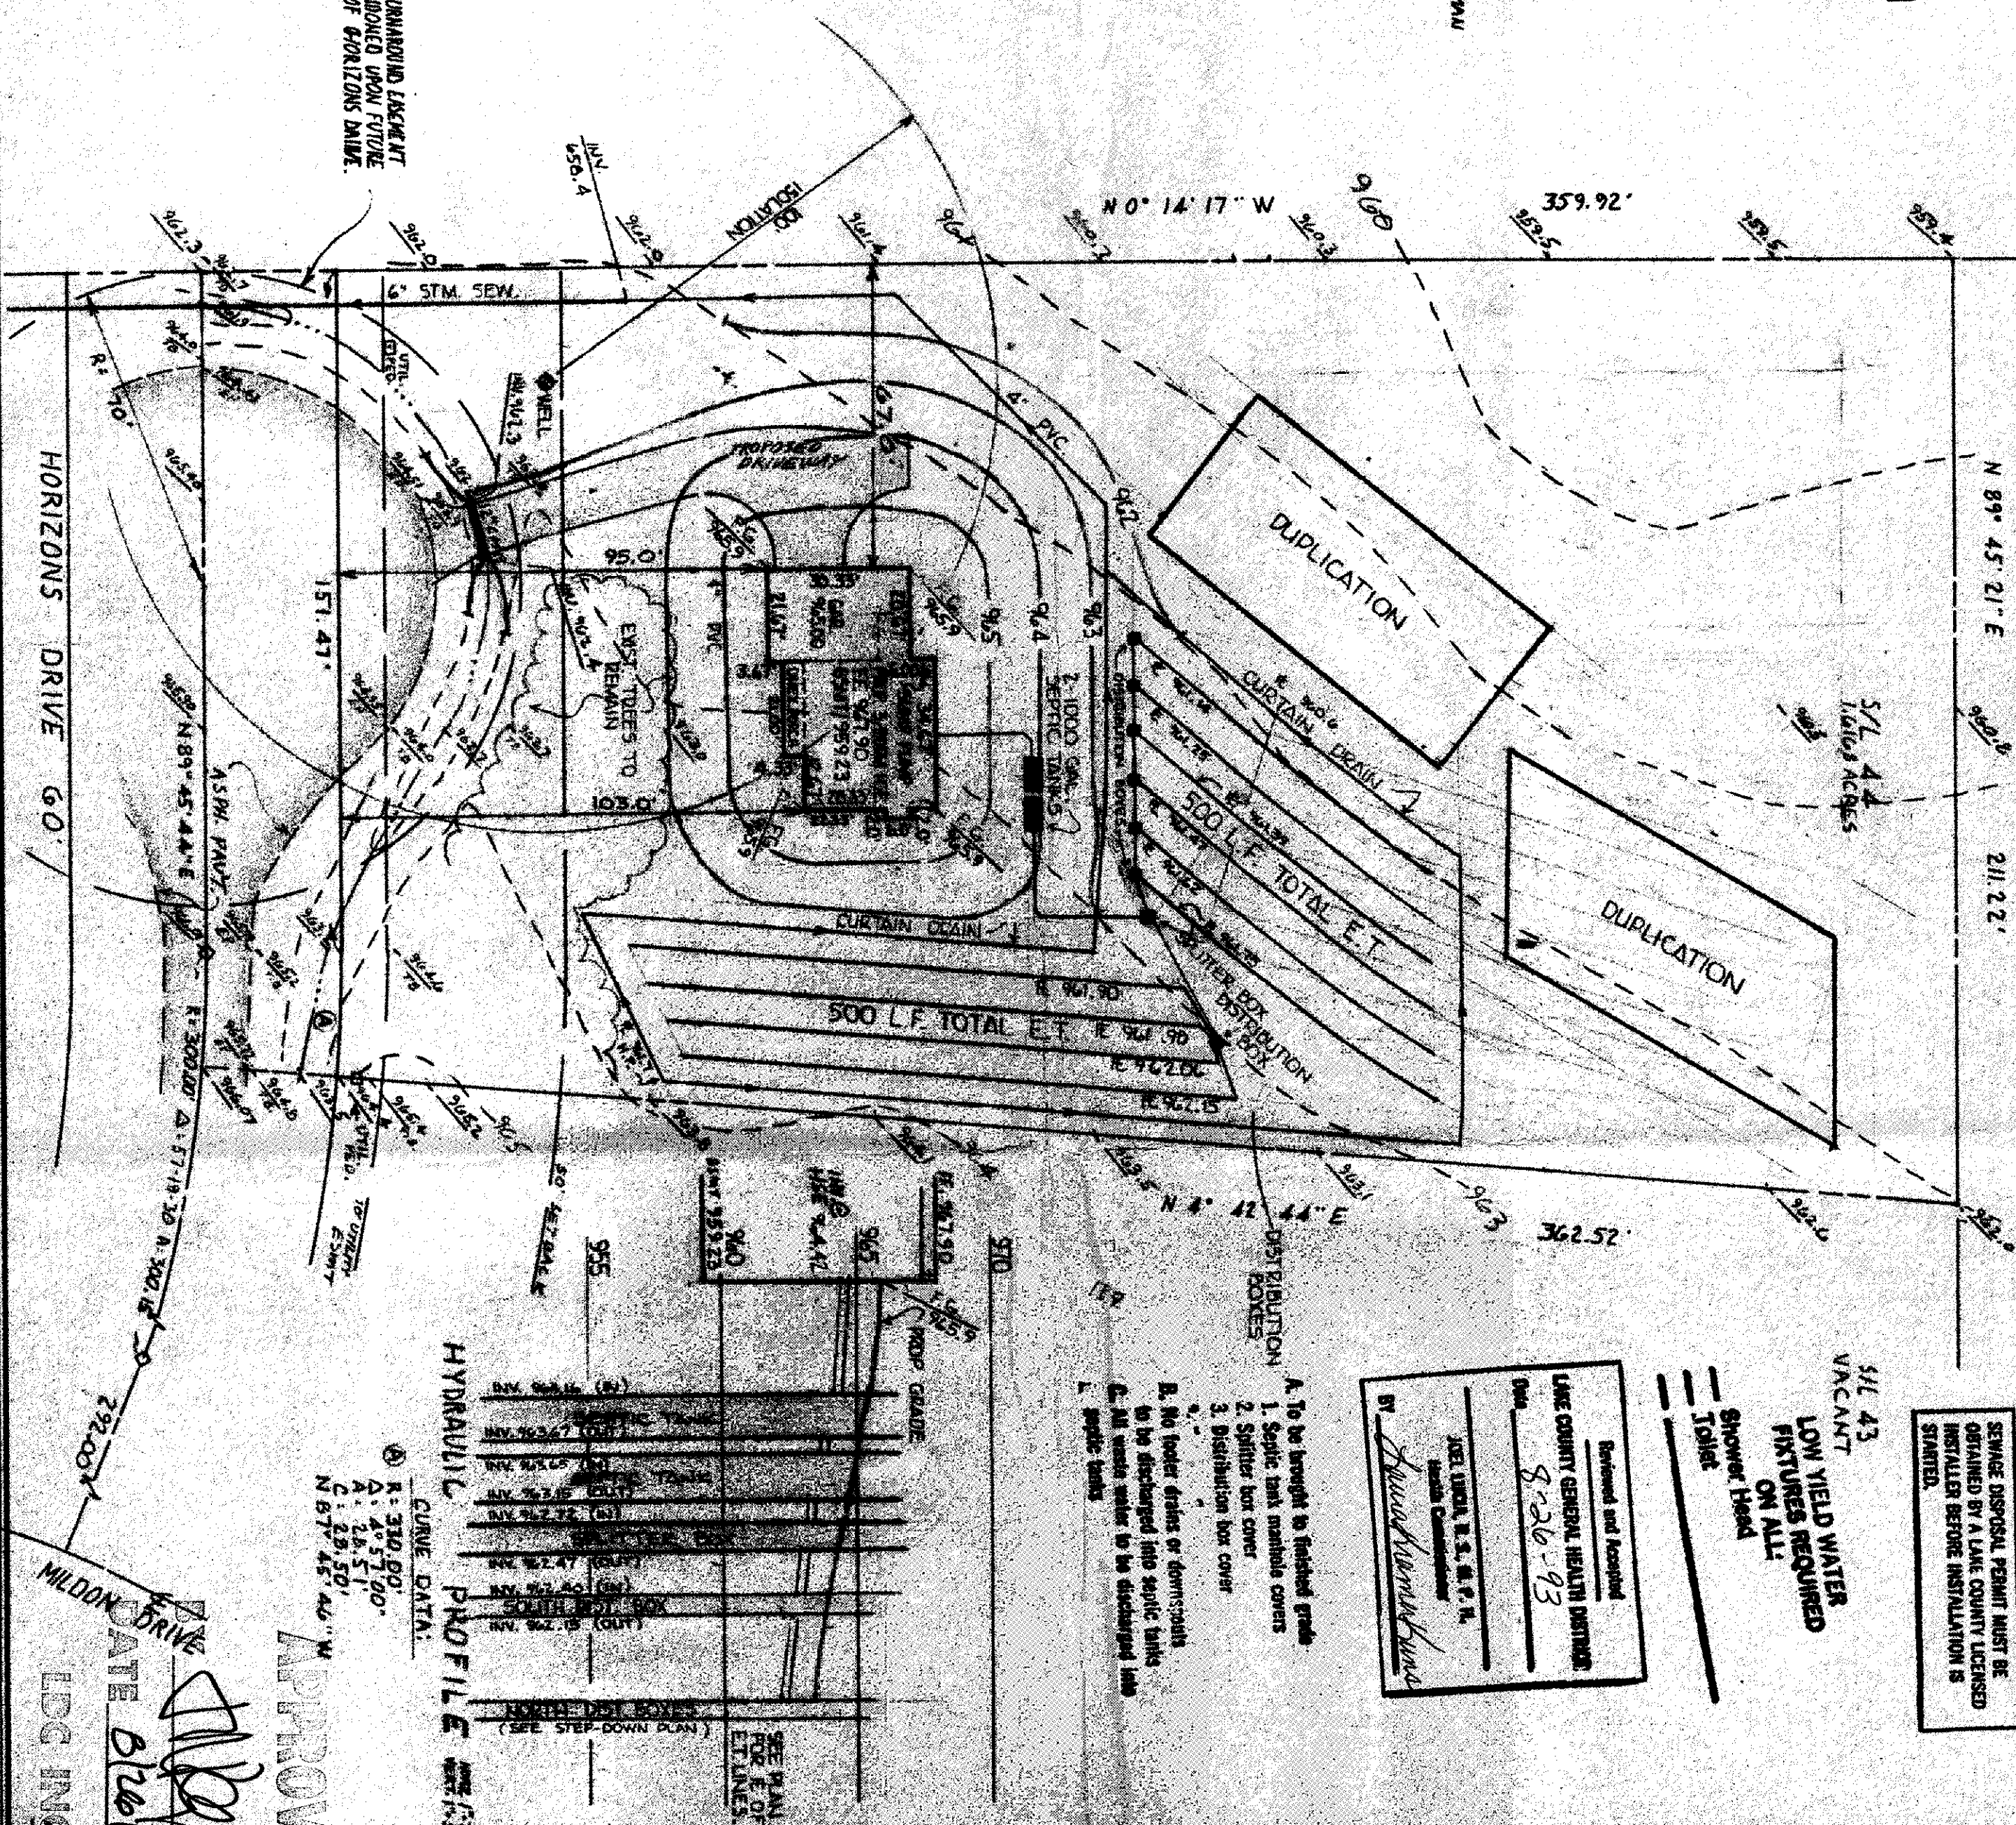

YERGEN

DATE 8/20/93

UNION

ROOF DRAINS SHALL DISCHARGE TO SPLASH BLOCK

93-130

for : BILL JOHN 50 M **client**

11785 ARBOR GLEN CHARDON
ADDRESS STREET CITY

44
SUBDIVISION NAME
VOL. PAGE

LOT, TRACT




DESIGN CERTIFICATION

THIS PLAT WAS PREPARED BY ME, AND IS CORRECT TO THE
BEST OF MY KNOWLEDGE AND BELIEF.

11

CHECK LIST

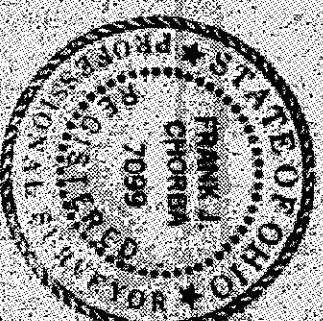[illegible]

STATISTICS

"AS BUILT" CERTIFICATION

I HEREBY CERTIFY THAT THE CIRCLED INFORMATION IS EXISTING AS OBTAINED ON THE SITE 19 AND IS CORRECT TO THE BEST OF MY KNOWLEDGE AND BELIEF.

11


415 / JBZ 1st = 30'

STORM MARKOLE	/	DATE
SANITARY MARKOLE EXISTING CONTOURS		AUG/ST 1993

100.0 PROP. ELEV.

**DIRECTION OF
SURFACE DRAINAGE**

ACCEPTED

CLIENT _____ DATE _____

**BENCHMARK: NAIL IN TREE @ E. E. MILDON & HORIZONS
ELEV. 974.00**

**Grading Plan Approved
as shown and/or noted**

THOMAS P. GILLES, P.E.
Lake County Engineer

By CH Date 9.7.93

ROOF DRAINS SHALL DISCHARGE