LEGEND:

- • IRON PIN OR PIPE FOUND OR SET
- EXISTING ELEVATION
- PROPOSED ELEVATION
- S ——→ PROPOSED FLOW

T.B.M. ELEVATION 100.00 USED
TOP OF HYDRANT AT RIM OF MANHOLE ACROSS STREET
FINISH FLOOR 105.63 BSMT. FLOOR 96.96
TOP FOOTER 96.63 GARAGE FLOOR 104.30
SAN. CONN. 90.5± STM. CONN. SUMP PUMP
AS BUILT FINISH FLOOR
AS BUILT GARAGE FLOOR
AS BUILT BASEMENT FLOOR

PLOT PLAN FOR SUBLOT 42

PERMANENT PARCEL No.
STREET ADDRESS LESTER DRIVE
IN THE SUNSHINE ACRES NO. 2 SUBDIVISION
IN THE CITY OF LEROY TWP. LAKE COUNTY OHIO
PREPARED FOR ED POLO CONSTRUCTION
DATE 4-4-94 SCALE 1" = 30'
AS BUILT DATE
AS BUILT ELEVATIONS (....)
SIDEWALKS AND APRONS (6" THICK AT DRIVEWAYS)
PROPOSED SWALES - - - - - - - - -

SCHADE SURVEYING COMPANY 951-6454
FB 65 JOB NO. 94-601-4 FJM

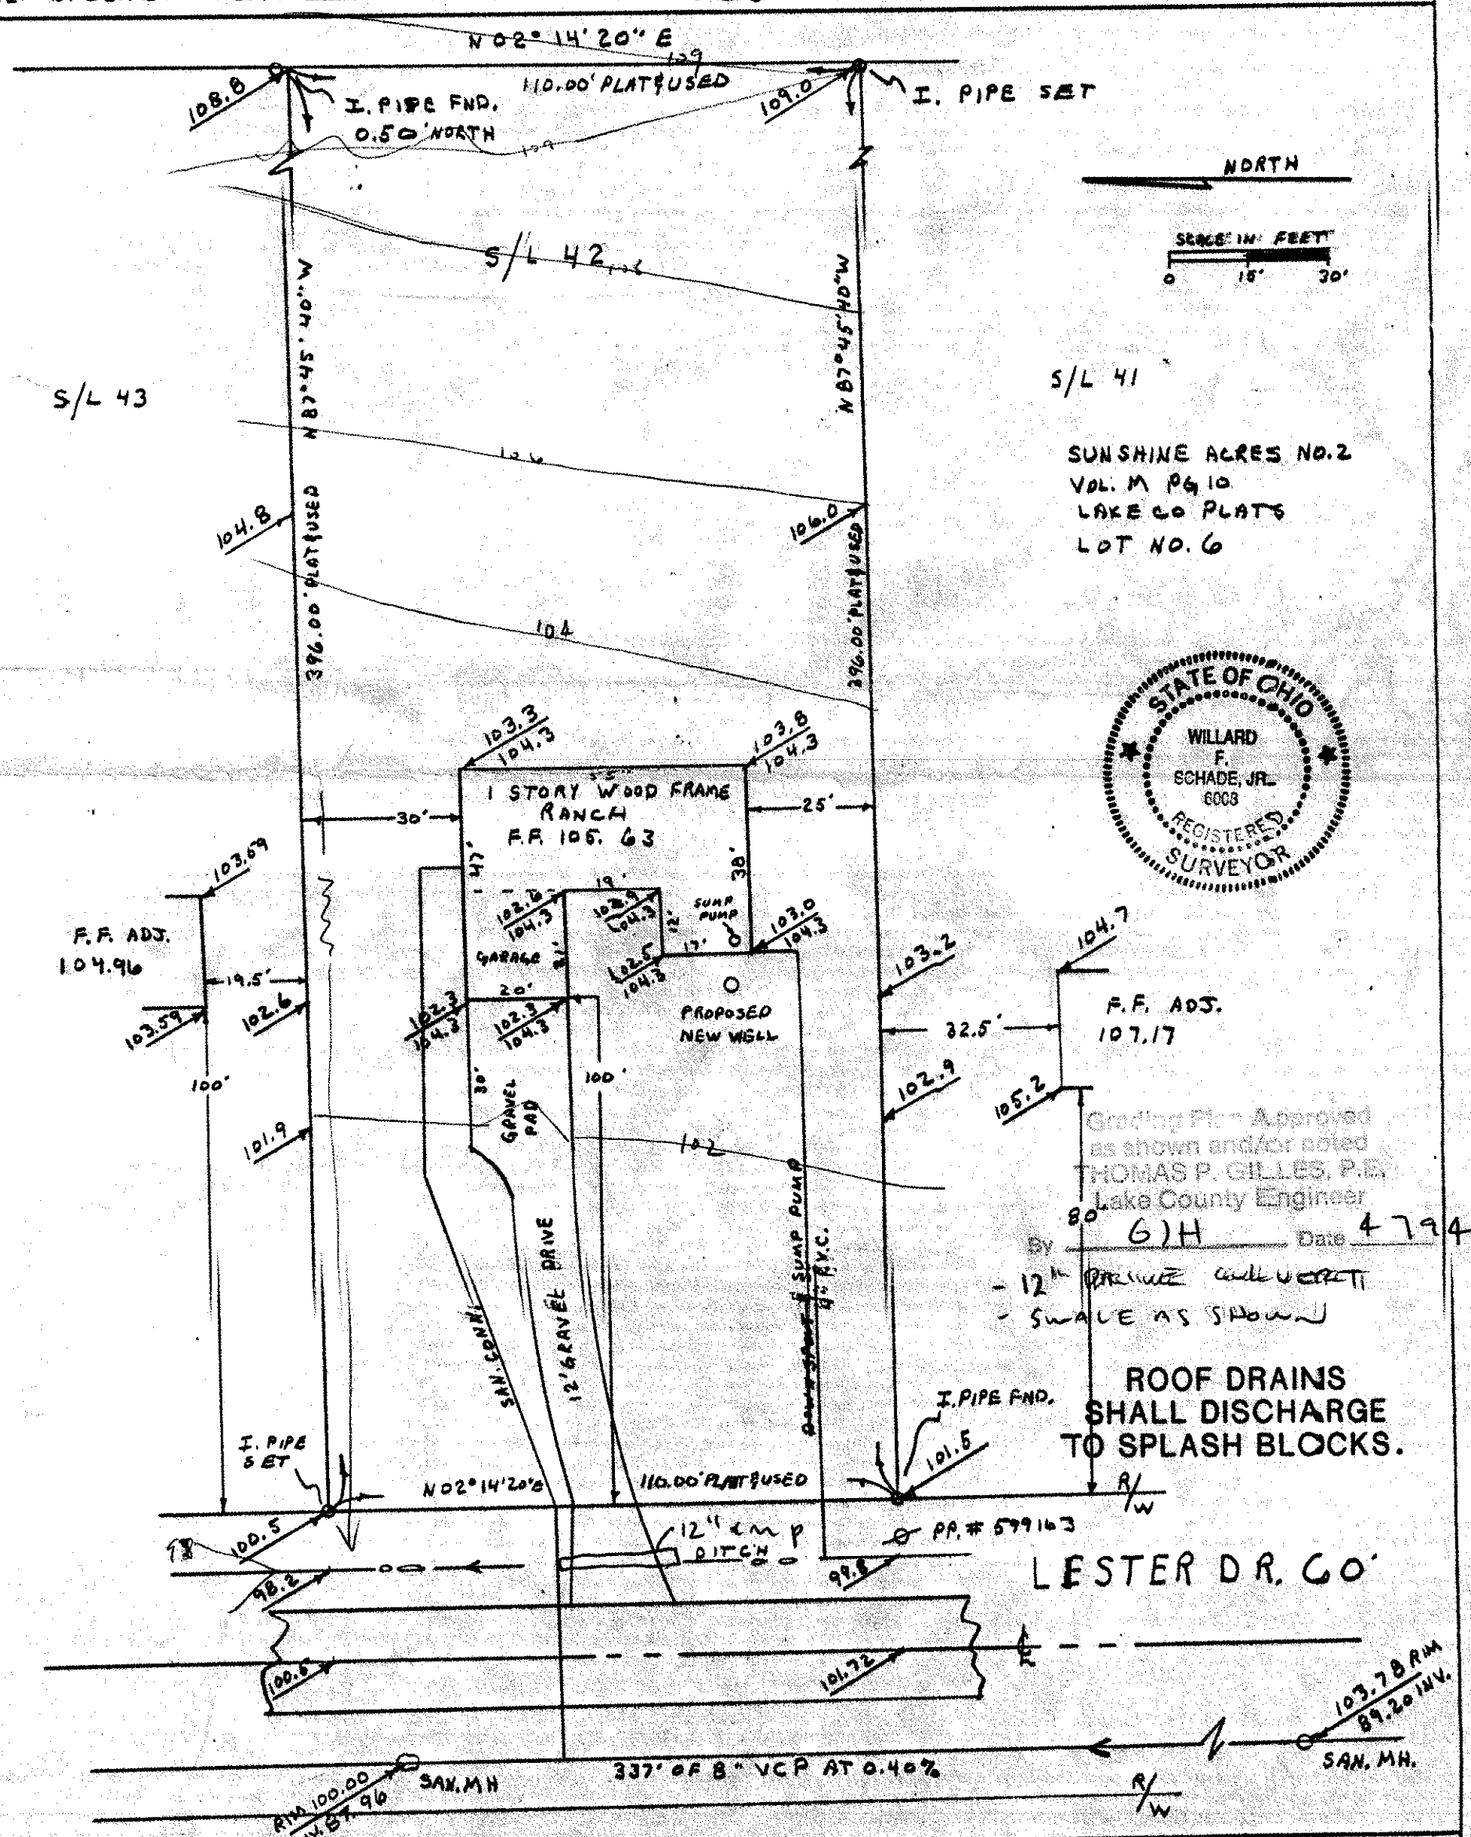

CERTIFICATION: DIMENSIONS ARE EXPRESSED IN FEET AND DECIMAL PARTS THERE OF MONUMENTS ARE AT POINTS SHOWN AND ARE CERTIFIED CORRECT

Willard F. Schade Jr.
WILLARD F. SCHADE REG. SURVEYOR 6008