



CURVE TABLE					
CURVE	LENGTH	RADIUS	DELTA	TANGENT	CHORD
C1	150.00	410.00	18°59'11"	75.77	149.24
C2	468.87	410.00	87°54'40"	265.56	442.48

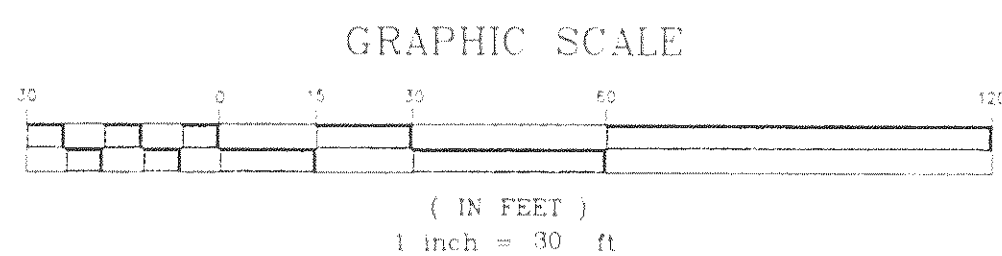

MONTE DRIVE 60'

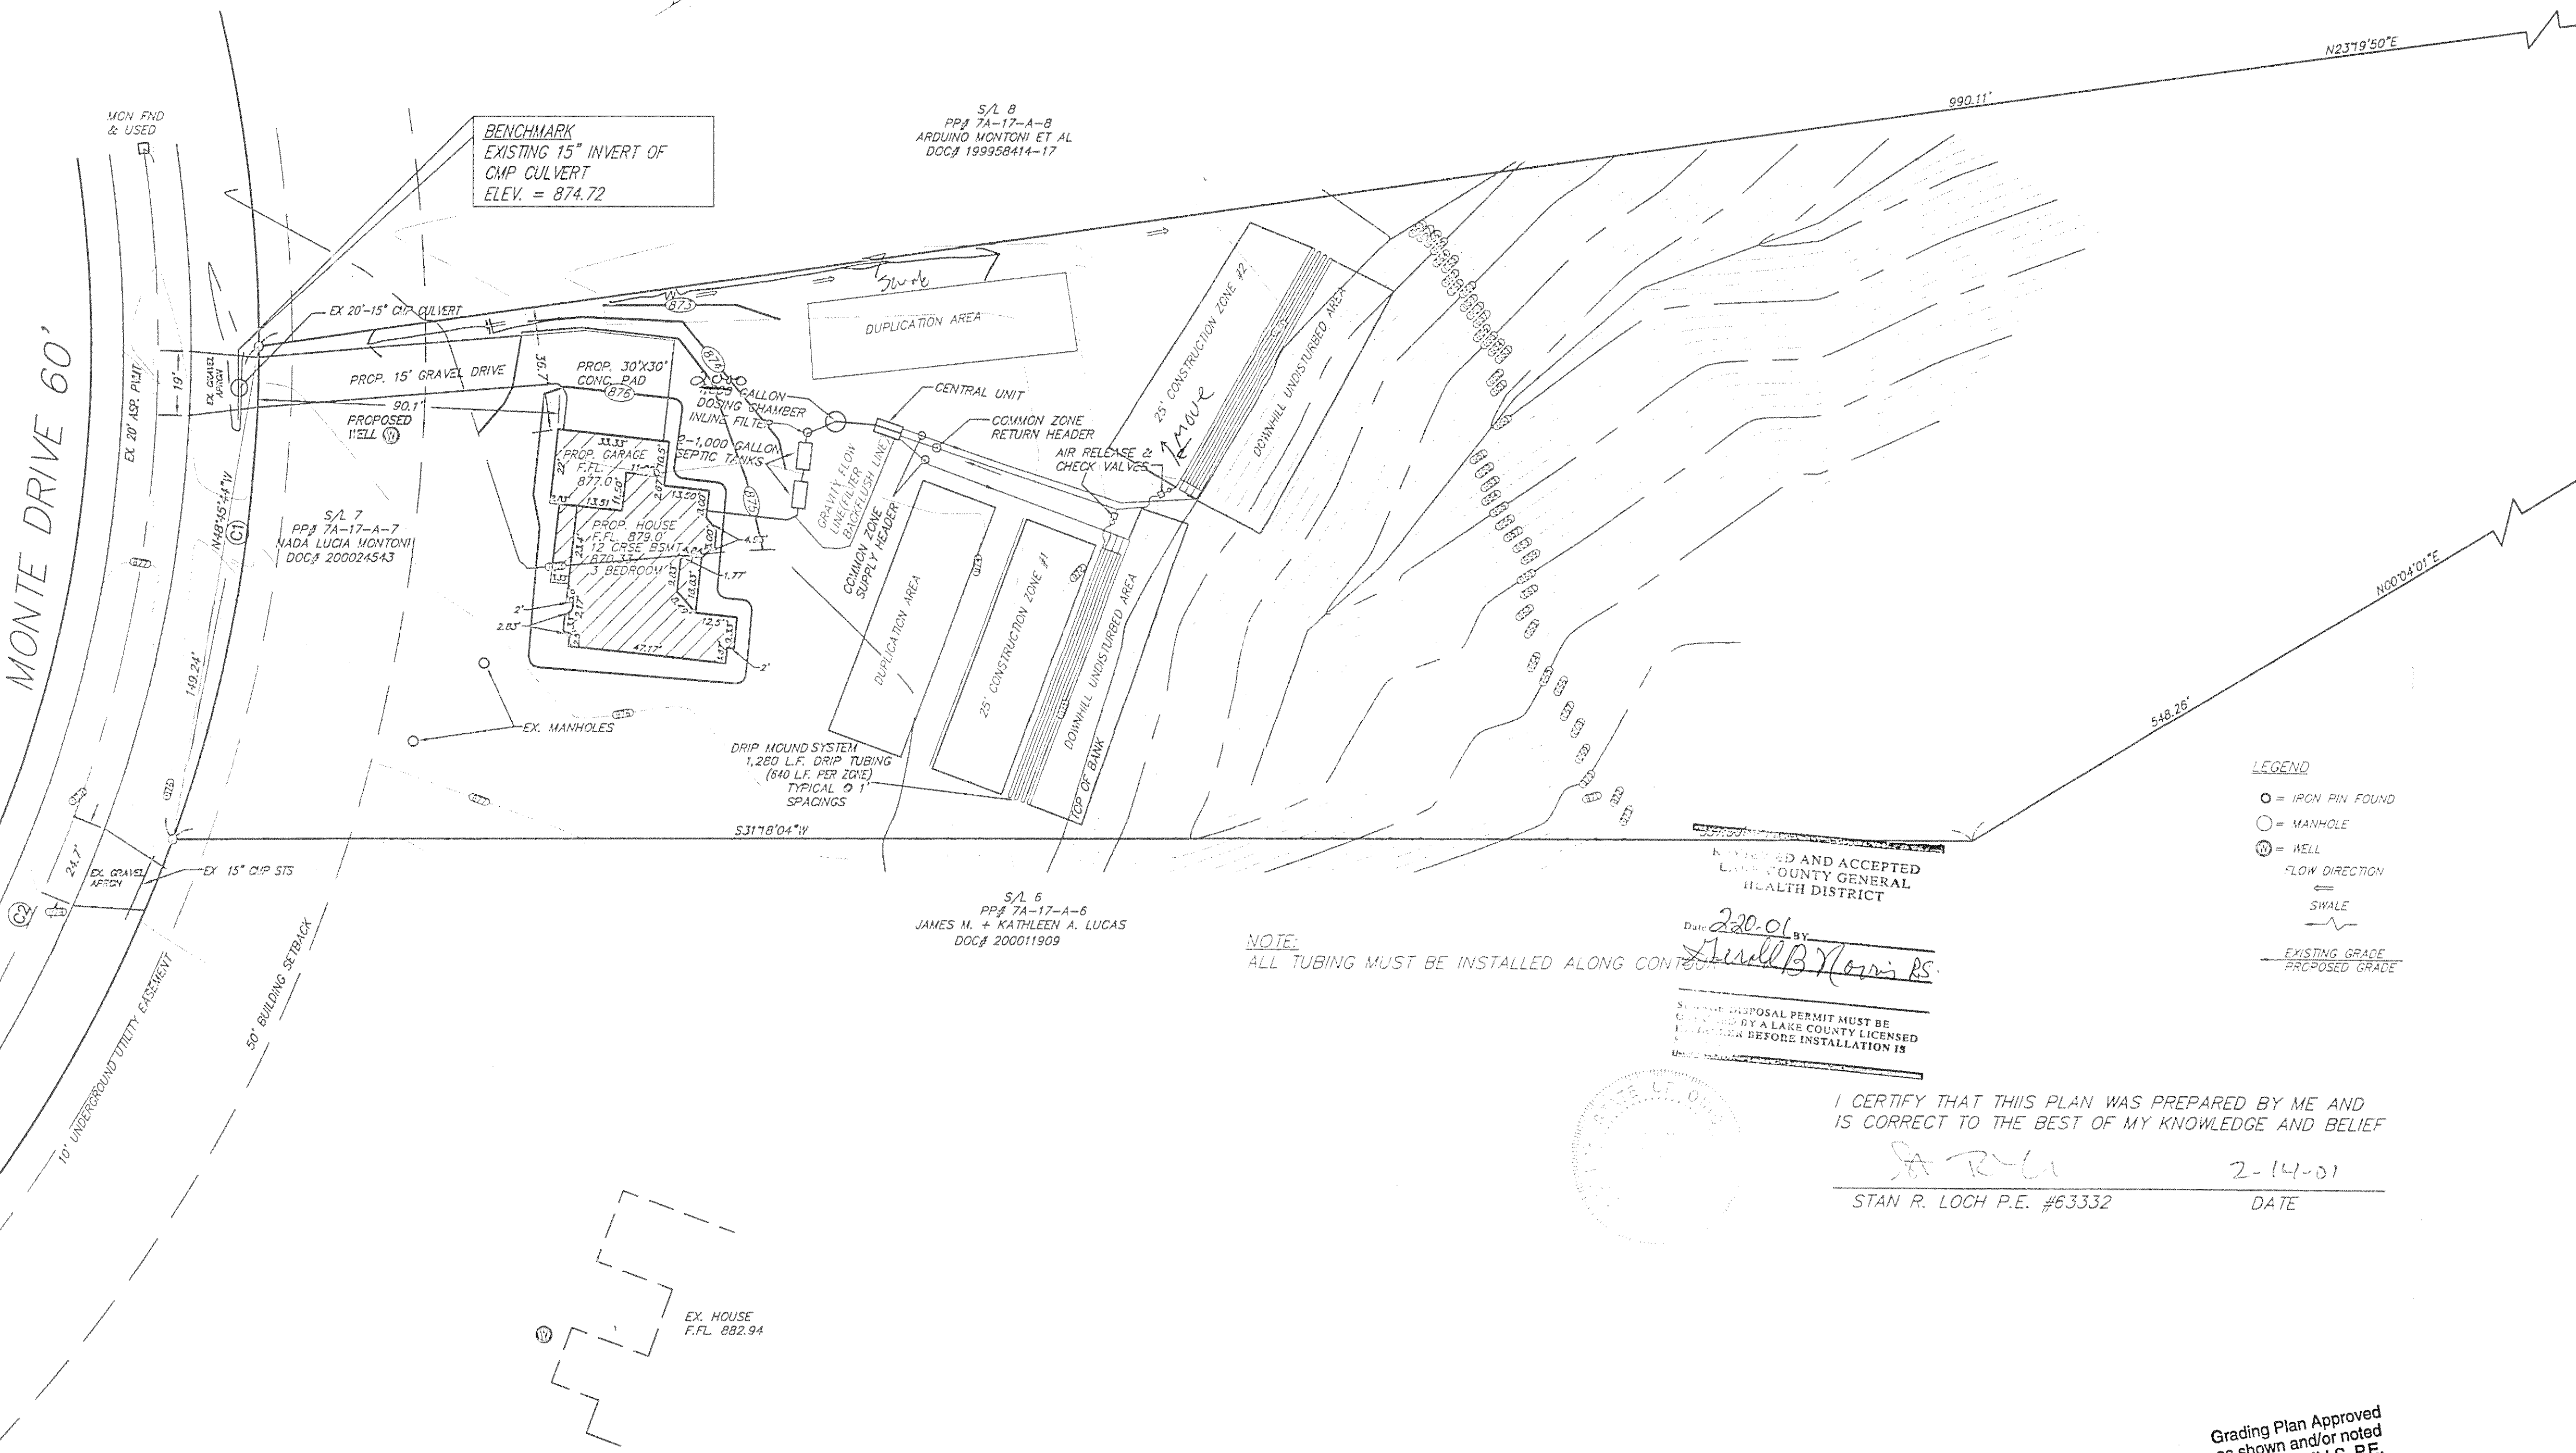


- LEGEND
- = IRON PIN FOUND
 - = MANHOLE
 - ⊙ = WELL
 - = FLOW DIRECTION
 - = SWALE
 - = EXISTING GRADE
 - - - = PROPOSED GRADE

NOTE: ALL TUBING MUST BE INSTALLED ALONG CONTOUR


SEWAGE DISPOSAL PERMIT MUST BE OBTAINED BY A LAKE COUNTY LICENSED ENGINEER BEFORE INSTALLATION IS

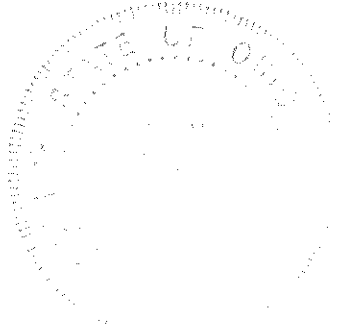

I CERTIFY THAT THIS PLAN WAS PREPARED BY ME AND IS CORRECT TO THE BEST OF MY KNOWLEDGE AND BELIEF

Stan R. Loch 2-14-01
 STAN R. LOCH P.E. #63332 DATE

Grading Plan Approved as shown and/or noted JAMES R. GILLS, P.E. Lake County Engineer


By: *J.R. Gills* Date: 2/24/01
 Swale 4.5' 24' 0"

"I, the undersigned hereby certify that this topography, indicated by 6", 1" or 2" contours, and elevations shown hereon represent an actual survey field survey made by me on the 13TH day of OCTOBER, 2000 and that the elevations were taken at appropriate intervals and that as of that date they existed as indicated hereon."

Stan R. Loch P.E. #63332
 Name Reg.#

SITE PLAN FOR:
 BRETT INGRAM
 BEING SUBLOT 7 OF THE
 HEMLOCK RIDGE SUBDIVISION
 TOWNSHIP OF LEROY
 LAKE COUNTY, OHIO

ENGINEERING and SURVEYING
 Civil Engineering and Surveying

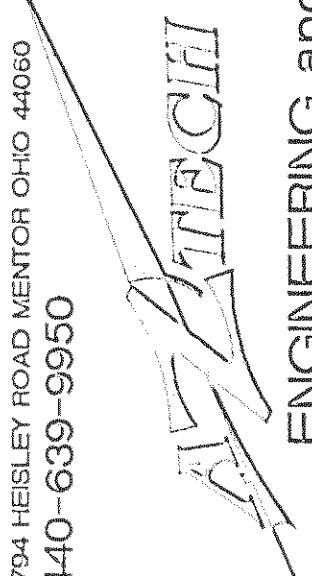

5704 HEISLEY ROAD MENTOR OHIO 44060
 440-639-9950 FAX 639-9790

HORIZ. SCALE: 1" = 30'	VERT. SCALE: 1" = 5'
DRAWN BY: BM	DATE: 10/20/2000
CHECKED BY: SRL	DRAWING NO.
JOB NO.: 100960	SHEET 1 OF 2

NO.	DATE	DESCRIPTION	BY
3	2/12/01	MOE SYSTEM PER L.C.H.D.	SRL
2	1/20/01	ADD DRIP SYSTEM	SRL
1	12/00	REVERSE SEPTIC SYSTEM	BM