

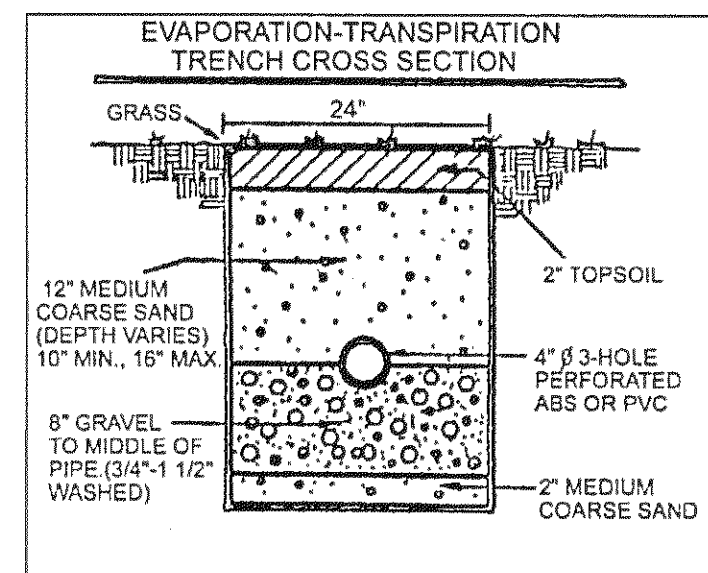
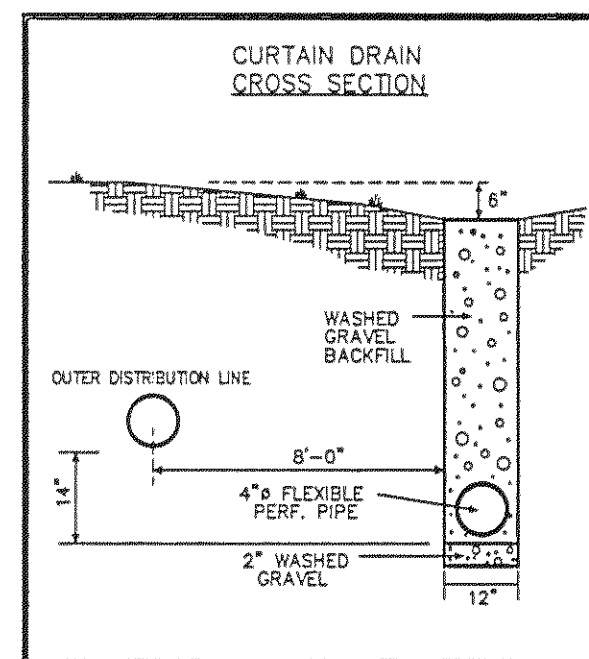


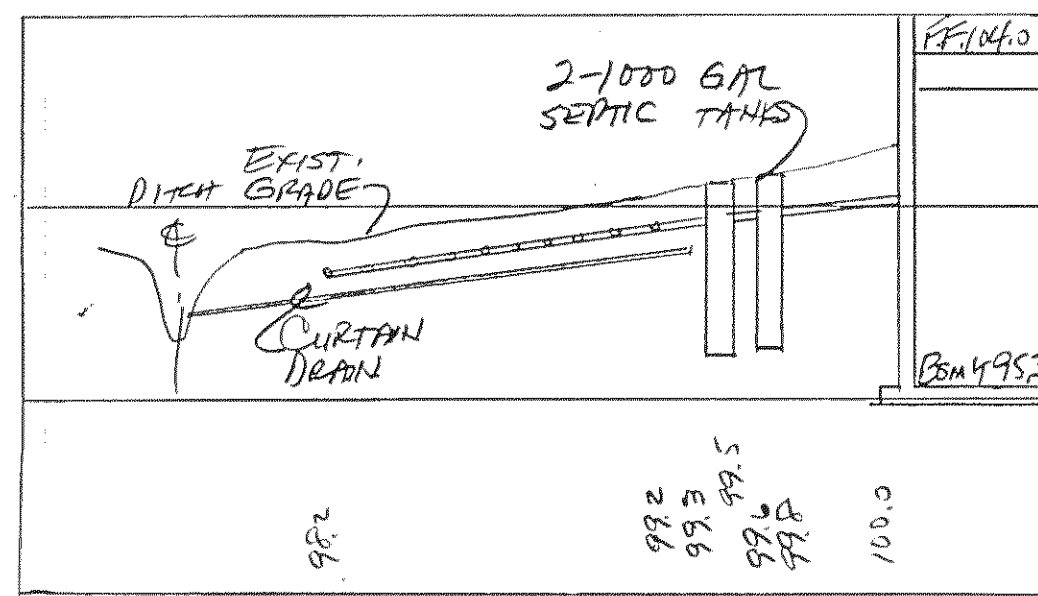

PAINESVILLE WARREN ROAD - 60'

HUNTOON ROAD - 60'

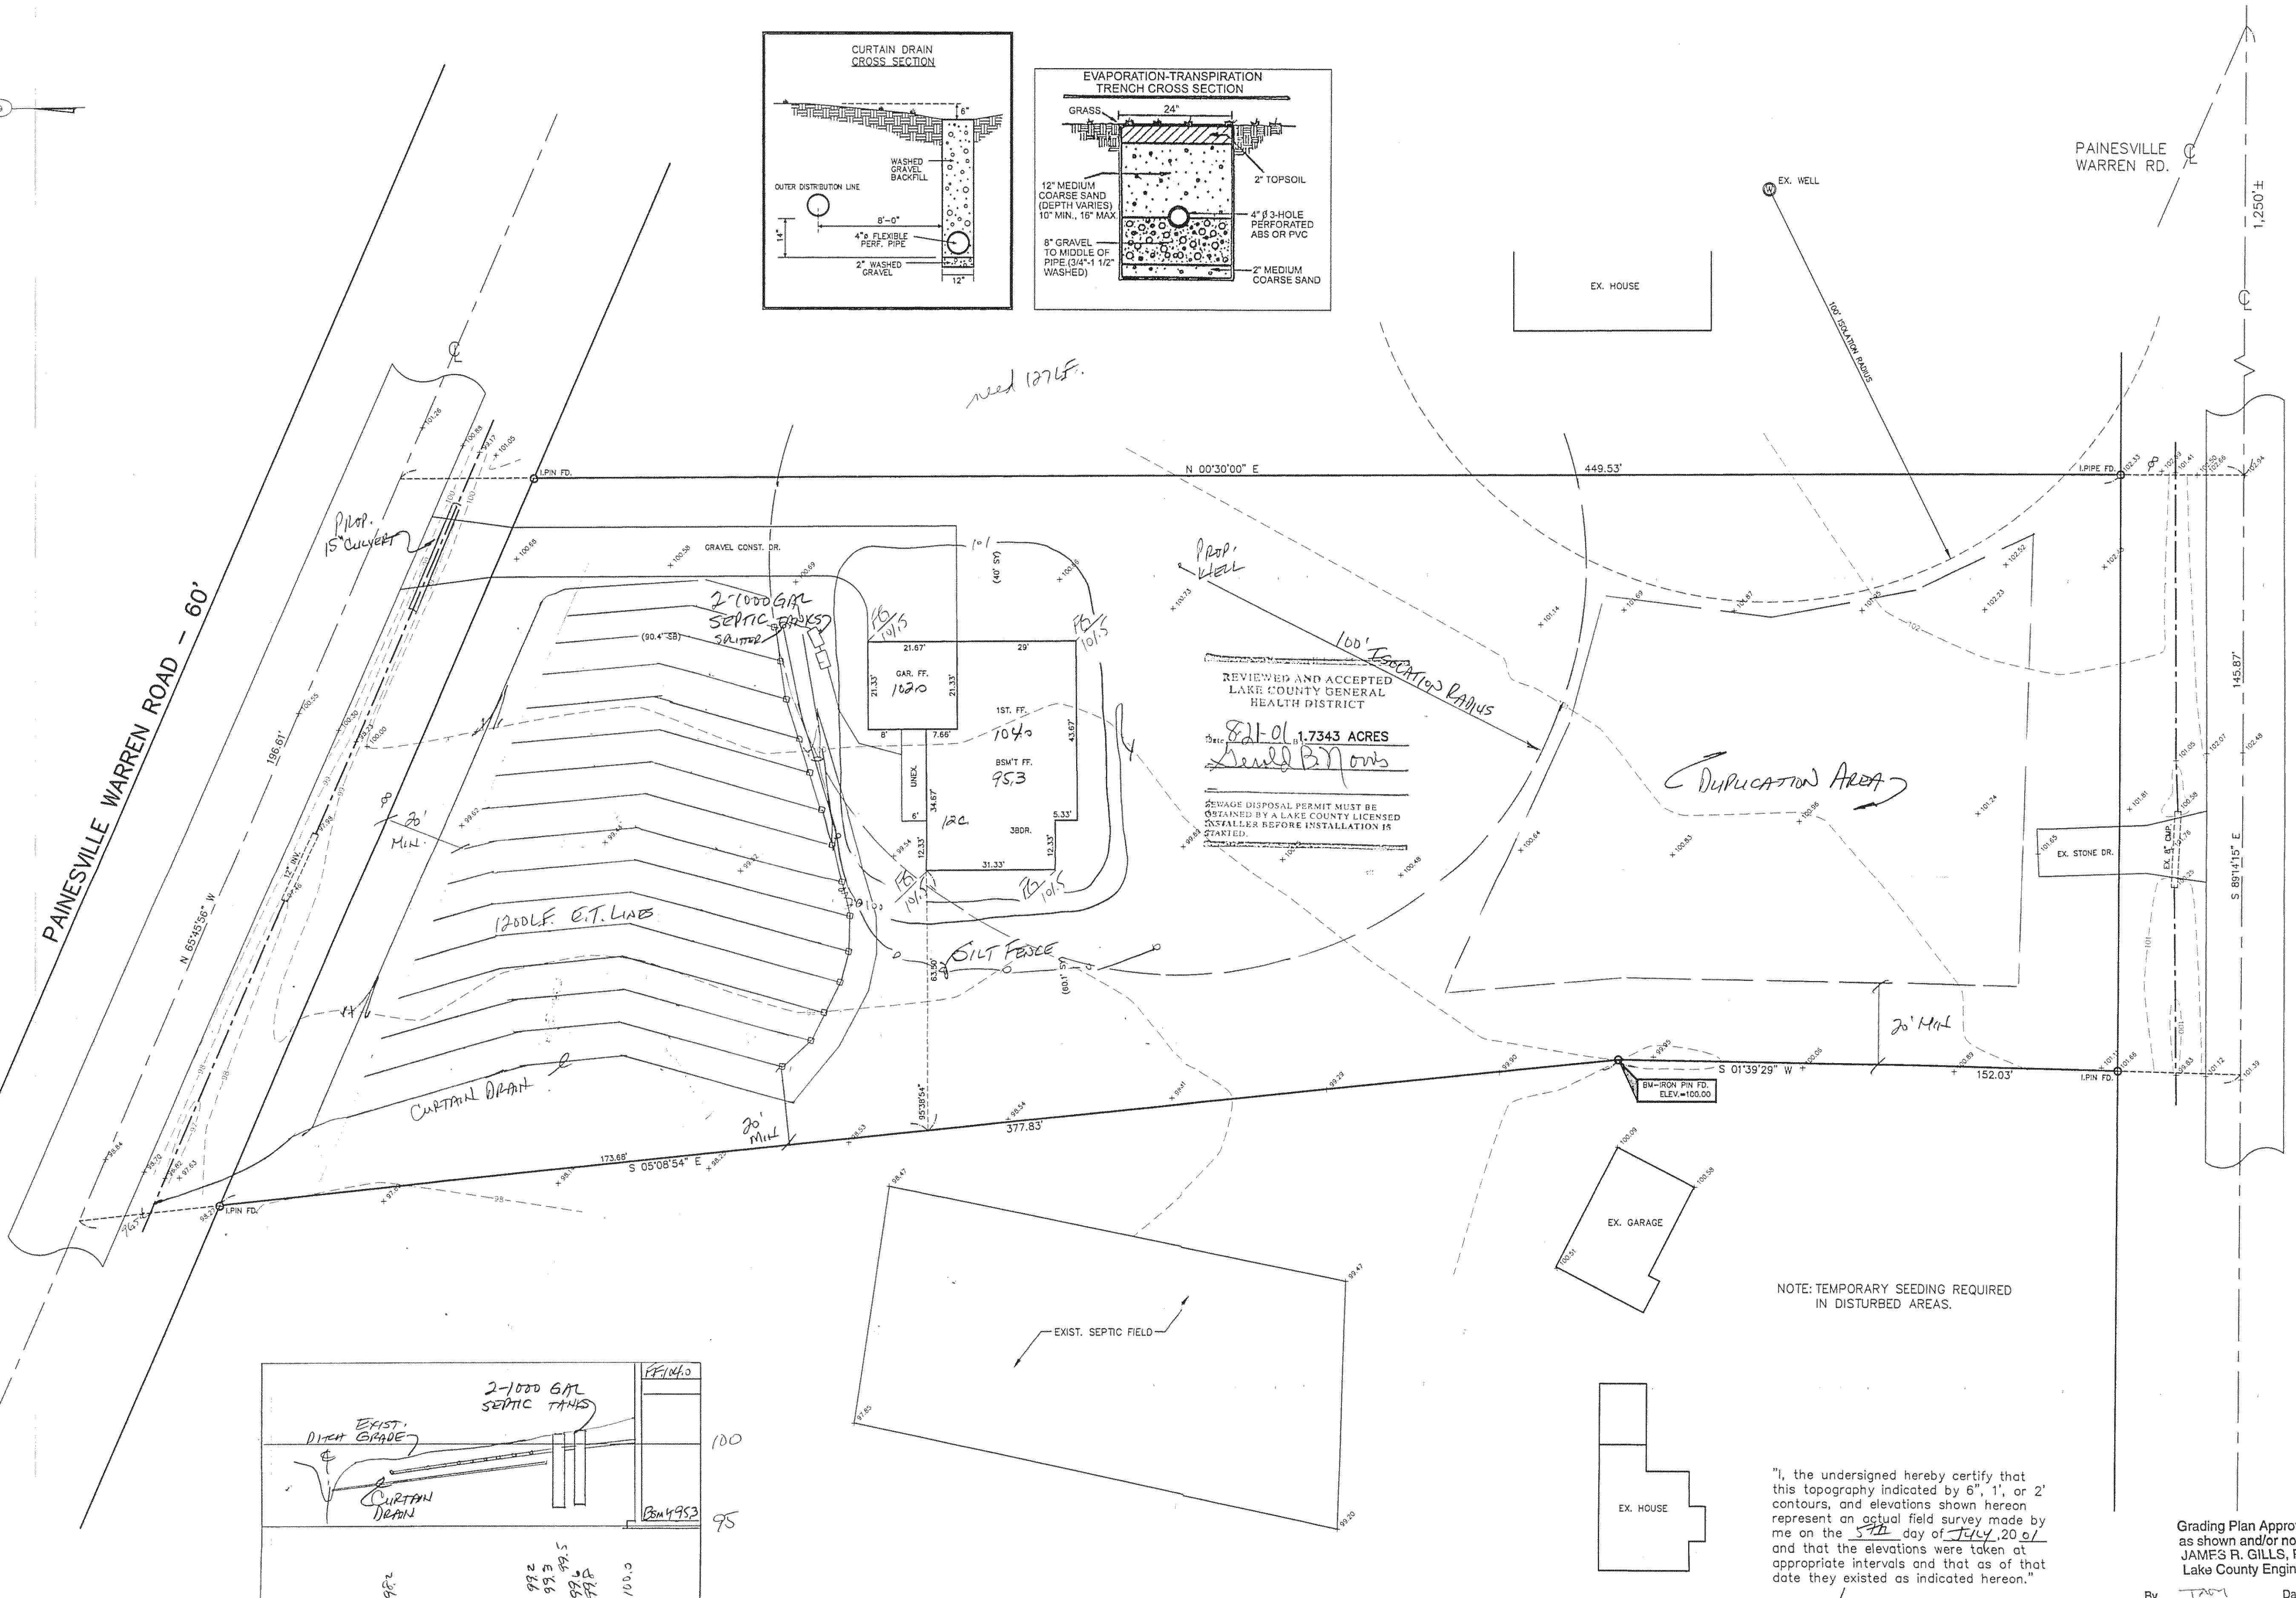

HYDRAULIC PROFILE
HORIZ 1/20' VERT 1/5'

REVIEWED AND ACCEPTED
LAKE COUNTY GENERAL
HEALTH DISTRICT

8-1-01 1.7343 ACRES
Sewer B.N.O.


SEWAGE DISPOSAL PERMIT MUST BE
OBTAINED BY A LAKE COUNTY LICENSED
CONSULTANT BEFORE INSTALLATION IS
STARTED.

NOTE: TEMPORARY SEEDING REQUIRED
IN DISTURBED AREAS.


"I, the undersigned hereby certify that
this topography indicated by 6", 1", or 2"
contours, and elevations shown hereon
represent an actual field survey made by
me on the 5th day of JULY, 2001
and that the elevations were taken at
appropriate intervals and that as of that
date they existed as indicated hereon."

Grading Plan Approved
as shown and/or noted
JAMES R. GILLS, P.E.
Lake County Engineer
By: [Signature] Date: 8/22/01

2799
[Signature]
[Stamp]

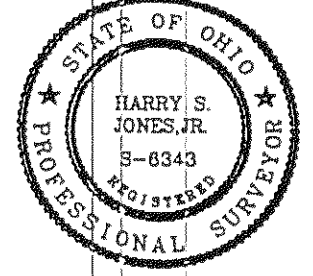

REV. NO.	DESCRIPTION	DATE	BY	CHK'D
1	CHANGED HOUSE LOCATION	8/15/01	TR.	H.J.
2	REVISED PER L.C. HEALTH DEPT.	8/20/01	HT	HT

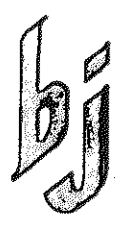

BABCOCK, JONES AND ASSOCIATES, INC
CIVIL ENGINEERS - SURVEYORS - LAND PLANNERS
PAINESVILLE OHIO 44077

DATE	7/5/01
DESIGN BY	H.J.
DRAWN BY	T.R.
APPROVED BY	H.J.

SITE PLAN
FOR
CANTERBILT

LERoy TOWNSHIP

LAKE COUNTY

SCALE:	1"=20'
JOB NO.	01-140
SHEET	1
OF	1