



SITE PLAN

FOR
RHONDA BURBUL
BEING SUBLOT NO. 2, SUNSHINE ACRES
SUBD. TOWNSHIP OF LEBAN, COUNTY OF
LAKE, STATE OF OHIO.

Grading Plan Approved
as shown and/or noted
THOMAS P. GILLES, P.E.
Lake County Engineer
By G.H. Date 01-15-92
DOT PERMIT
AS SHOWN REQUIRED

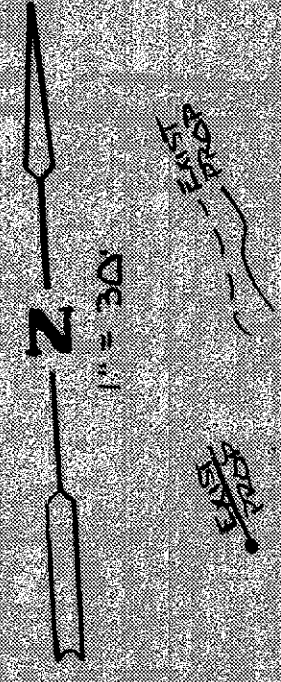

3 Bedroom Home
HYDRAULIC PROFILE
VERT. 1" = 3' HORIZ. 1" = 30'

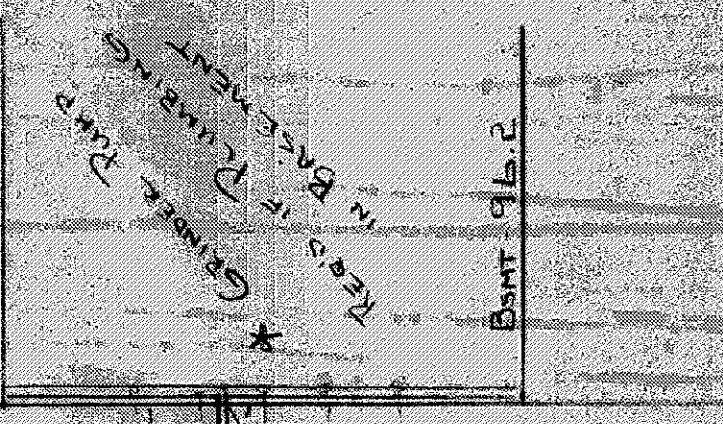

LOW YIELD WATER
FIXTURES REQUIRED
ON ALL

Shower Head
Toilet

- A. To be brought to finished grade
1. Septic tank manhole covers
 2. Splitter box cover
 3. Distribution box cover

- B. No footer drains or downspouts
to be discharged into septic tanks
- C. All waste water to be discharged into
septic tanks

SEWAGE DISPOSAL PERMIT MUST BE
OBTAINED BY A LAKE COUNTY LICENSED
INSTALLER BEFORE INSTALLATION IS
STARTED.

I, the undersigned hereby certify that
this topography indicated by 1" contours,
and elevations shown herein represent an
actual field survey made by me on June 26, 1992,
and that the elevations were taken at
appropriate intervals and that as of that
date they existed as indicated herein.

J.M. Coffman, P.S.
No. 4557



July 2, 1992
REV. 1-1-92 (SIDEWALKS)

Reviewed and Accepted	
LAKE COUNTY GENERAL HEALTH DISTRICT	
Date	10-8-92
JOEL LUGER, R.S., M.P.H. Health Commissioner	
By	M. Nishino

VILLAGE SURVEYING CO.
202 Third St. Fairport Har. OH 44027
(216) 357-1359