

Erosion and Sediment Control Schedule

<u>Ingress-Egress</u>

A stone access drive complete with under lying geo—textile fabric (20 feet wide and 50 feet long) for ingress and egress at the site shall be installed. This drive shall be the only entrance and exit to the site.

<u>Silt Fence</u>

A silt fence shall be installed prior to any earthwork activities at the site in the locations shown on the site plan as well as along the front of any lot that slopes towards the street.

Temporary Seeding


Disturbed areas of the site that are to remain idle for more than thirty(30) days shall be properly seeded and straw mulched within seven(7) days of completion of intitial grading. Temporary seeding and mulching ao a thirty(30) foot strip of the entire front of the lot shall be maintained on the site once initial grading is complete.


Stabilization of critical areas within fifty(50) feet of any stream or wetland shall be complete within two(2) days of the disturbance if the site is to remain inactive for longer than fourteen(14) days.


Straw—mulch shall be applied at a rate of 1 bale per every ten (10) feet of curb, at a width of thirty(30) feet to the entire length of the lot. Wood chips may also be used but must be spread at a minimum depth of four inches over the thirty-foot width and must be accompanied by a properly installed silt fence.

<u>Maintenance</u>

Erosion and sediment controls shall be inspected every seven(7) days or within 24 hours of a 0.5" or greater rainfall event. Necessary repairs shall be made at this time.

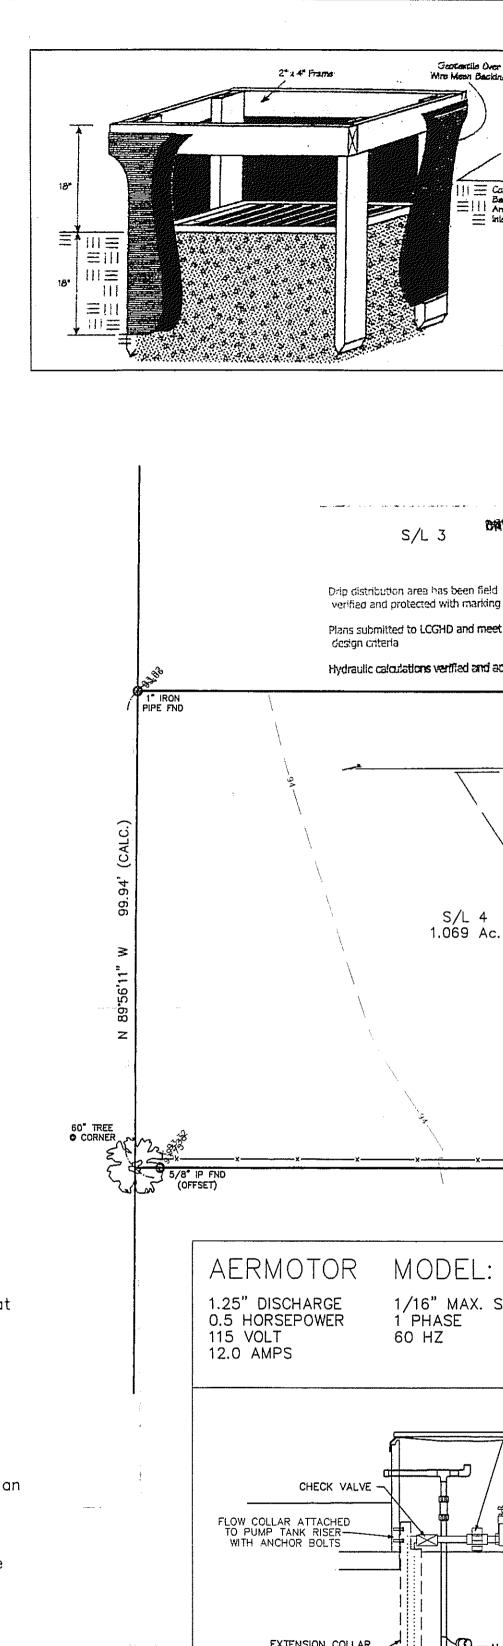


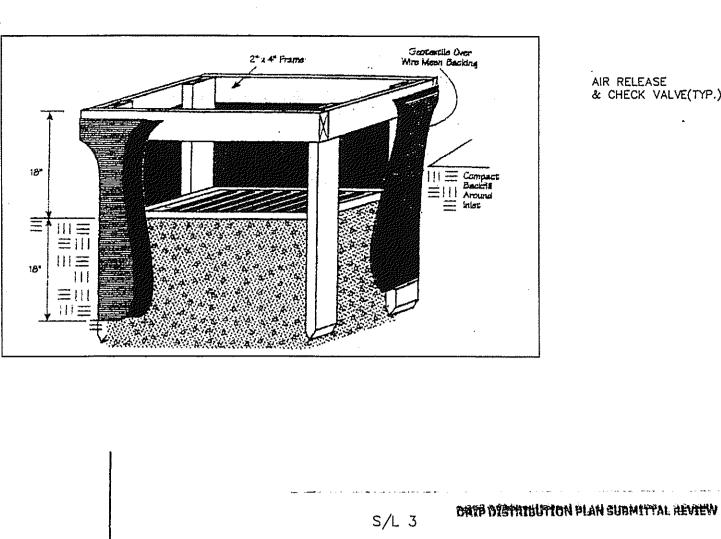

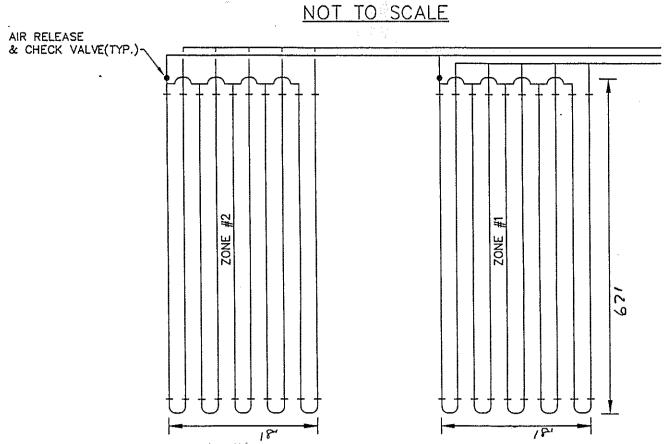

-COMMON RETURN-

AIR RELEASE

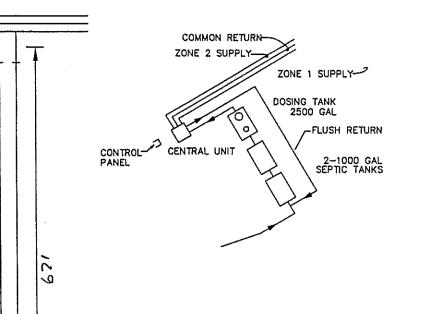


(292' R.Y.)


AREA-


- 25 UNDISTURDED

S 00°14'20" E 465.60'

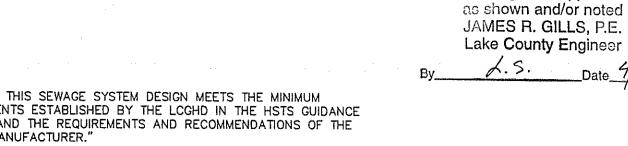

Grading Plan Approved

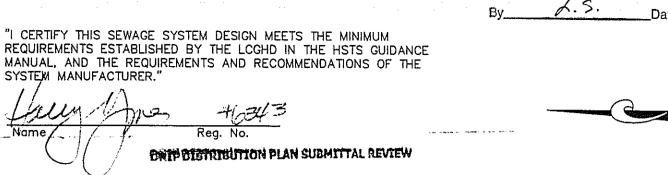

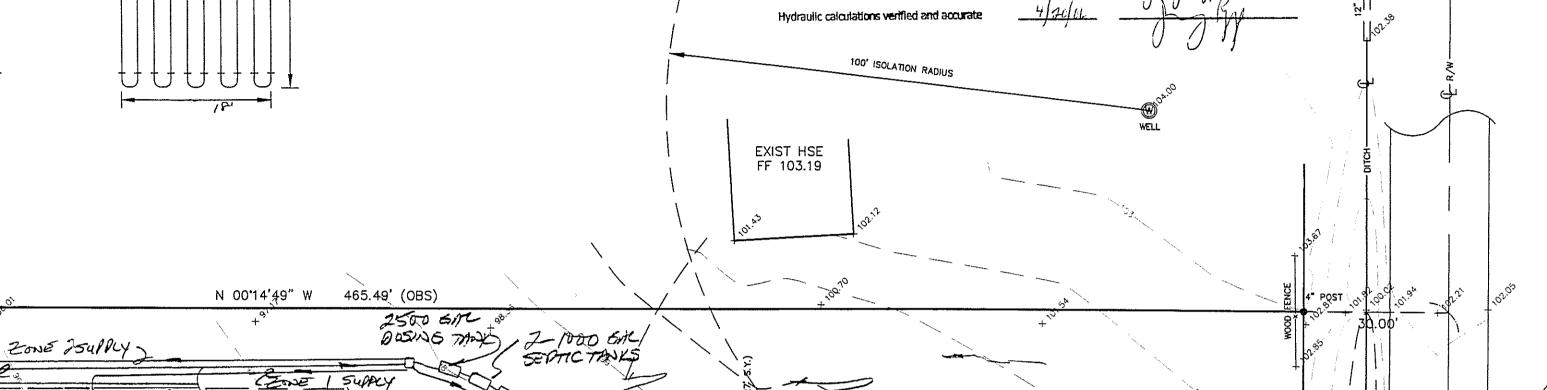

Drip distribution area has been field verified and protected with marking tape

Plans submitted to LCGHD and meet

GAR FF

EXIST HSE FF 100.62

MATERIAL

design criteria

AERMOTOR MODEL: TEP20-50-115 1.25" DISCHARGE 1/16" MAX. SOLIDS HANDLING

1 PHASE

60 HZ

S/L 4 1.069 Ac.

verified and protected with marking tape

Hydraulic calculations verified and accurate

Plans submitted to LCGHD and meet

design criteria

MULTI-STAGE CENTRIFUGAL JUNCTION BOX CHECK VALVE -(BY OTHERS) FLOW COLLAR ATTACHED TO PUMP TANK RISER— WITH ANCHOR BOLTS TO CENTRAL UNIT EXTENSION COLLAR (BY OTHERS) NO TALARM PEAK ENABLE SEE INSERT DOSING CHAMBER DETAIL FOR 15 GPM AMERICAN LAMINAR FLOW COLLAR (LFC15)

"I, the undersigned hereby certify that this topography indicated by 6", 1', or 2' contours, and elevations shown hereon represent an actual field survey made by me on the day of day of and that the elevations were taken at S/L 5 appropriate intervals and that as of that LLR= 2.7 date they existed as indicated hereon."

DUPLICATION !

CCURTAIN DRAIN


Zone

Temporary Seeding Species Selection			
Seeding Dates	Species	Lb./1,000 ft. ²	Per Ac.
March 1 to August 15	Oats	з .	4 bushel
	Tall Fescue	1	40 lb.
	Annual Ryegrass	1	40 lb.
	Perennial Ryegrass	1	40 lb.
	Tall Fescue	1	40 lb.
	Annual Ryegrass	1	40 lb.
August 16 to November 1	Rye	3	2 bushel
	Tall Fescue	1	40 lb.
	Annual Ryegrass	1	40 lb.
	Wheat	3	2 bushel
	Tall Fescue	1	40 lb.
	Annual Ryegrass	1	40 lb.
	Perennial Ryegrass	1	40 lb.
	Tall Fescue	1	40 lb.
	Annual Ryegrass	٠ ا	40 lb.

50 ft. (or 30 ft. for Access to Individual House Lot) and Not Loss Than Width of Ingress/Egress Road or Other Existing Paved Surface PLAN YIEW Right of Way Diversion ∃III = III ∃III = III ∃III 18" or Sufficient to Divert Runoff

100' ISOLATION RADIUS

TBM - 5/8" IRON PIN FND ELEV - 100.00 EXISTING UTILITIES NOTE:
THE SIZE AND LOCATION, BOTH HORIZONTAL AND VERTICAL
OF THE UNDERGROUND UTILITIES SHOWN HEREON, HAVE BEEN

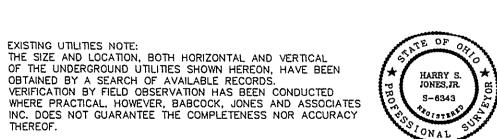

REY NO. DESCRIPTION DATE BY CHK'D 2/28/06 B.P. MOVED HSE FROM 100' S.B. TO 75' S.B. H.J. CHANGED SEPTIC TO DRIP SYS. 4/3/06 B.P. H.J.

Note: Other approved seed species may be substituted.

BABCOCK, JONES AND ASSOCIATES, INC CIVIL ENGINEERS - SURVEYORS - LAND PLANNERS

PAINESVILLE OHIO 44077

2/21/06 APPROVED BY CREW CHIEF LEROY TOWNSHIP

SITE PLAN FOR JOHN CUTLIP

LAKE COUNTY

1"=20' 06-019 SHEET S/L 4 RADCLIFFE ROAD (KECKETY ALLOT.) STATE OF OHIO