


GRAPHIC SCALE

(IN FEET)
1 inch = 30 ft.

CURVE DATA TABLE

STATION	CHORD BEARING	DELTA
RUSTIC DRIVE - (60' WIDE)
PLAT VOL. "X" ~ PG.

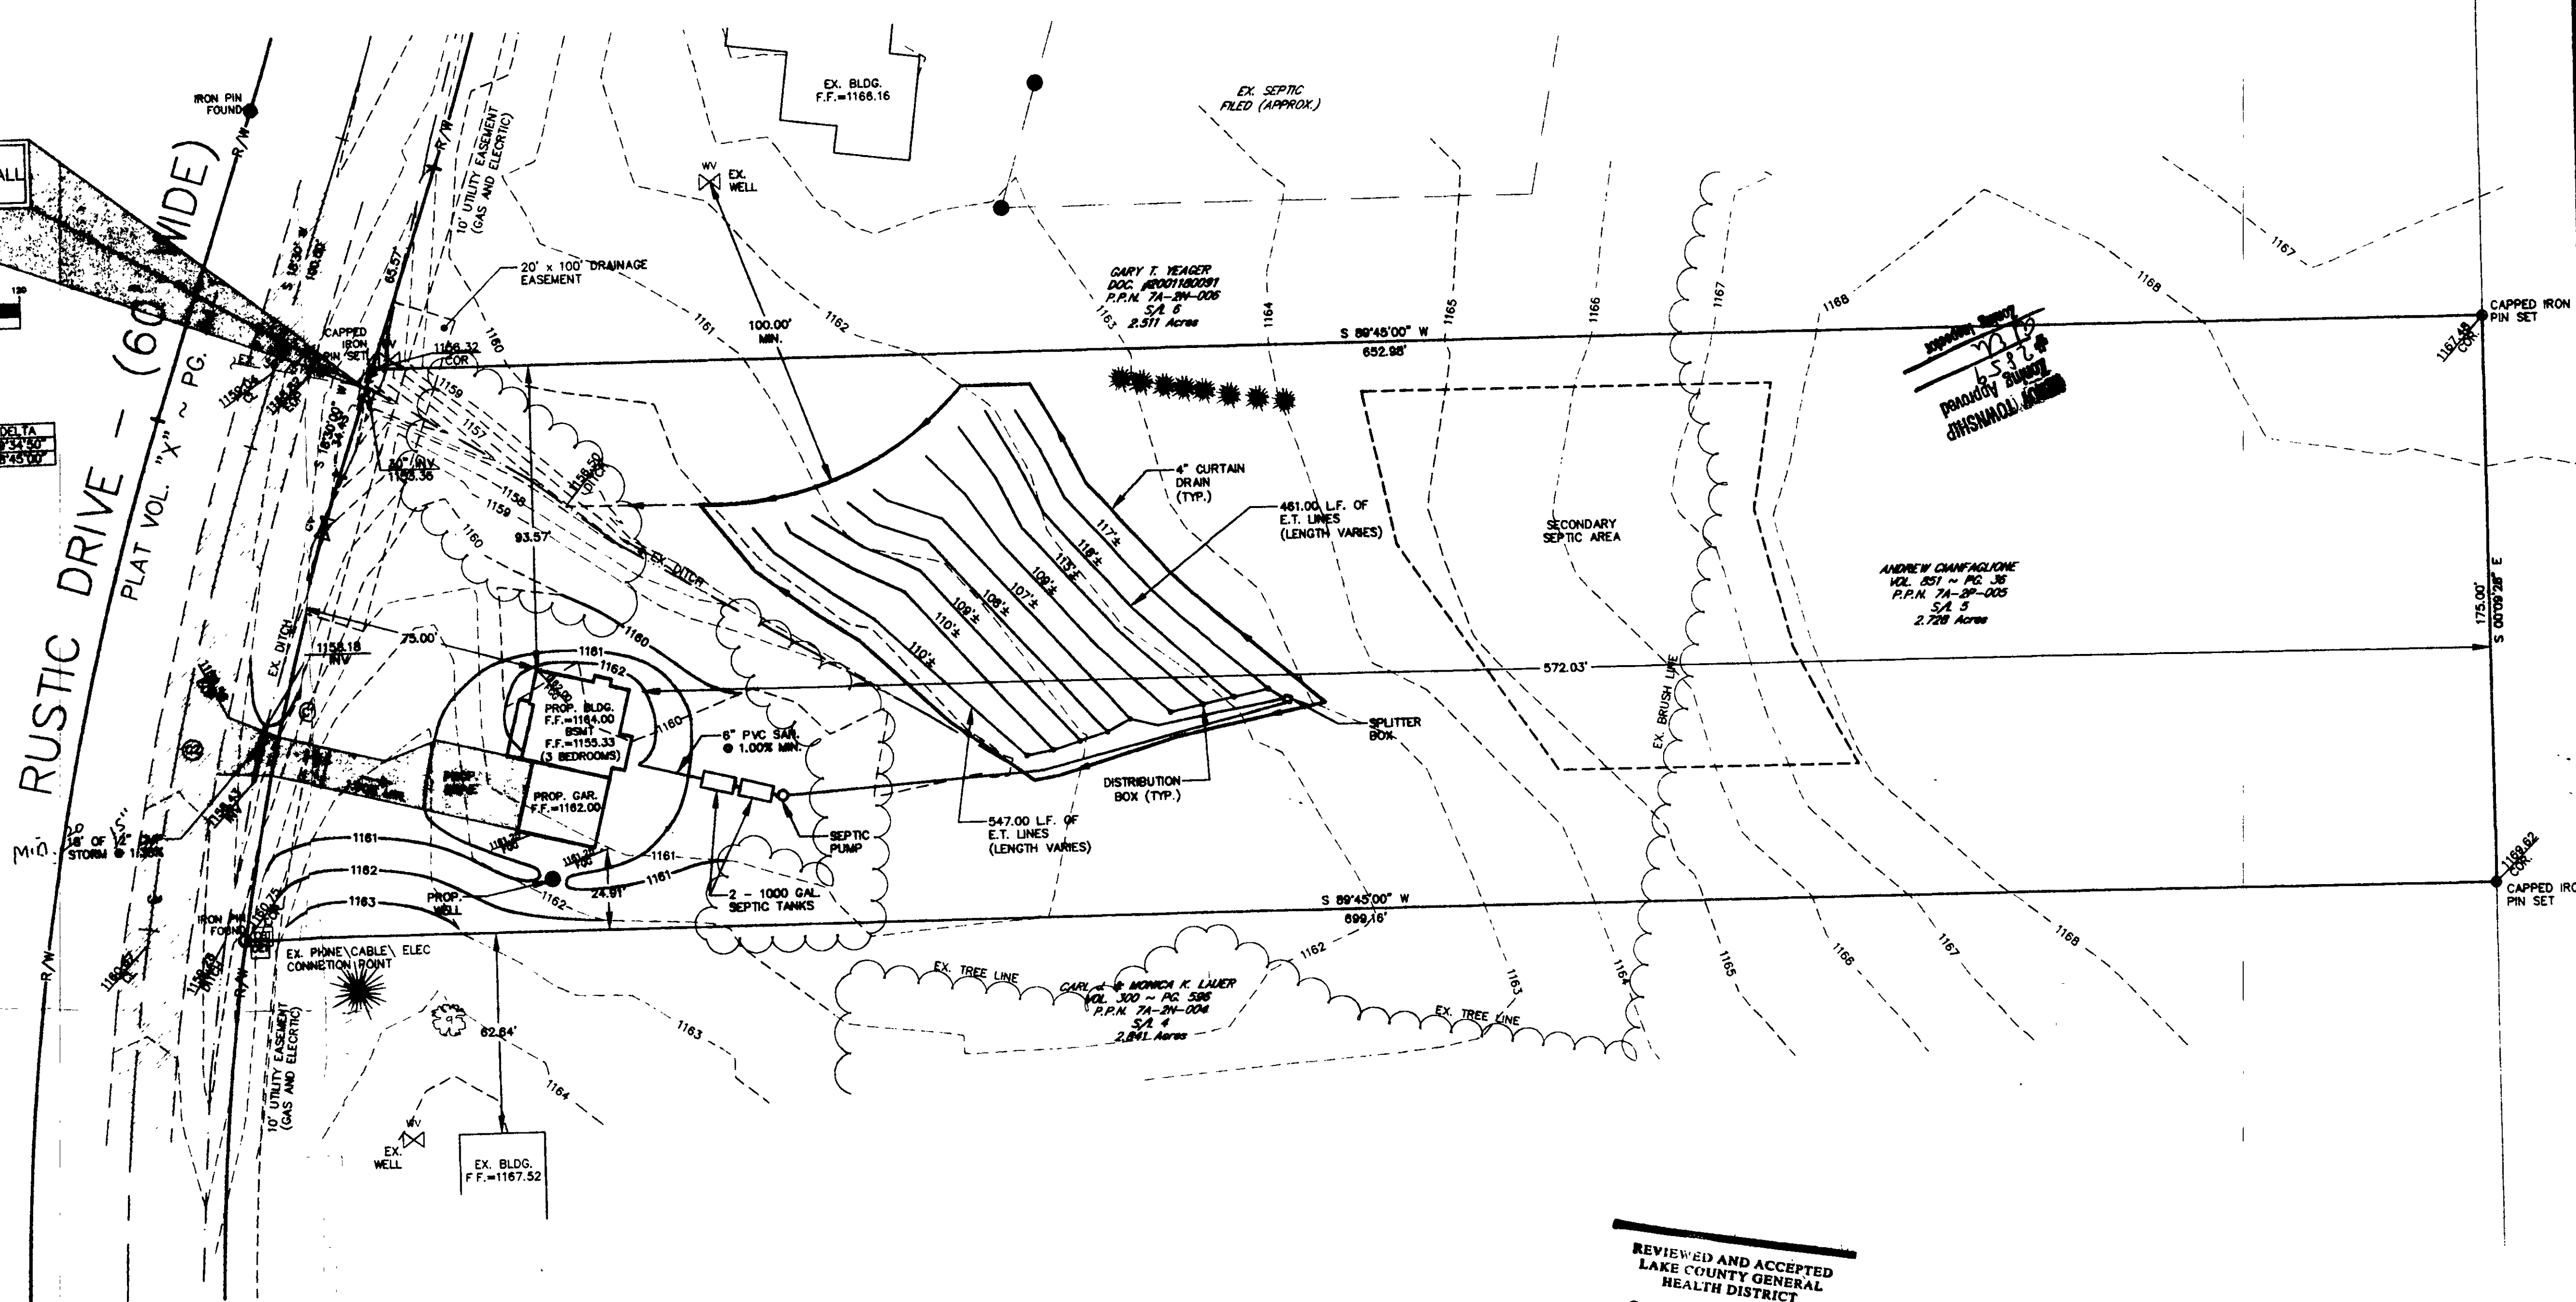


REVIEWED AND ACCEPTED
LAKE COUNTY GENERAL
HEALTH DISTRICT
Date: 8-8-02
By: *[Signature]*
SEWAGE DISPOSAL PERMIT MUST BE
OBTAINED BY A LAKE COUNTY LICENSED
INSTALLER BEFORE INSTALLATION IS
STARTED.

Grading Plan Approved
as shown and/or noted
JAMES R. GILLS, P.E.
Lake County Engineer
By: *[Signature]* Date: 8/12/02
MIN 20' - 15" Drive Culvert

EVAPORATION-TRANSPIRATION
TRENCH DETAIL
NTS

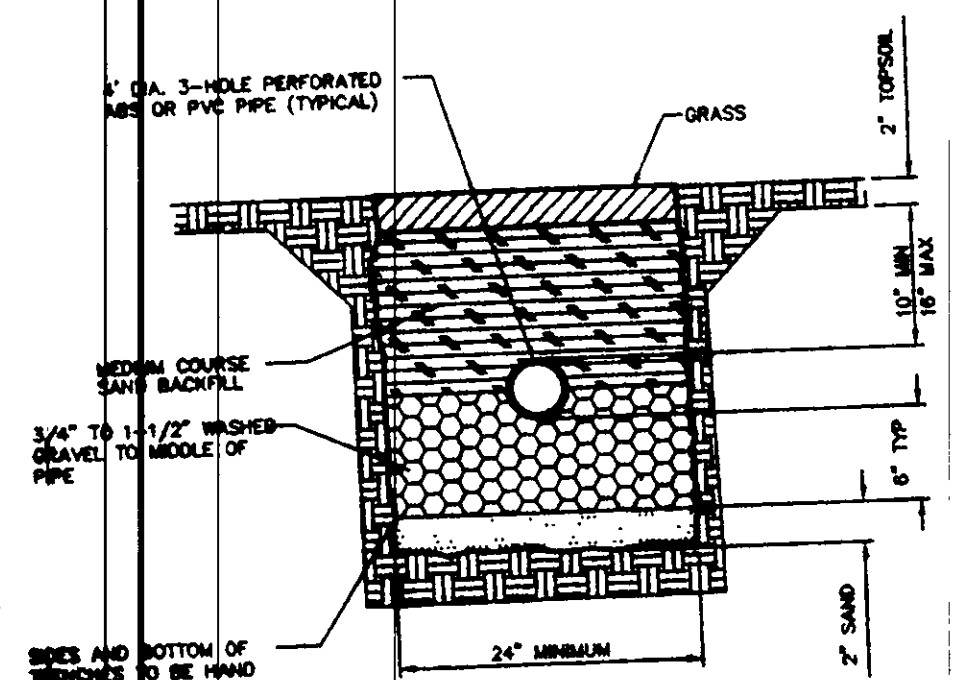


CURTAIN DRAIN DETAIL
NTS

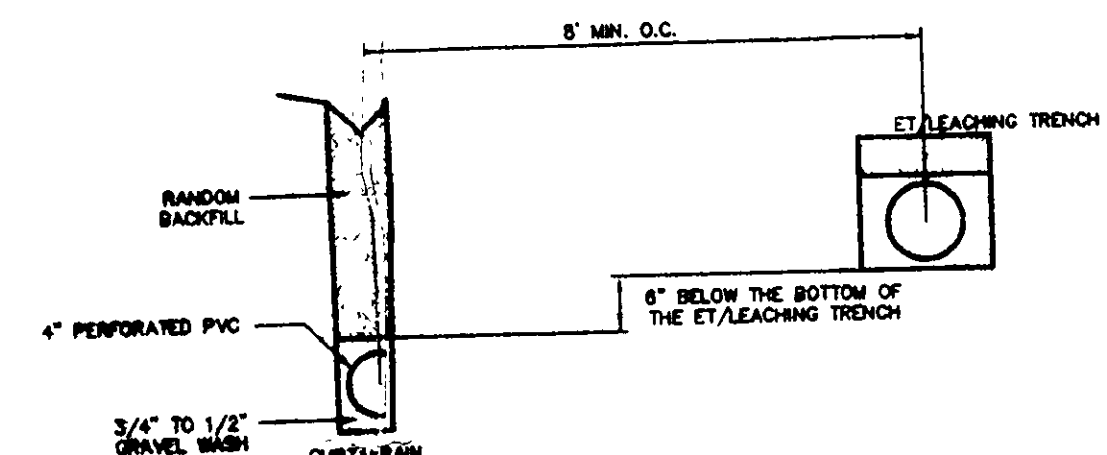

- PROJECT NOTES:**
1. A TEMPORARY 2' STONE CONSTRUCTION ENTRANCE (4\"/>
 2. ALL DISTURBED AREAS SHALL HAVE TEMPORARY SEEDING AS PER SPECIFICATIONS FOUND IN THE RAINWATER & LAND DEVELOPMENT MANUAL.
 3. LGSWD SITE PLAN ENDSHOW FROM NOTES & DETAIL SPECS FROM THE MANUAL HAVE BEEN PROVIDED TO CLIENT.
 4. SEE BUILDER'S PLANS FOR COMPLETE HOUSE DETAILS AND DIMENSIONS.
 5. SHOWN TO BE SUBMITTED ONTO SPAN/RECORDS

HYDRAULIC PROFILE
NTS

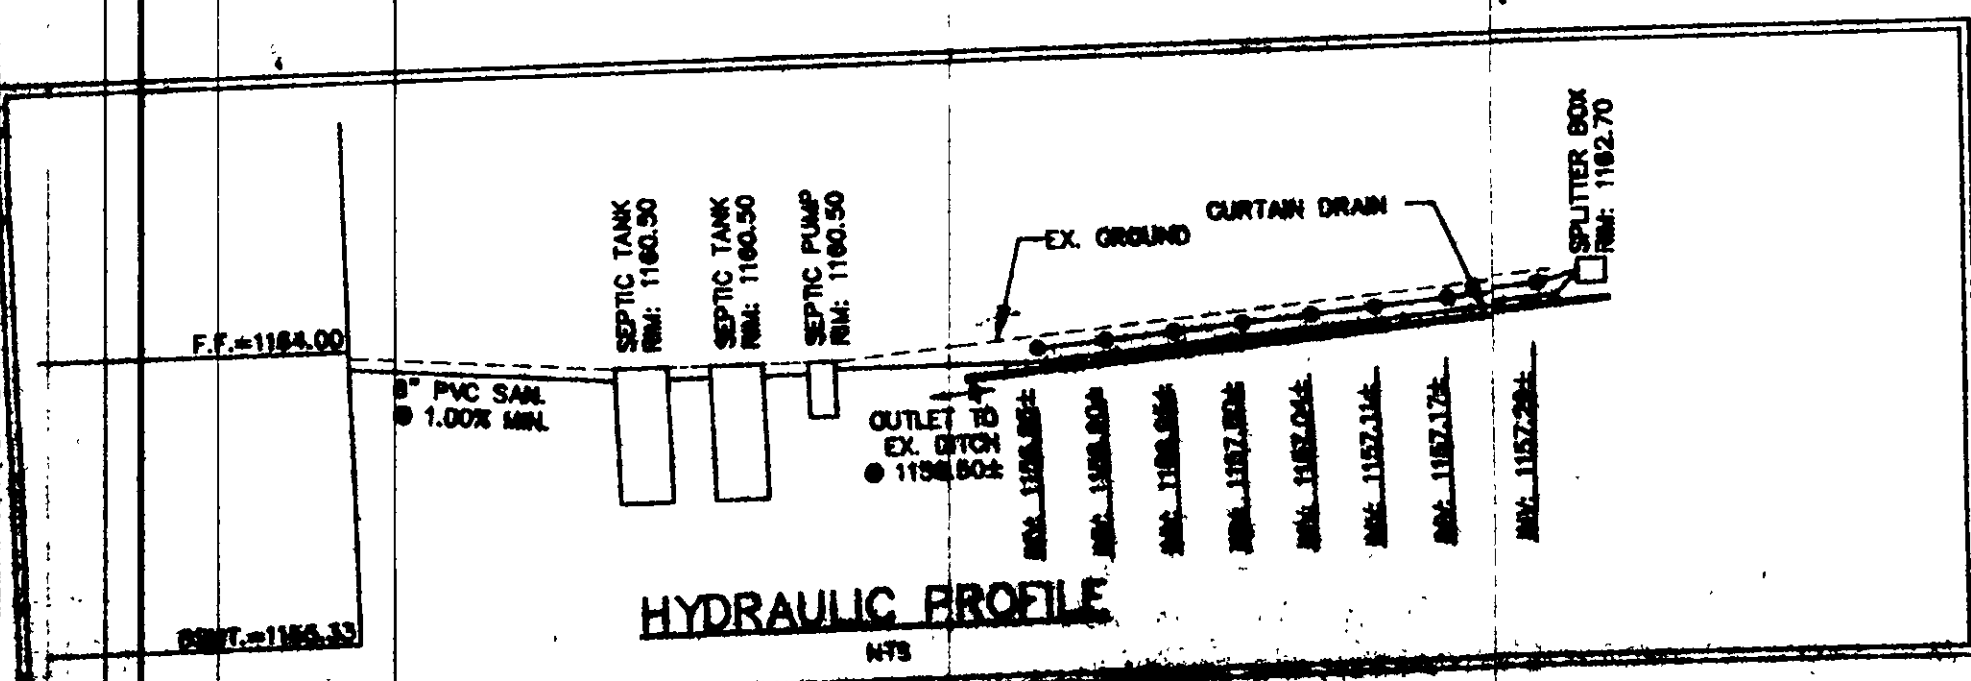

CERTIFICATION:

I, the undersigned, hereby certify that this topography, indicated by 1' 0\"/>

[Signature]
Date: 8/08/02

Site Plan for S/L 5 in the
Highland Trail Subdivision for
Cianfaglione Builders, Inc.
Leroy Township ~ Lake County ~ Ohio



Drawn By: MOP
Checked By:
Approved By:
Date: 8/8/02

