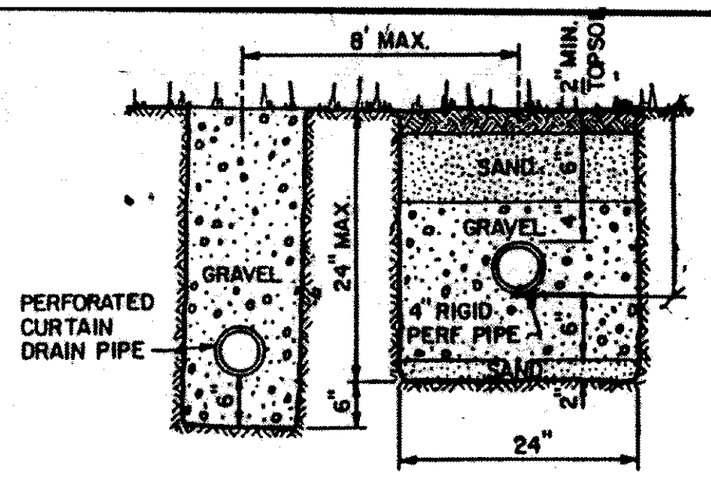

TRENCH DETAIL

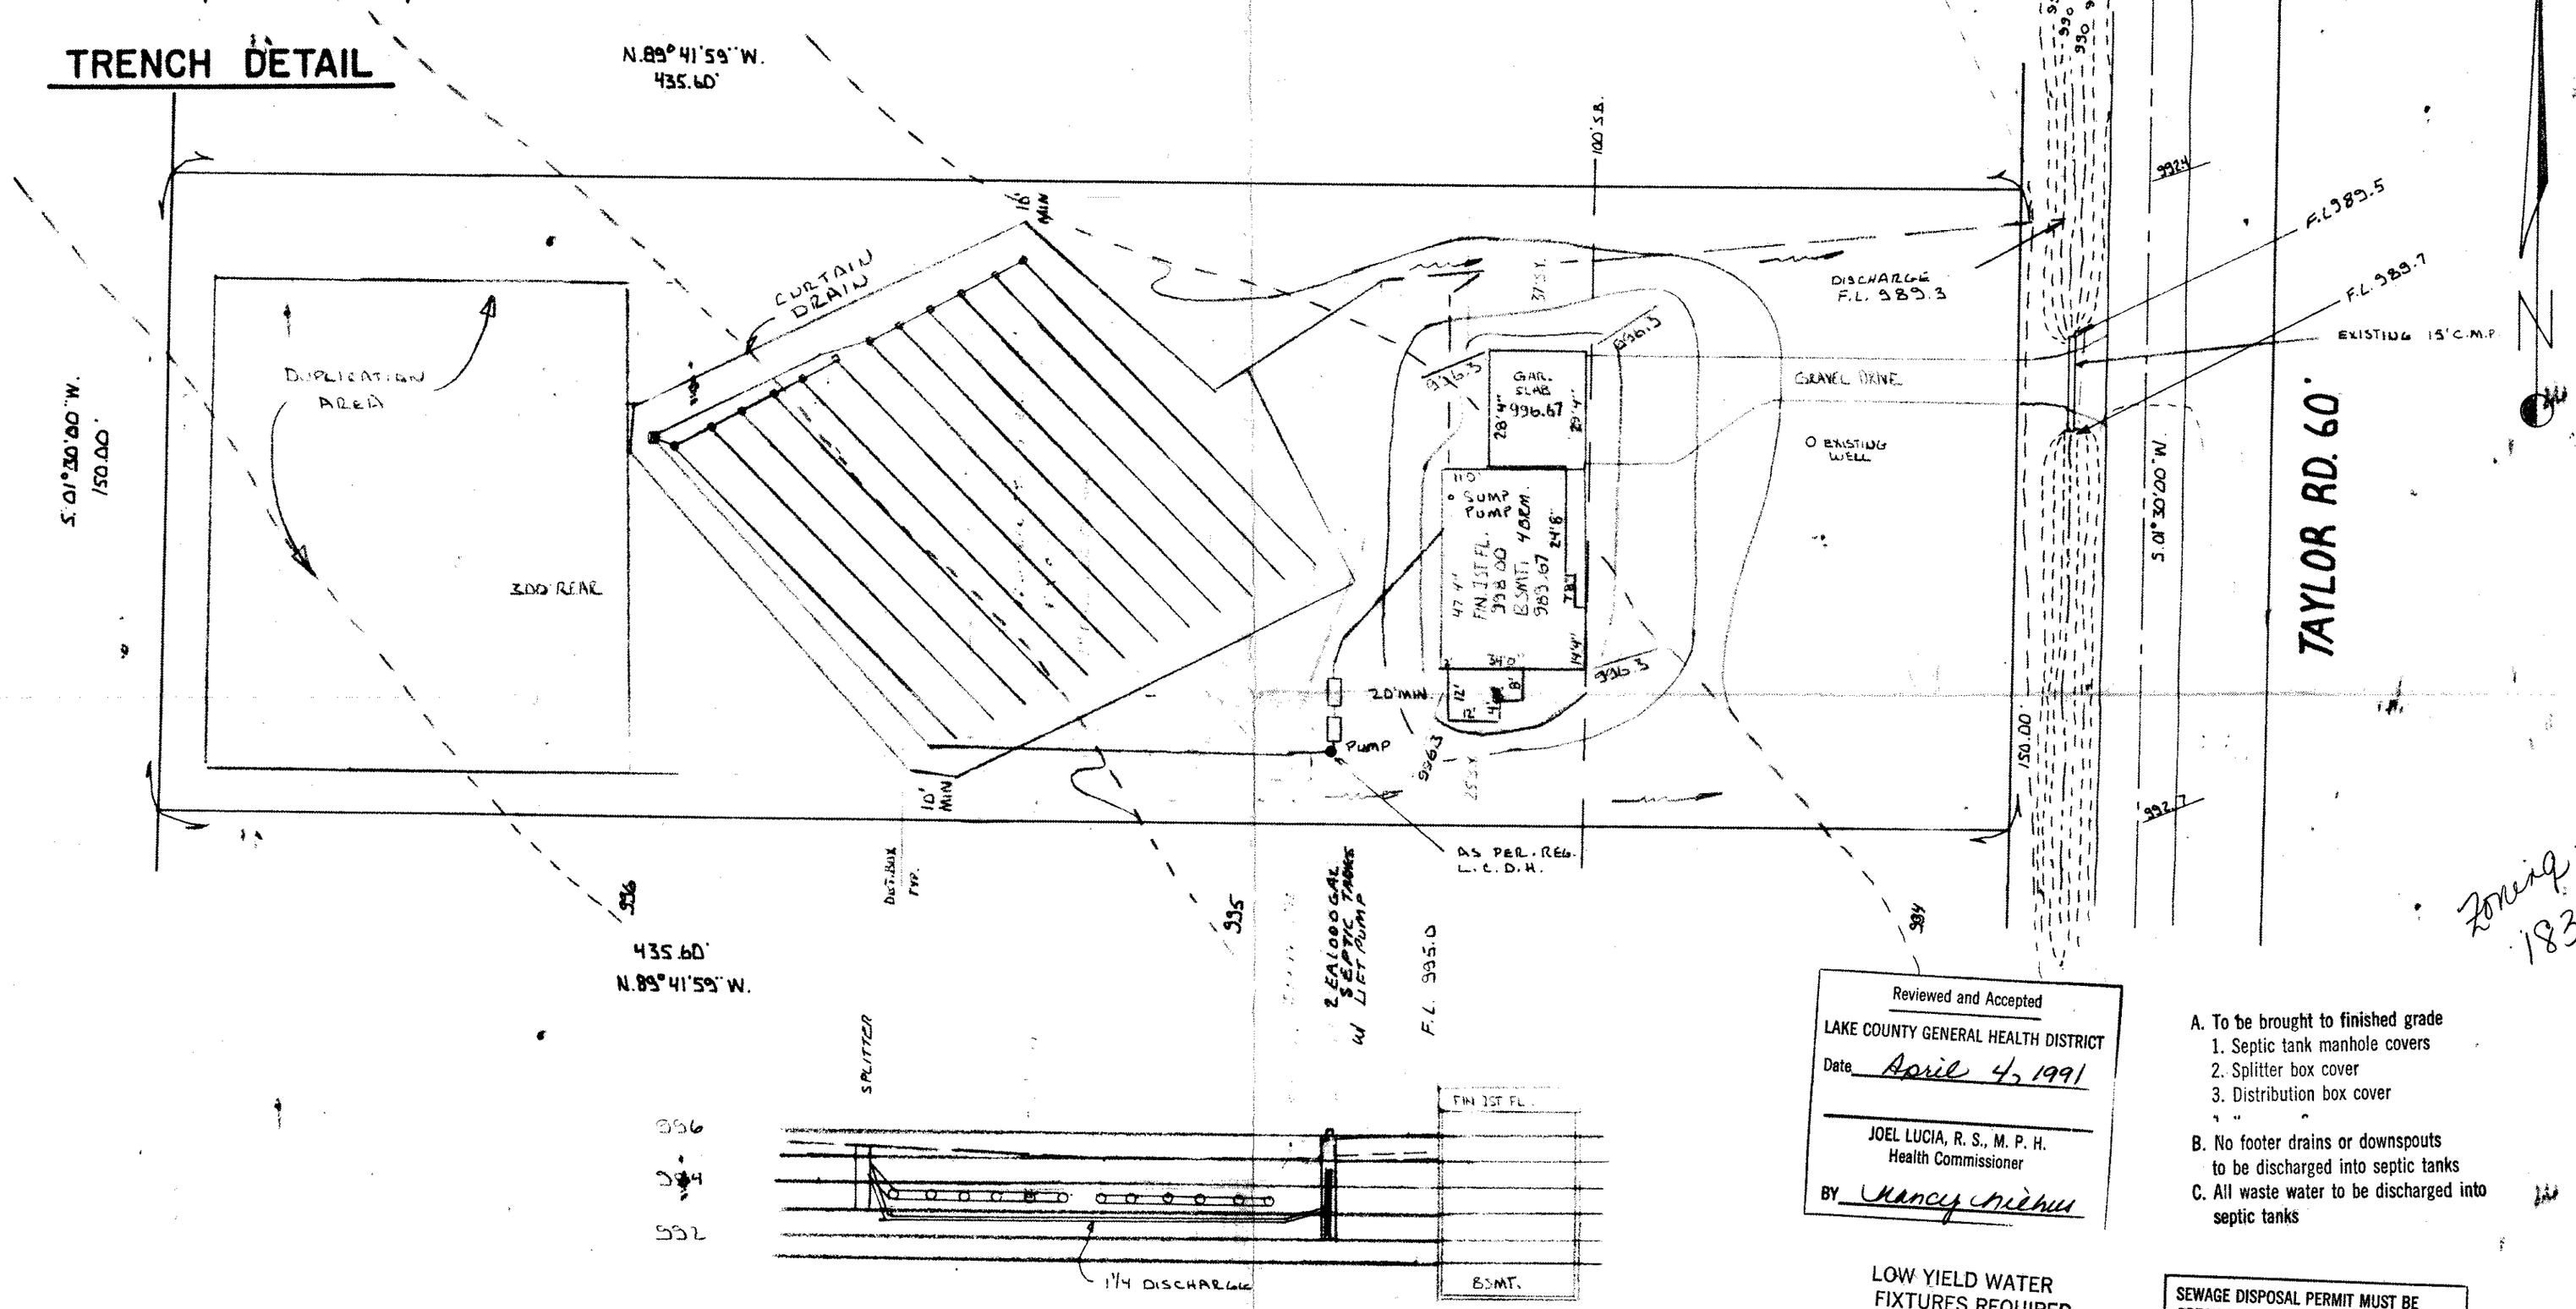

Zoning # 1834

Reviewed and Accepted
LAKE COUNTY GENERAL HEALTH DISTRICT
Date April 4, 1991
JOEL LUCIA, R. S., M. P. H.
Health Commissioner
BY Nancy Niehus

A. To be brought to finished grade
1. Septic tank manhole covers
2. Splitter box cover
3. Distribution box cover

B. No footer drains or downspouts to be discharged into septic tanks

C. All waste water to be discharged into septic tanks

LOW YIELD WATER FIXTURES REQUIRED ON ALL:
__ Shower Head
__ Toilet
__

SEWAGE DISPOSAL PERMIT MUST BE OBTAINED BY A LAKE COUNTY LICENSED INSTALLER BEFORE INSTALLATION IS STARTED.

EXISTING / PROPOSED GRADES
SWALE

"I, the undersigned hereby certify that this topography, indicated by 6", 1' or 2' contours, and elevations shown hereon represent an actual field survey made by me on the 13 day of JAN., 1991 and that the elevations were taken at appropriate intervals and that as of that date they existed as indicated hereon."

John C. Skonieczny
Name

PS#6356
Reg. No

REVISIONS
1. MAR 15.91 ADD PUMP, SHOW NEW DITCH, ADD DETAILS
2. APR 4. 91 CHG. SEPTIC LAYOUT

PROFILE HOR. 1" = 30'
VERT. 1" = 5'

Grading Plan Approved as shown and/or noted
THOMAS P. GILLES, P.E.
Lake County Engineer
By GJH Date 4/5/91

STATE OF OHIO
JOHN CLOUD SKONIECZNY
S-6356
REGISTERED SURVEYOR

I CERTIFY THAT THIS PLAN WAS PREPARED BY ME AND IS CORRECT TO THE BEST OF MY KNOWLEDGE AND BELIEF

John C. Skonieczny
REG. SURVEYOR #6356

JOHN C. SKONIECZNY
7739 VIEWMOUNT DR.
PAINESVILLE, OHIO 44077
PH. 352-7742

SITE PLAN FOR:
JOSEPH SCHINDEL
6340 TAYLOR RD.
LEROY TWP., OHIO

SCALE: 1" = 30	APPROVED BY	DRAWN BY FJH
DATE: JAN. 91		

AS RECORDED IN VOL. 570 - 1077 L.C.R.D.
TOWNSHIP OF LEROY, COUNTY OF LAKE, STATE OF OHIO

DRAWING NUMBER