
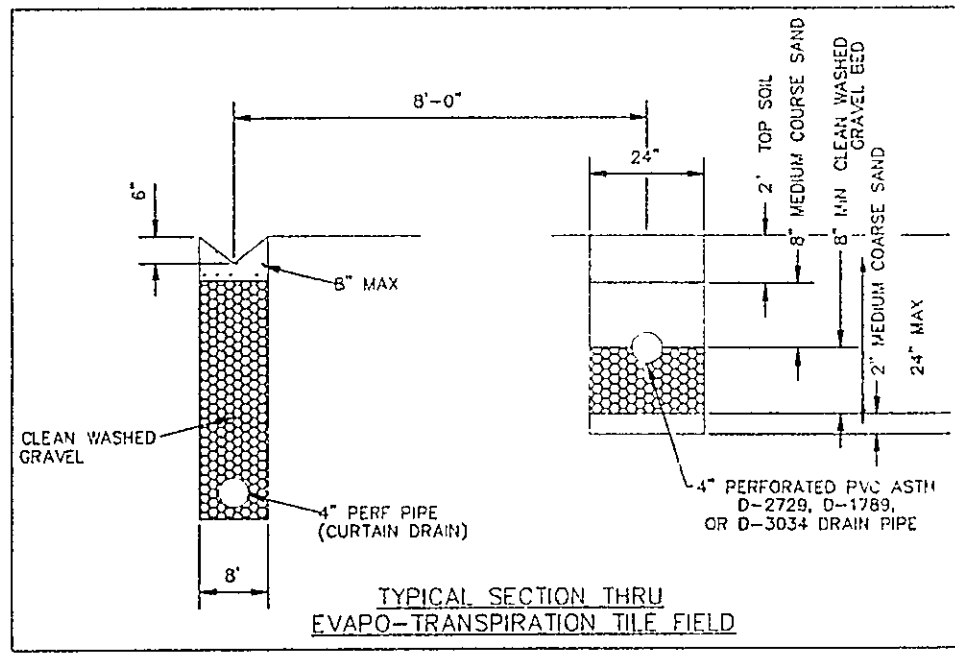
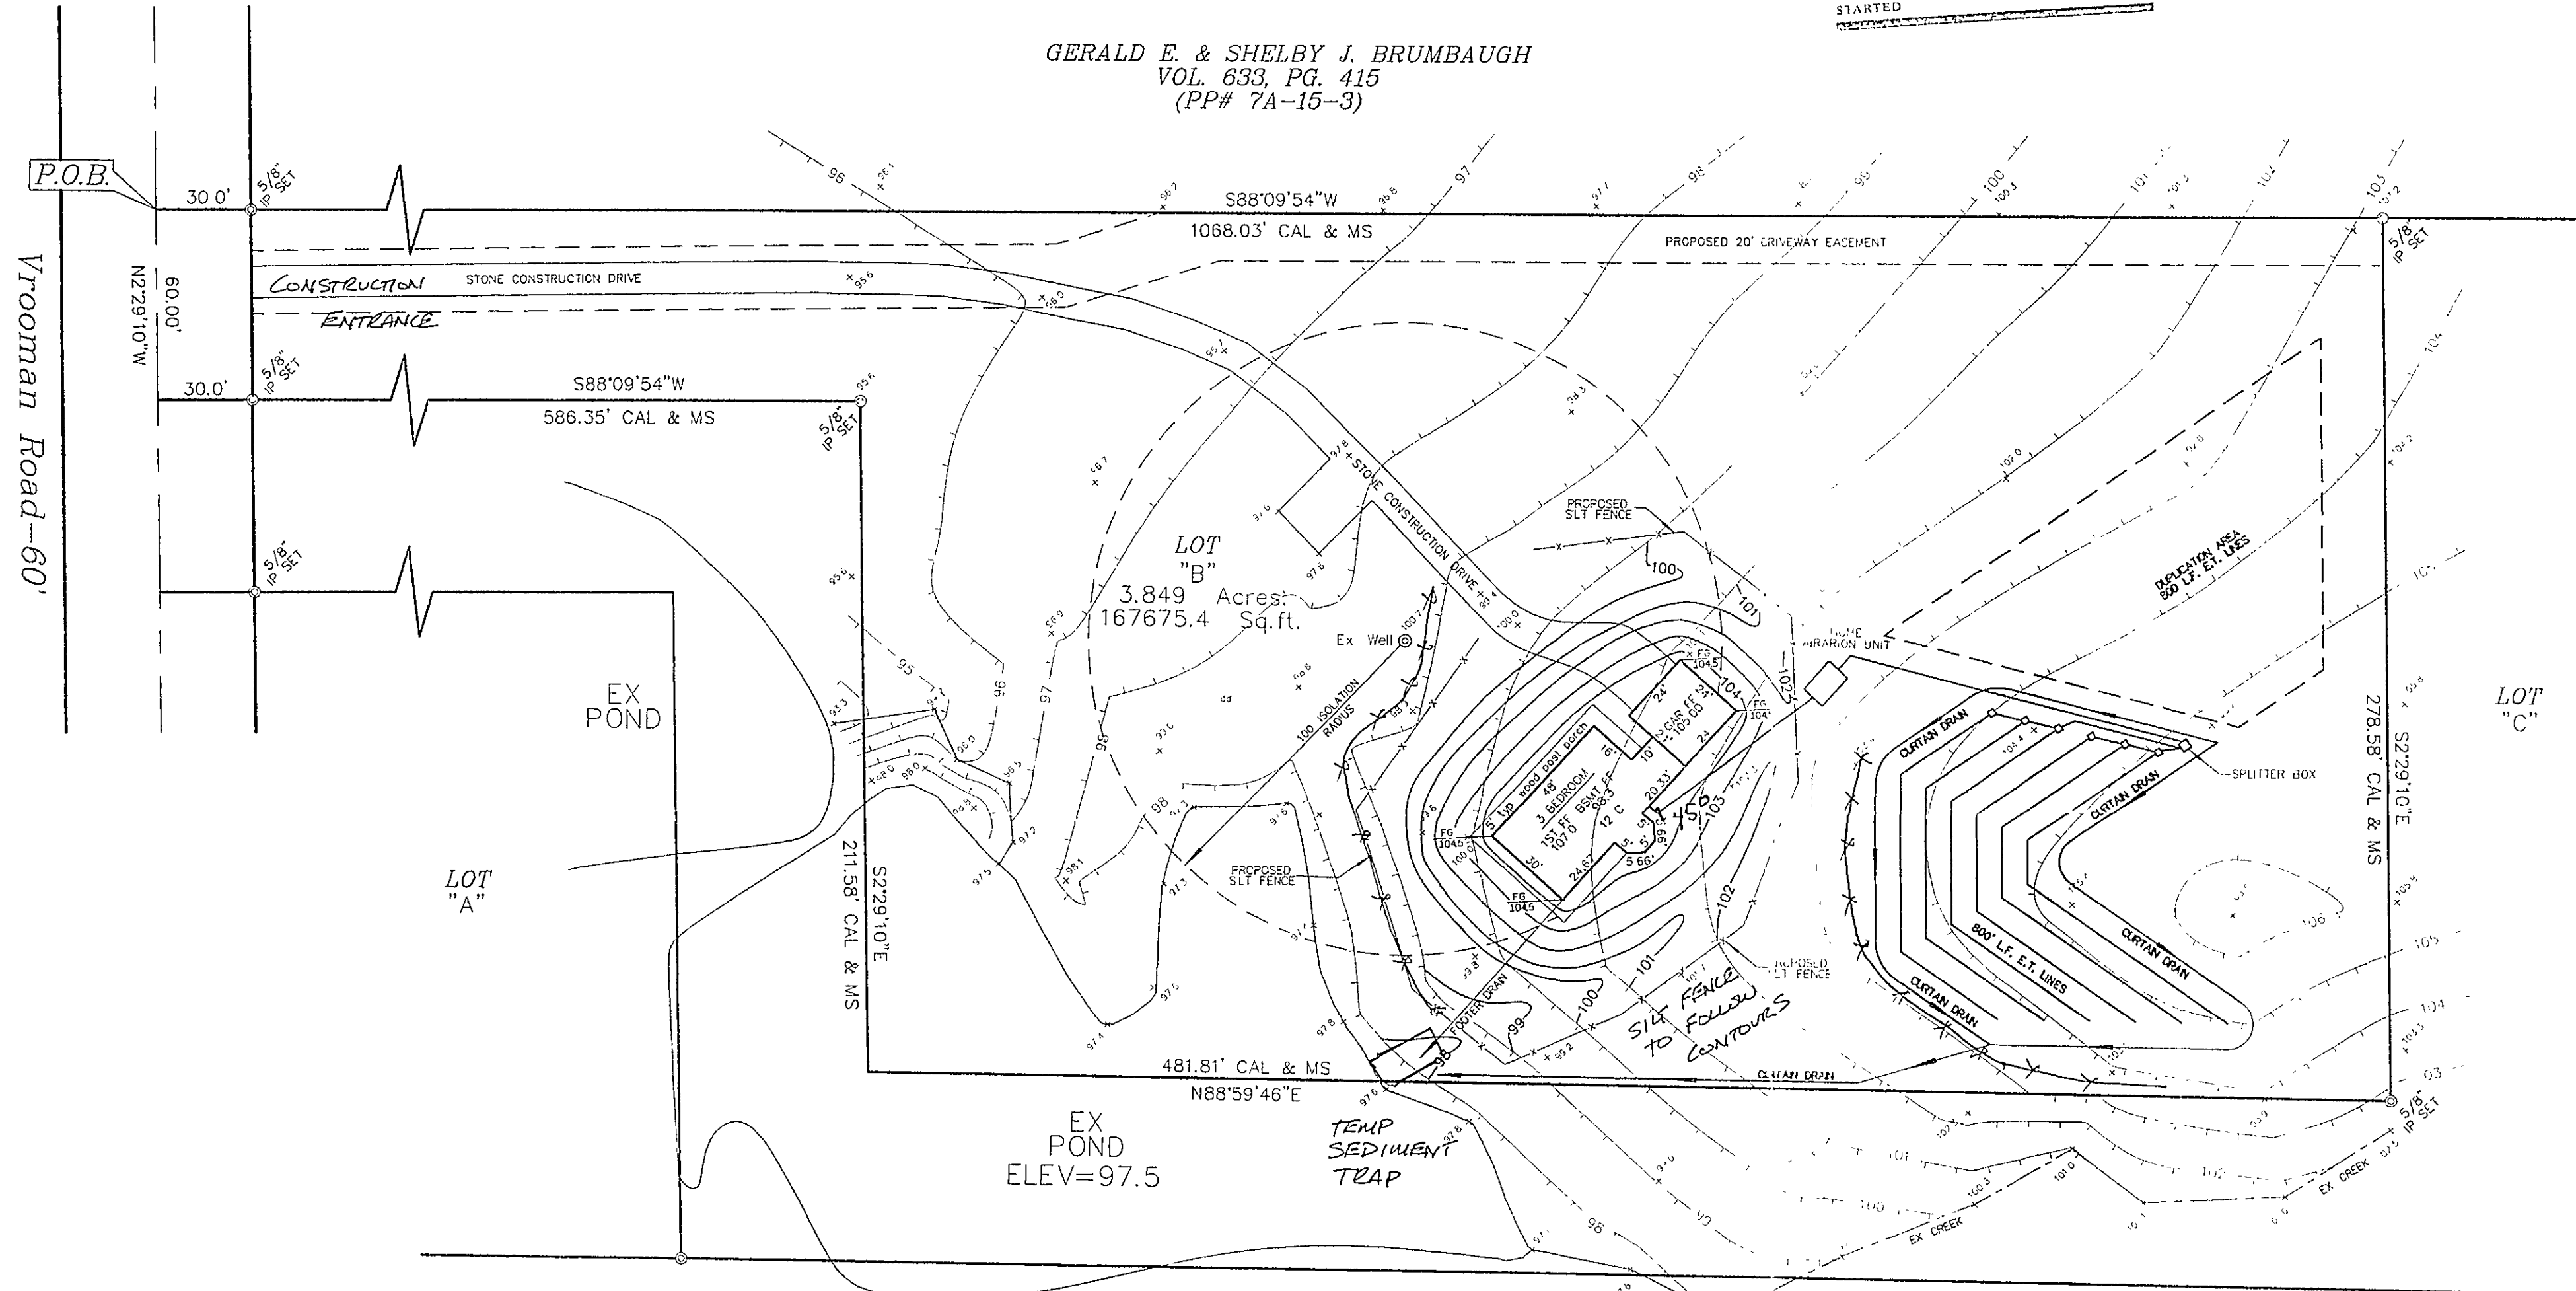


Proposed Site Plan
for
Steven Brothag
The Property of S.J. & S.A. Brothag
Vol. 811, Pg. 561
Part of Original Lot 45
Leroy Township
County of Lake, State of Ohio
April 27, 2004

THIS SITE PLAN WAS DRAWN ON APRIL 27, 2004
IN ACCORDANCE WITH CHAPTER 4733-37 OF THE ADMINISTRATIVE CODE,
FOR MINIMUM STANDARDS FOR BOUNDARY SURVEYS


GERALD E. & SHELBY J. BRUMBAUGH
VOL. 633, PG. 415
(PP# 7A-15-3)

REVIEWED AND ACCEPTED
LAKE COUNTY GENERAL
HEALTH DISTRICT
5-18-04
Dated: *David B. Morris*
SEWAGE DISPOSAL PERMIT MUST BE
OBTAINED BY A LAKE COUNTY LICENSED
INSTALLER BEFORE INSTALLATION IS
STARTED

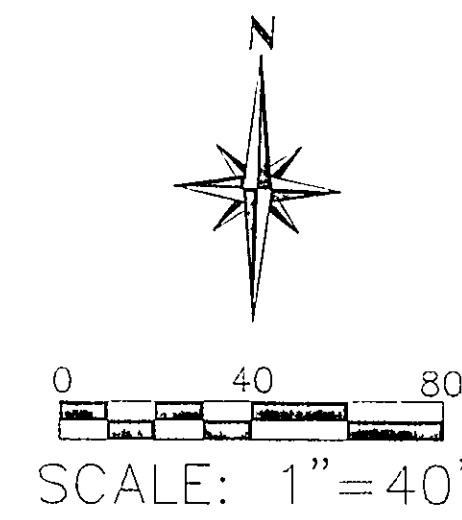

JACOB O. MYLLYKOSKI
INSTRUMENT #200005715
(PP# 7A-15-6)

(Signature) 5-17-04
KEITH B. JONES
REGISTERED LAND SURVEYOR #7794
AAA Land Surveying, Inc.
100 Center Street, Suite 150
Chardon, OH 44024
(440) 286-2393
Drawing No.03-089

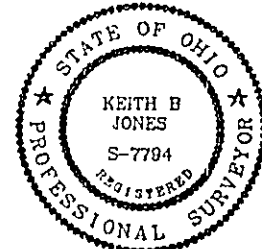

NOTE: ALL DISTURBED AREAS TO BE
TEMPORARILY SEEDDED.
TBM TOP EX WELL
ELEV=100.75

"I, the undersigned hereby certify that
this topography indicated by 6", 1", or 2"
contours, and elevations shown hereon
represent an actual field survey made by
me on the 19th day of Nov., 2003
and that the elevations were taken at
appropriate intervals and that as of that
date they existed as indicated hereon."

(Signature) 5-17-04
Name: *(Signature)* Reg. No. 7794

Erosion and Sediment
Control Site Plan

Erosion and Sediment Control Schedule

Ingress-Egress
A stone access drive complete with under lying geo-textile fabric (20 feet wide and 50 feet long) for ingress and egress at the site shall be installed. This drive shall be the only entrance and exit to the site.

Silt Fence
All silt fence shall be installed prior to any earthwork activities at the site at the locations shown on the site plan as well as along the front of any lot that slopes towards the street.

Temporary Seeding
Disturbed areas of the site that are to remain idle for more than Twenty-one (21) days shall be properly seeded and straw mulched within seven (7) days of completion of initial grading. Temporary seeding and mulching of a thirty (30) foot strip of the entire front of the lot shall be maintained on the site once initial grading is complete.

Stabilization of critical areas within fifty (50) feet of any stream or wetland shall be complete within two (2) days of the disturbance if the site is to remain inactive for longer than fourteen (14) days.

Mulching
Straw-mulch shall be applied at a rate of 1 bale per every ten (10) feet of curb, at a width of thirty (30) feet of the entire length of the lot. Wood chips may also be used but must be spread at a minimum depth of four inches over the thirty-foot width and must be accompanied by a properly installed silt fence.

Maintenance
Erosion and sediment controls shall be inspected every seven (7) days or within 24 hours of a 0.5" or greater rainfall event. Necessary repairs shall be made at this time.

Note:
All erosion and sediment control specifications, applications, and timetables are based on the descriptions and standards of The Ohio Department of Natural Resources "Rainwater and Land Development Manual" and can be found in the Lake County Erosion and Sediment Control Rules as adopted December 21, 1999.


The specified erosion and sediment control standards are general guidelines and shall not limit the right of the county to impose, at any time, additional, more stringent requirements than the standards and the right of the county to




125 East Erie Street Phone: (440) 350-2730
Painesville, Ohio 44077 Fax: (440) 350-2601
www.lakecountyohio.org/soil

HOOF DRAINS
SHALL DISCHARGE
TO SPLASH BLOCKS.


Stormwater Management Plan
Approved as shown and/or noted
JAMES R. GILLS, P.E.
County Drainage Engineer
By *(Signature)* Date 5/27/04

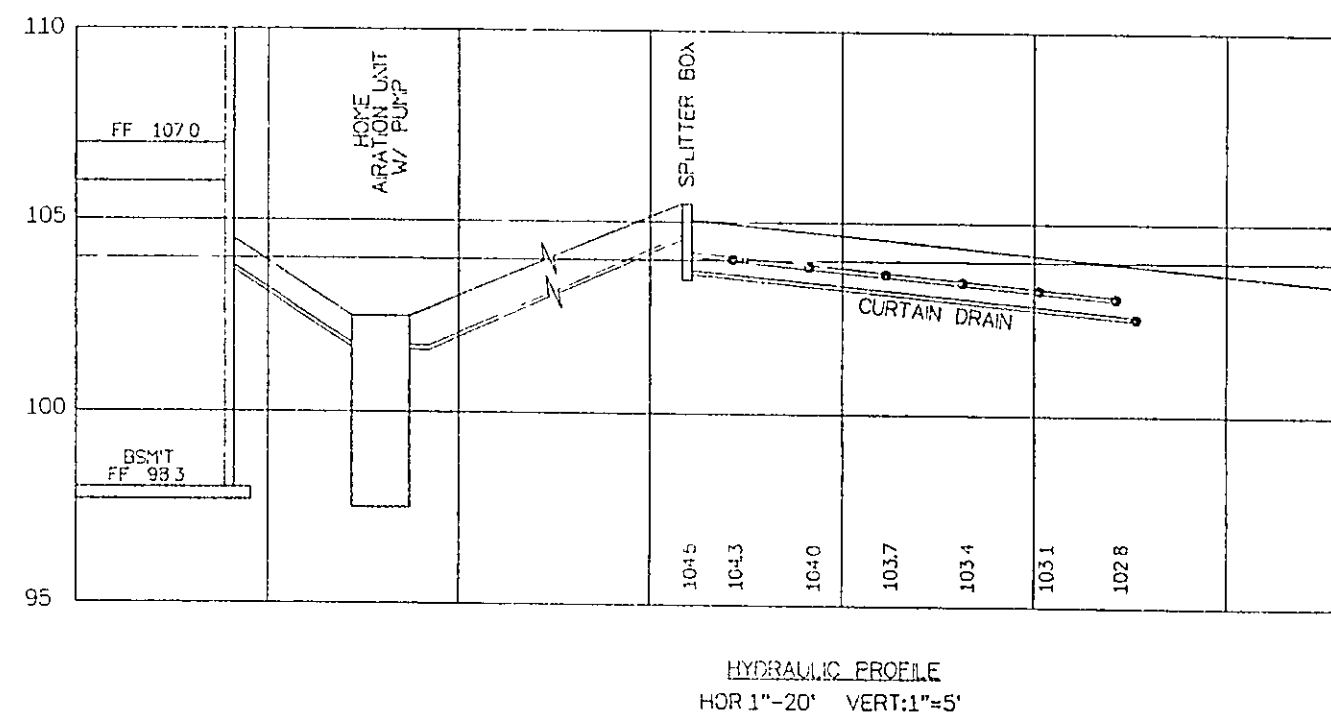



Construct

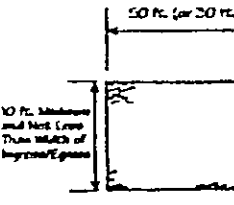

PROFILE

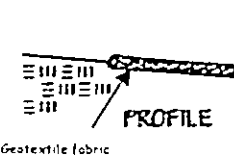

Silt

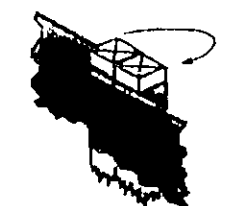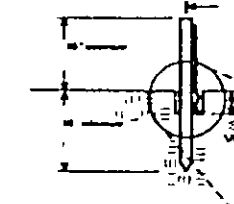

Temporary

Seeding Dates	Species
March 1 to August 15	Grass
August 15 to November 1	Grass
November 1 to Spring Seeding	Grass