

VILLAGE SURVEYING Co.
P.O. BOX 1096, FAIRPORT HBR, OH 44077
(440) 357-1359

SITE PLAN
FOR
ROBERT HOYT
BEING KNOWN AS 3/4 OF THE HANDFAST SUBDIVISION
A PART OF ORIGINAL LOT 46 IN LEROY TOWNSHIP,
LAKE COUNTY, OHIO.

SCALE: 1"=20'

I, the undersigned hereby certify that
this topography, indicated by 1' contours
and elevations shown hereon represent an
actual field survey made by me on DEC 10 1988
and that the elevations were taken at
appropriate intervals and that as of that
date they existed as indicated hereon.

JAN 6 2000
REV 1-20-2000

REVIEWED AND ACCEPTED
LAKE COUNTY GENERAL
HEALTH DISTRICT

DATE 1-25-00 BY
David B. Morris RS

SEWAGE DISPOSAL PERMIT MUST BE
OBTAINED BY A LAKE COUNTY LICENSED
INSTALLER BEFORE INSTALLATION IS
STARTED



WILLIAM A. JANOUSKOVEC
V.1053-345

LEROY THOMPSON
POST No. 7939
V.885-419

WALLACE W. & RUTH J. WILDER
V.873-362

JAMES E. & JOANN M. BRICKELL
V.631-779

JANET L. D'ABATE
V.517-102

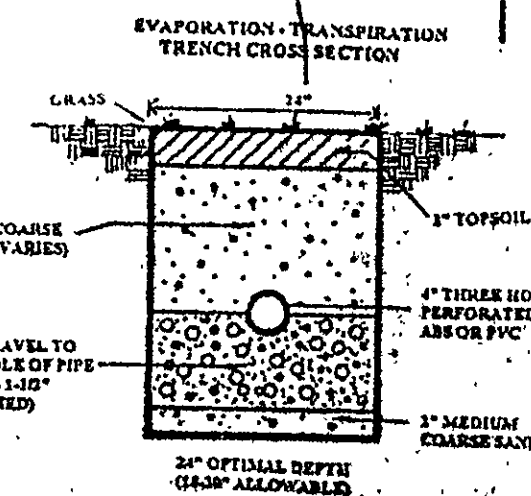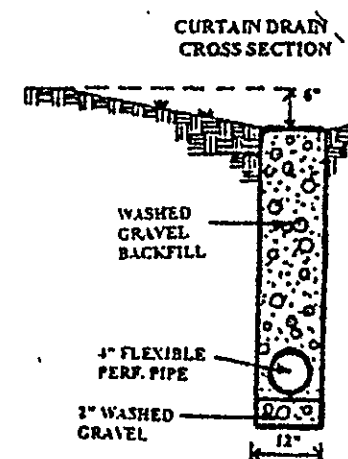

*GRINDER PUMP REQUIRED
IF PLUMBING IN BASEMENT

Grading Plan Approved
as shown and/or noted
THOMAS P. GILLES, P.E.
Lake County Engineer

By GJH Date 02/16/00
15" Drive Culvert