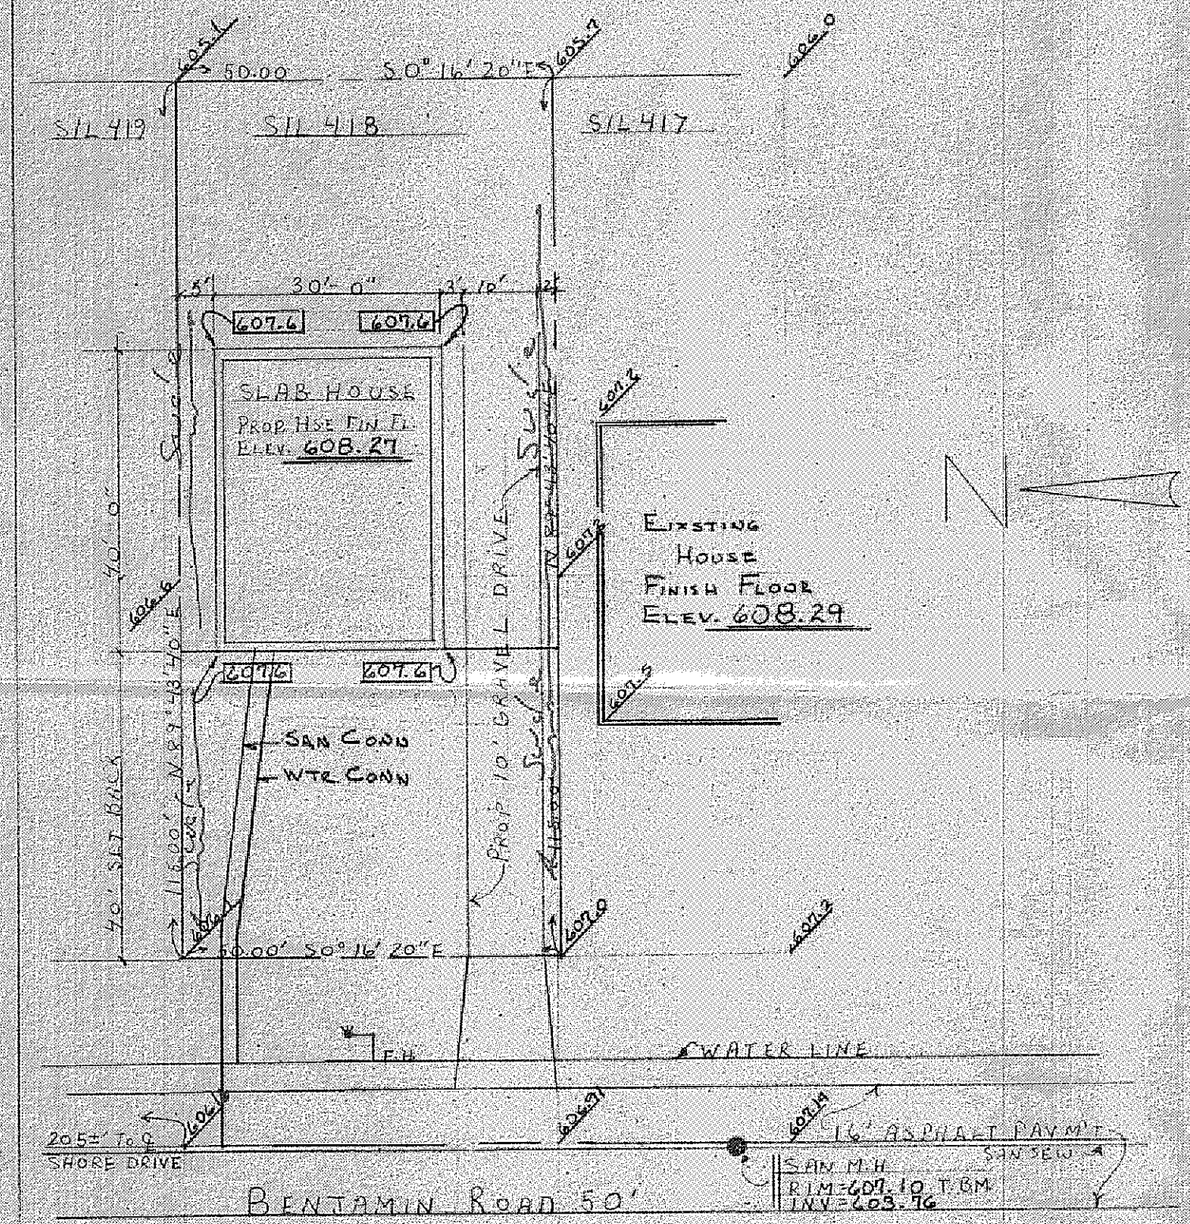

Grading Plan Approved
as shown and/or noted
THOMAS P. GILLES, P.E.
Lake County Engineer
By ___ Date 25 Oct 77

Zoning Perm. # No
9965

SITE PLAN FOR:

PAC HOMES
812 NEARING CIRCLE
GENEVA, OHIO
BEING SUBLOT 418 IN THE
MADISON GOLF LAKELANDS SUBDIVISION
IN MADISON TOWNSHIP, OHIO

PREPARED BY:

WM. GRAY ASSOC. INC.
7547 MENTOR AVE
MENTOR, OHIO
SCALE: 1" = 20'
DATE: SEPT. 15 1977

CERTIFICATION:

I HEREBY CERTIFY THAT THIS PLAT IS CORRECT TO THE BEST OF MY KNOWLEDGE
BY: Wm. R. Gray
WM. R. GRAY REG. SURV. # 2752

STATE OF OHIO
WM. R. GRAY
2752
REGISTERED
PROFESSIONAL SURVEYOR