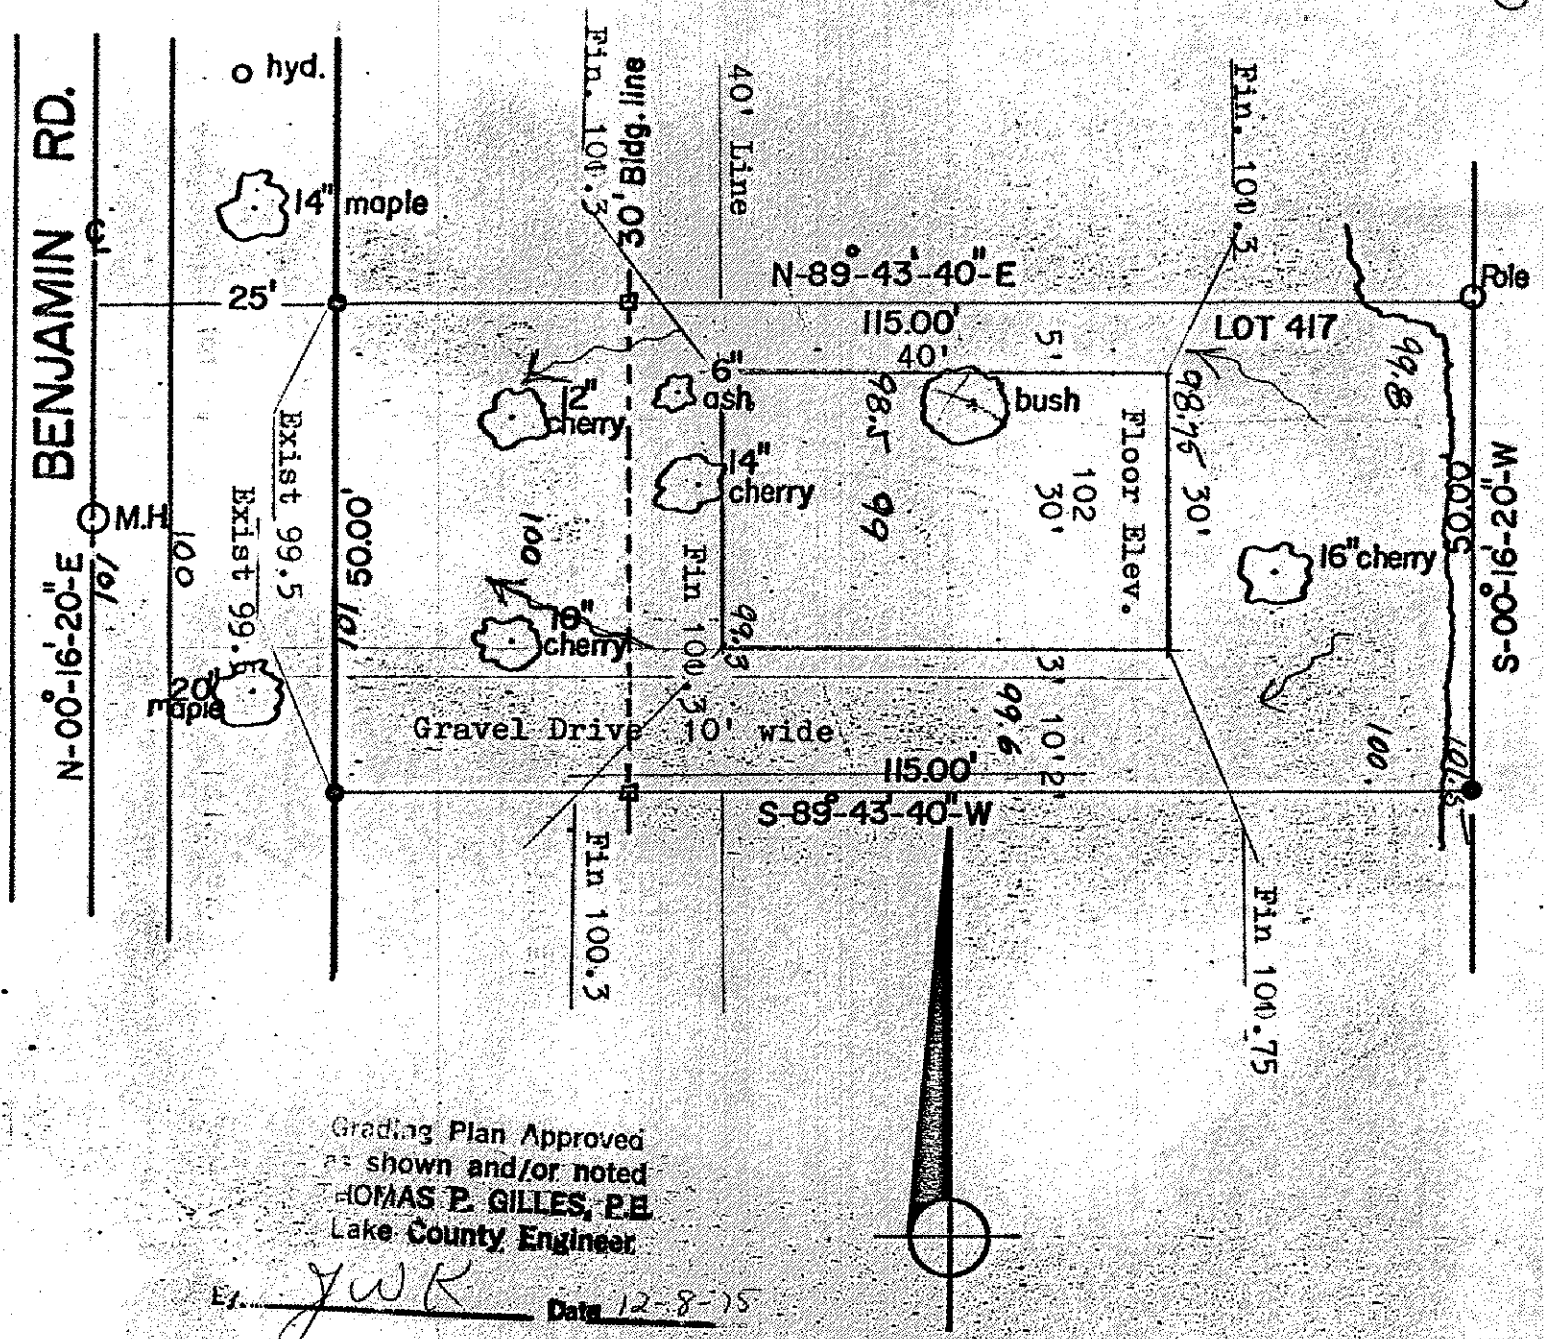

Grading Plan Approved
as shown and/or noted
THOMAS P. GILLES, P.E.
Lake County Engineer
By JWK Date 12-8-75

SURVEY
for
Pac Homes
Madison Golf Lakelands Subdivision, Lot 417
Vol. E-Pg. 68 recorded plats

Lake Co. Ohio
Sept., 1975 1"=20'

STATE OF OHIO
THOMAS
GROMLEY
4848
REGISTERED
SURVEYOR

Thomas L. Gromley
Reg. Surveyor 4848

ZP #9237