



APPROVED
 BLACKSTON TWP. ZONING
 Permit: 13711
 Zoning Inspector: [Signature]
 APR. 01 1993

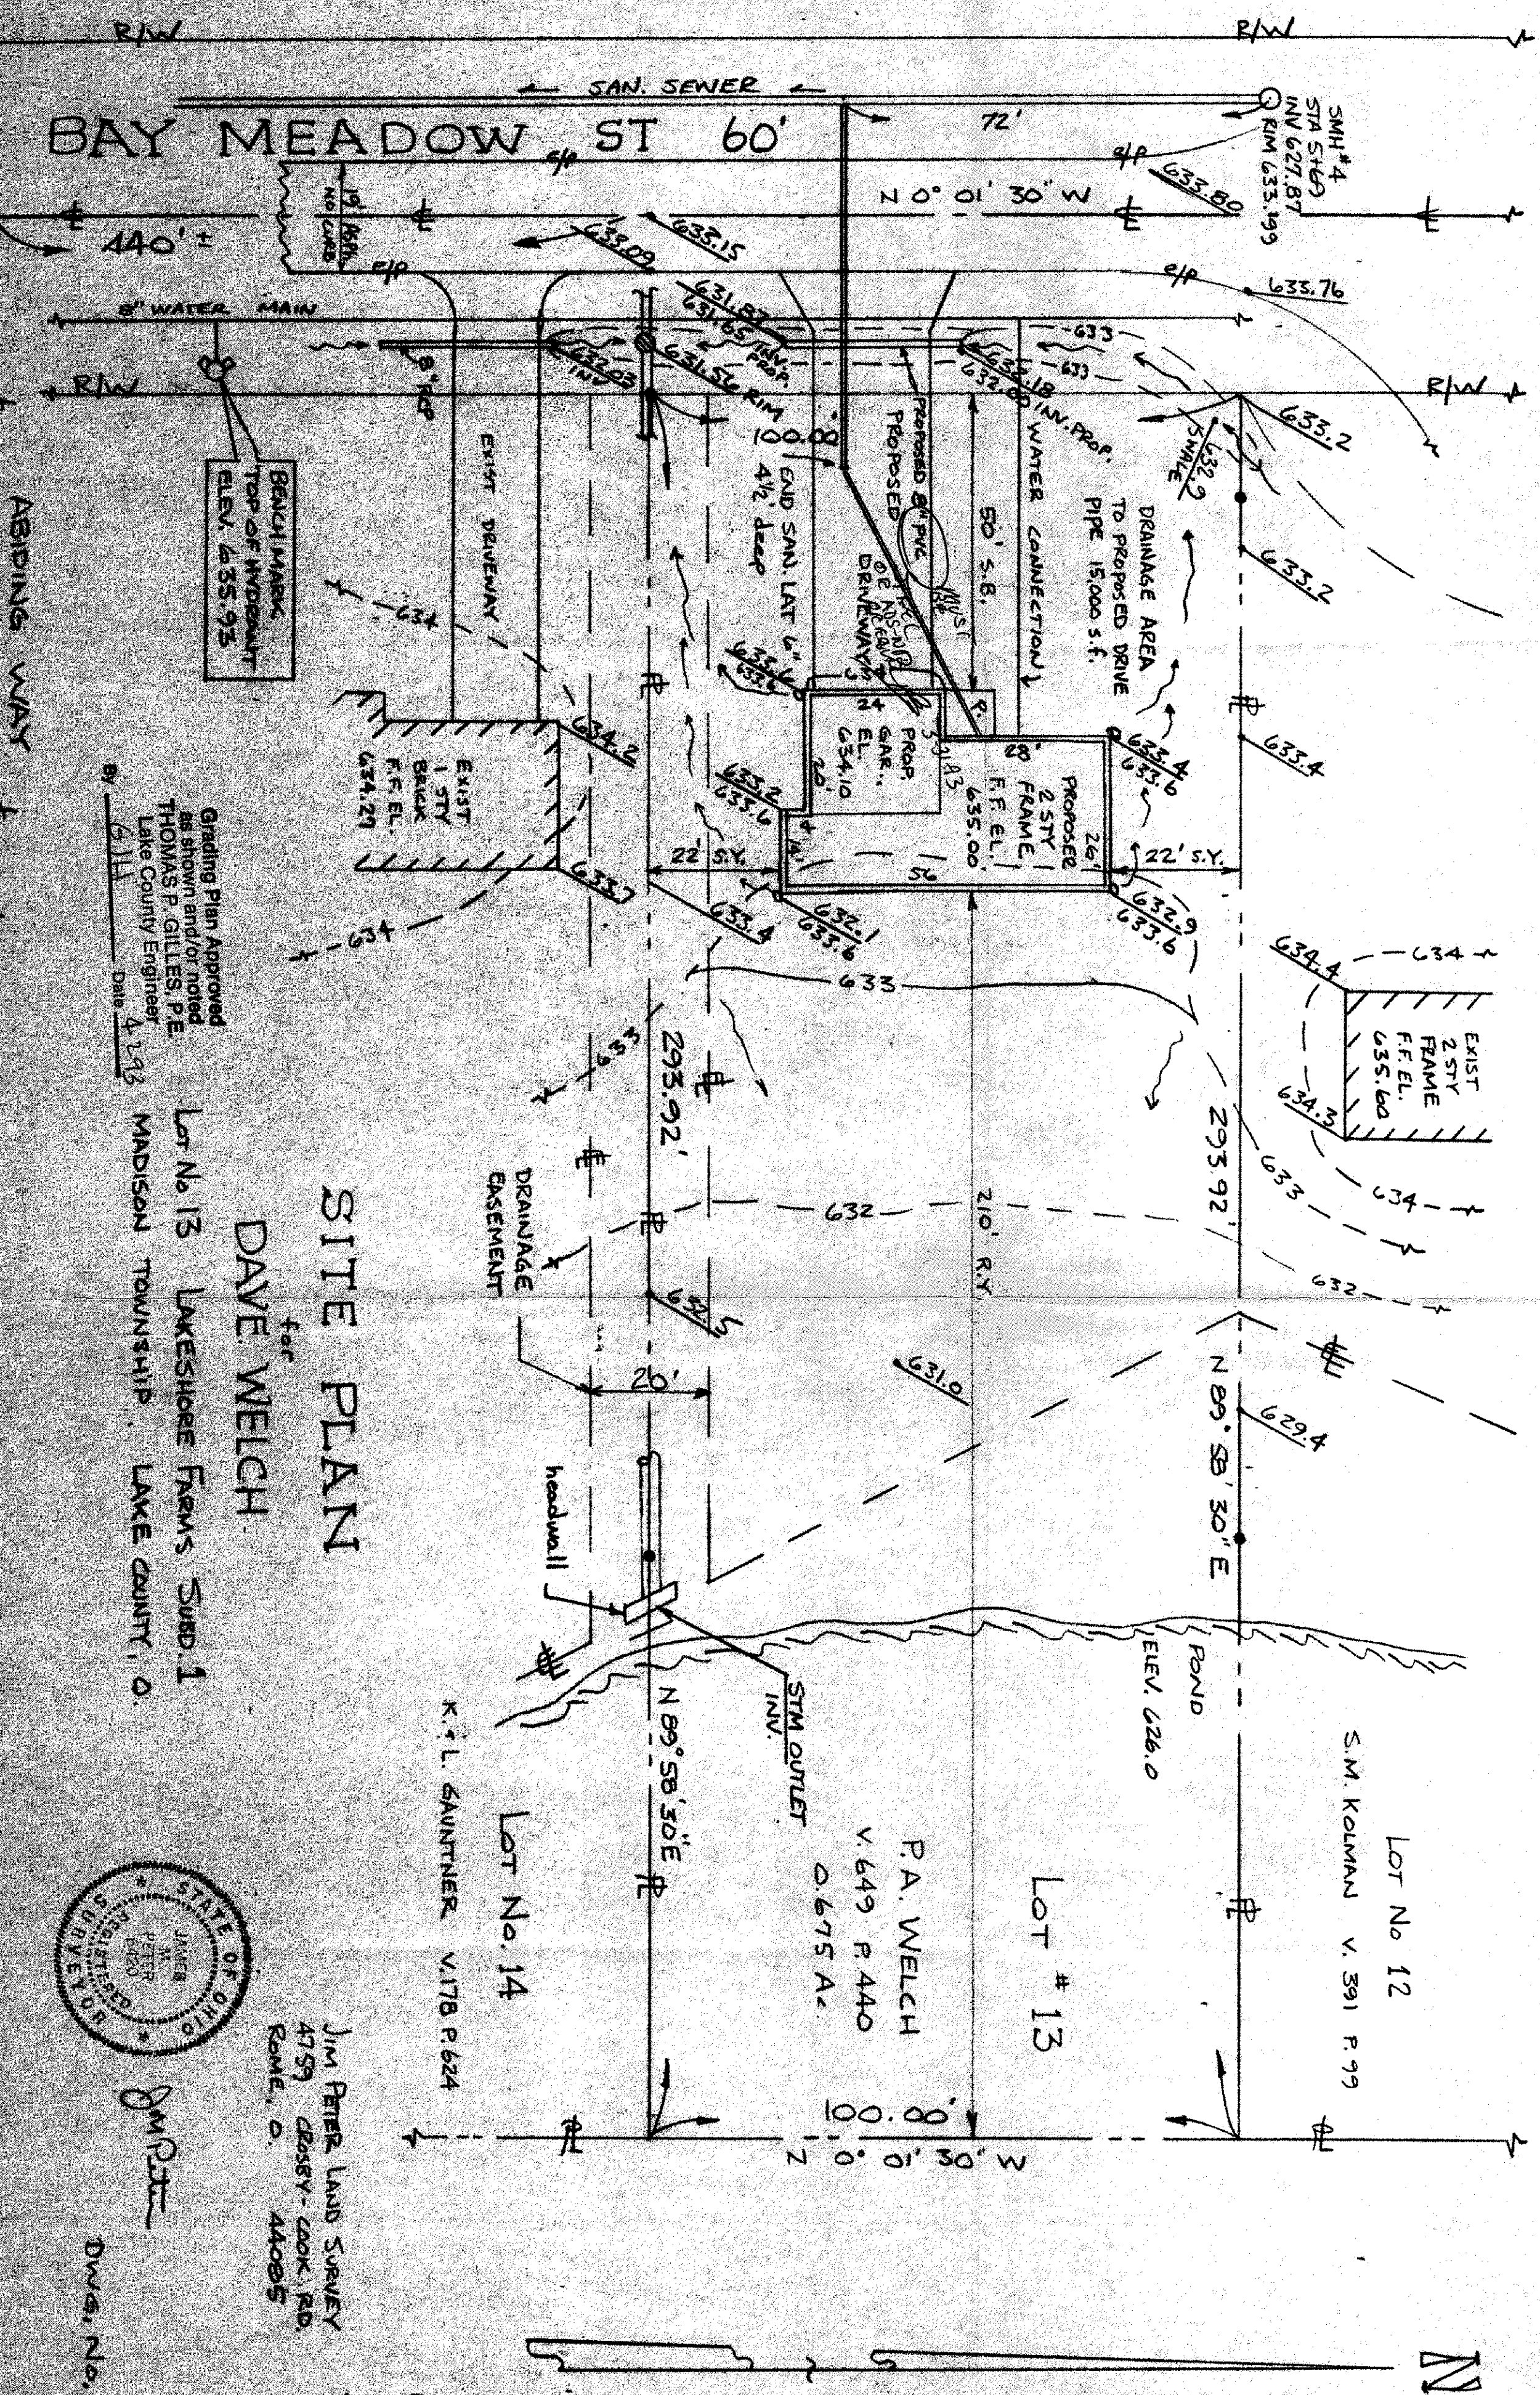

SITE PLAN for DAVE WELCH

Grading Plan Approved
 as shown and/or noted
 THOMAS P. GILLES, P.E.
 Lake County Engineer
 Date 4-1-93

Lot No. 13 LAKESHORE FARMS SUBD. 1
 MADISON TOWNSHIP LAKE COUNTY, O.

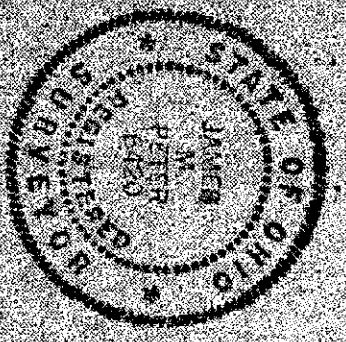

Jim Peter, Land Surveyor
 4759 Cressy - Cook Rd.
 Rome, O. 44085

SCALE:
 1" = 20 ft.

MAR. 29, 1993

DWG. No. 930305