



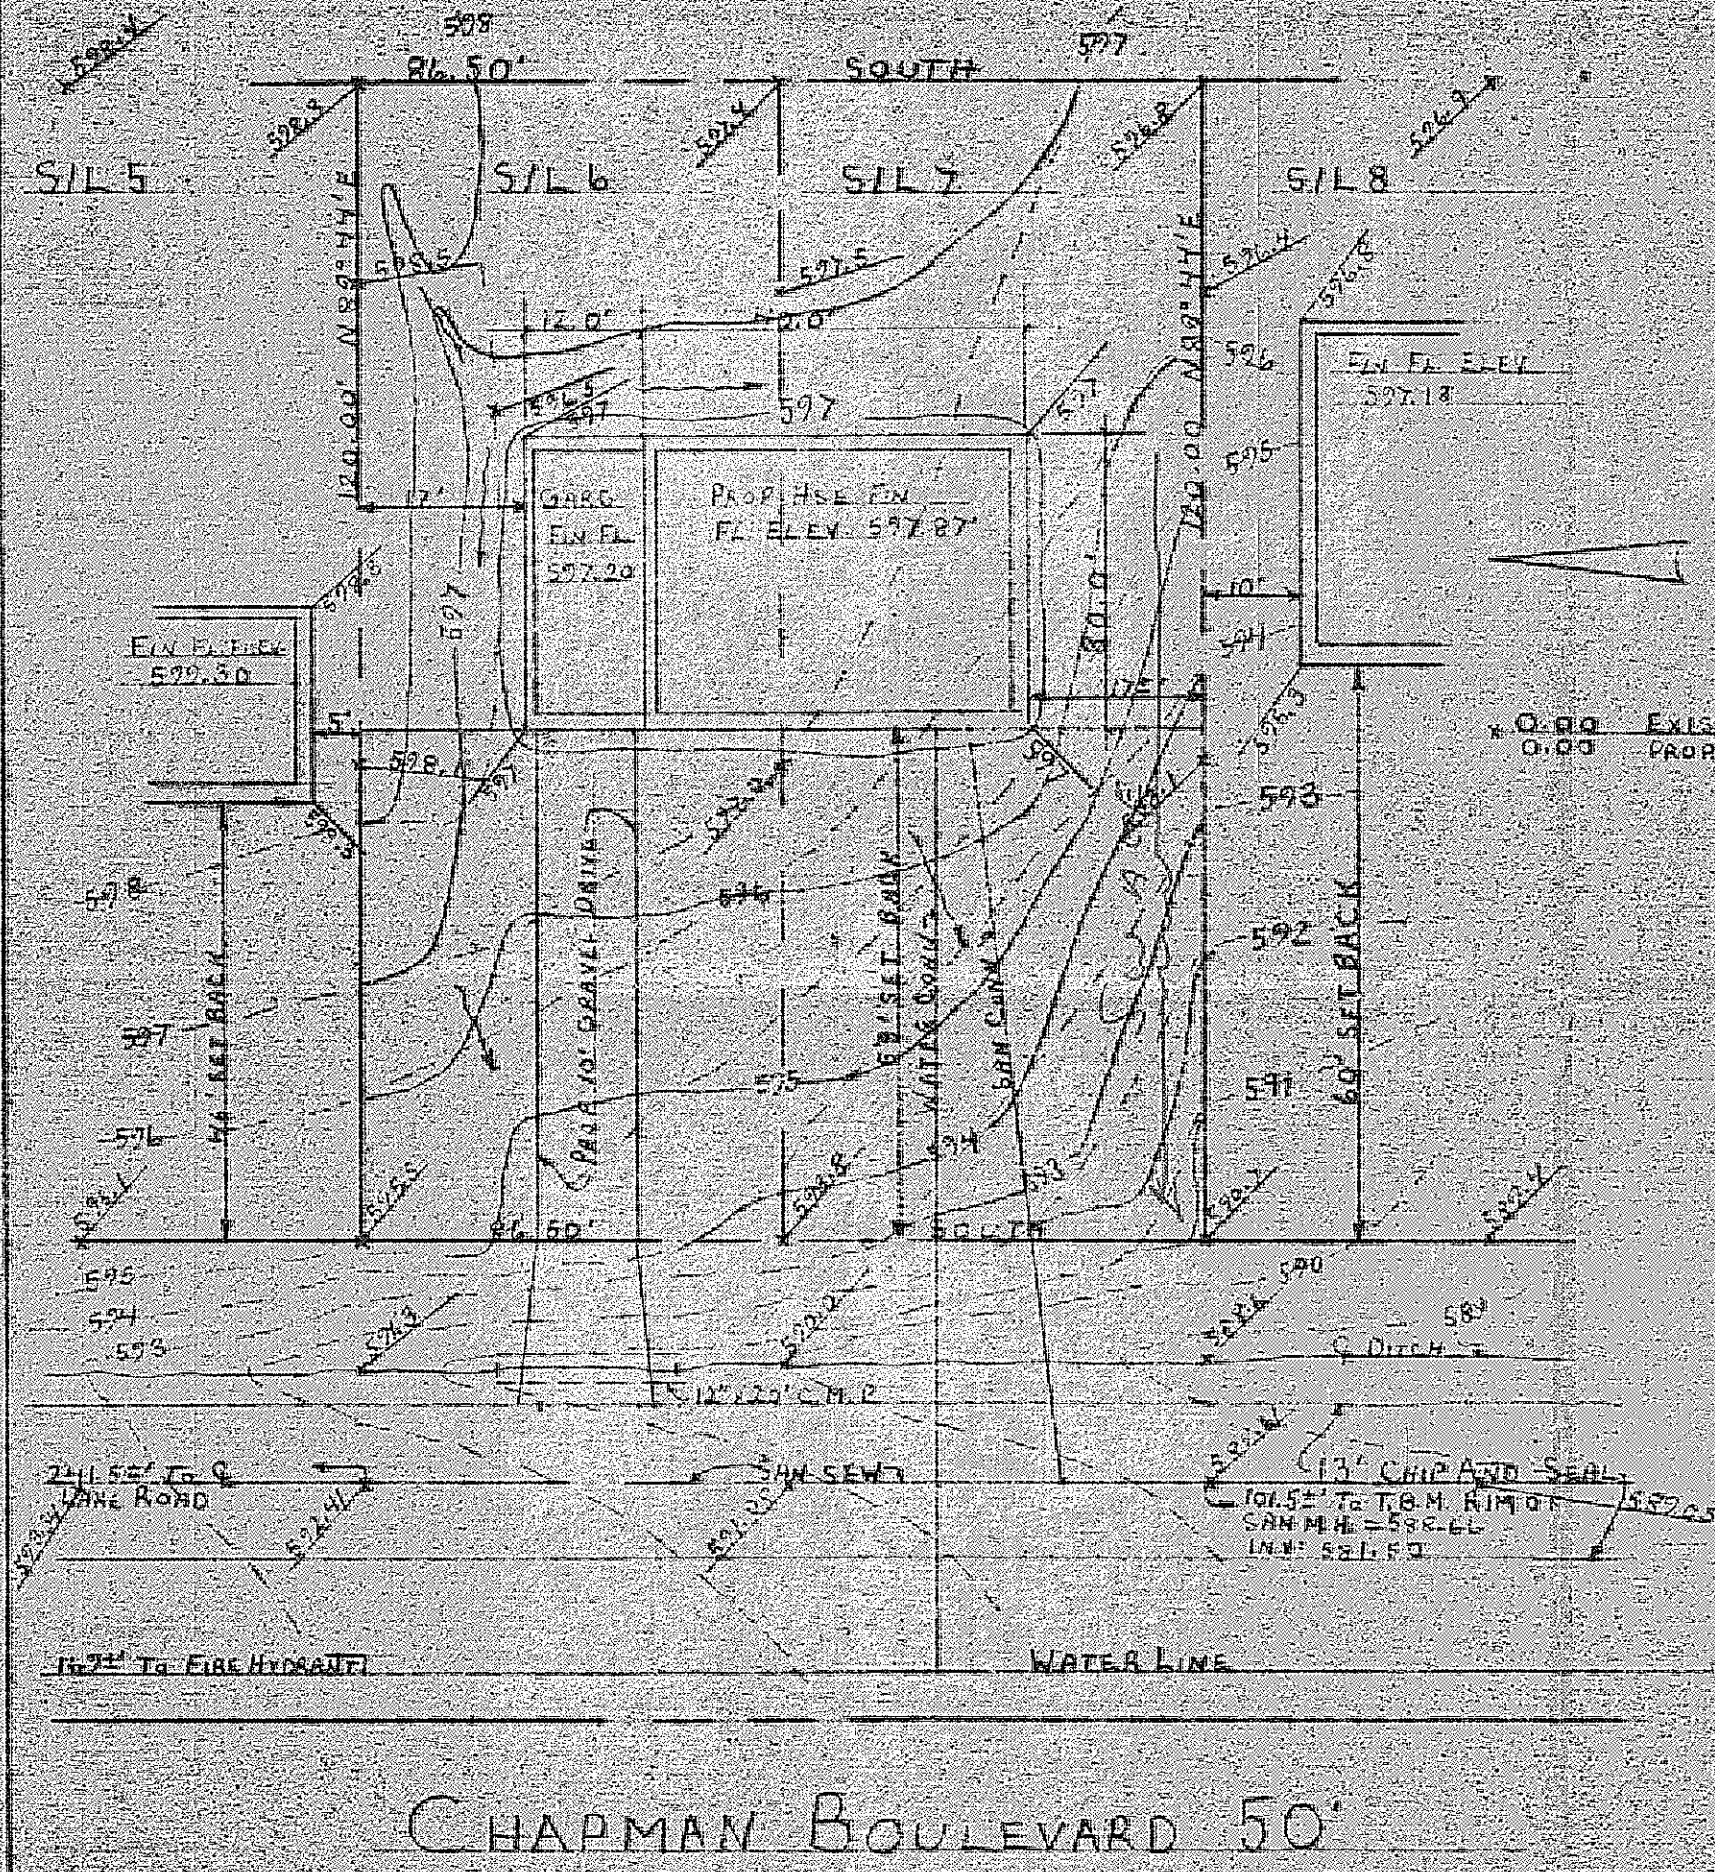

Grading Plan Approved
 as shown and/or noted
 THOMAS P. GILLES, P.E.
 Lake County Engineer
 By 720 Date 9/10/77

SITE PLAN FOR:
JACK TAYLOR
8330 BRIDLE COURT
MENTOR, OHIO
 BEING SUBLOTS 6 AND 7 IN THE
 PARKVIEW SUBDIVISION IN MADISON
 TOWNSHIP, OHIO

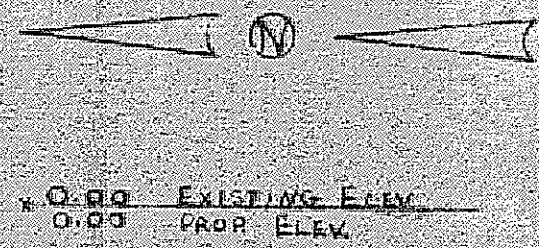

PREPARED BY:
WM. GRAY ASSOC. INC.
7547 MENTOR AVE
MENTOR, OHIO
 SCALE: 1" = 20'
 DATE: OCT 25, 1977

CERTIFICATION:
 I HEREBY CERTIFY THAT THIS
 PLAT IS CORRECT TO THE BEST
 OF MY KNOWLEDGE
 BY: Wm. R. Gray
 WM. R. GRAY REG. SURV. #2152

APPROVED
 MADISON TWP. ZONING
 Permit: 10027
 Zoning Inspector: R. L. Brown

