


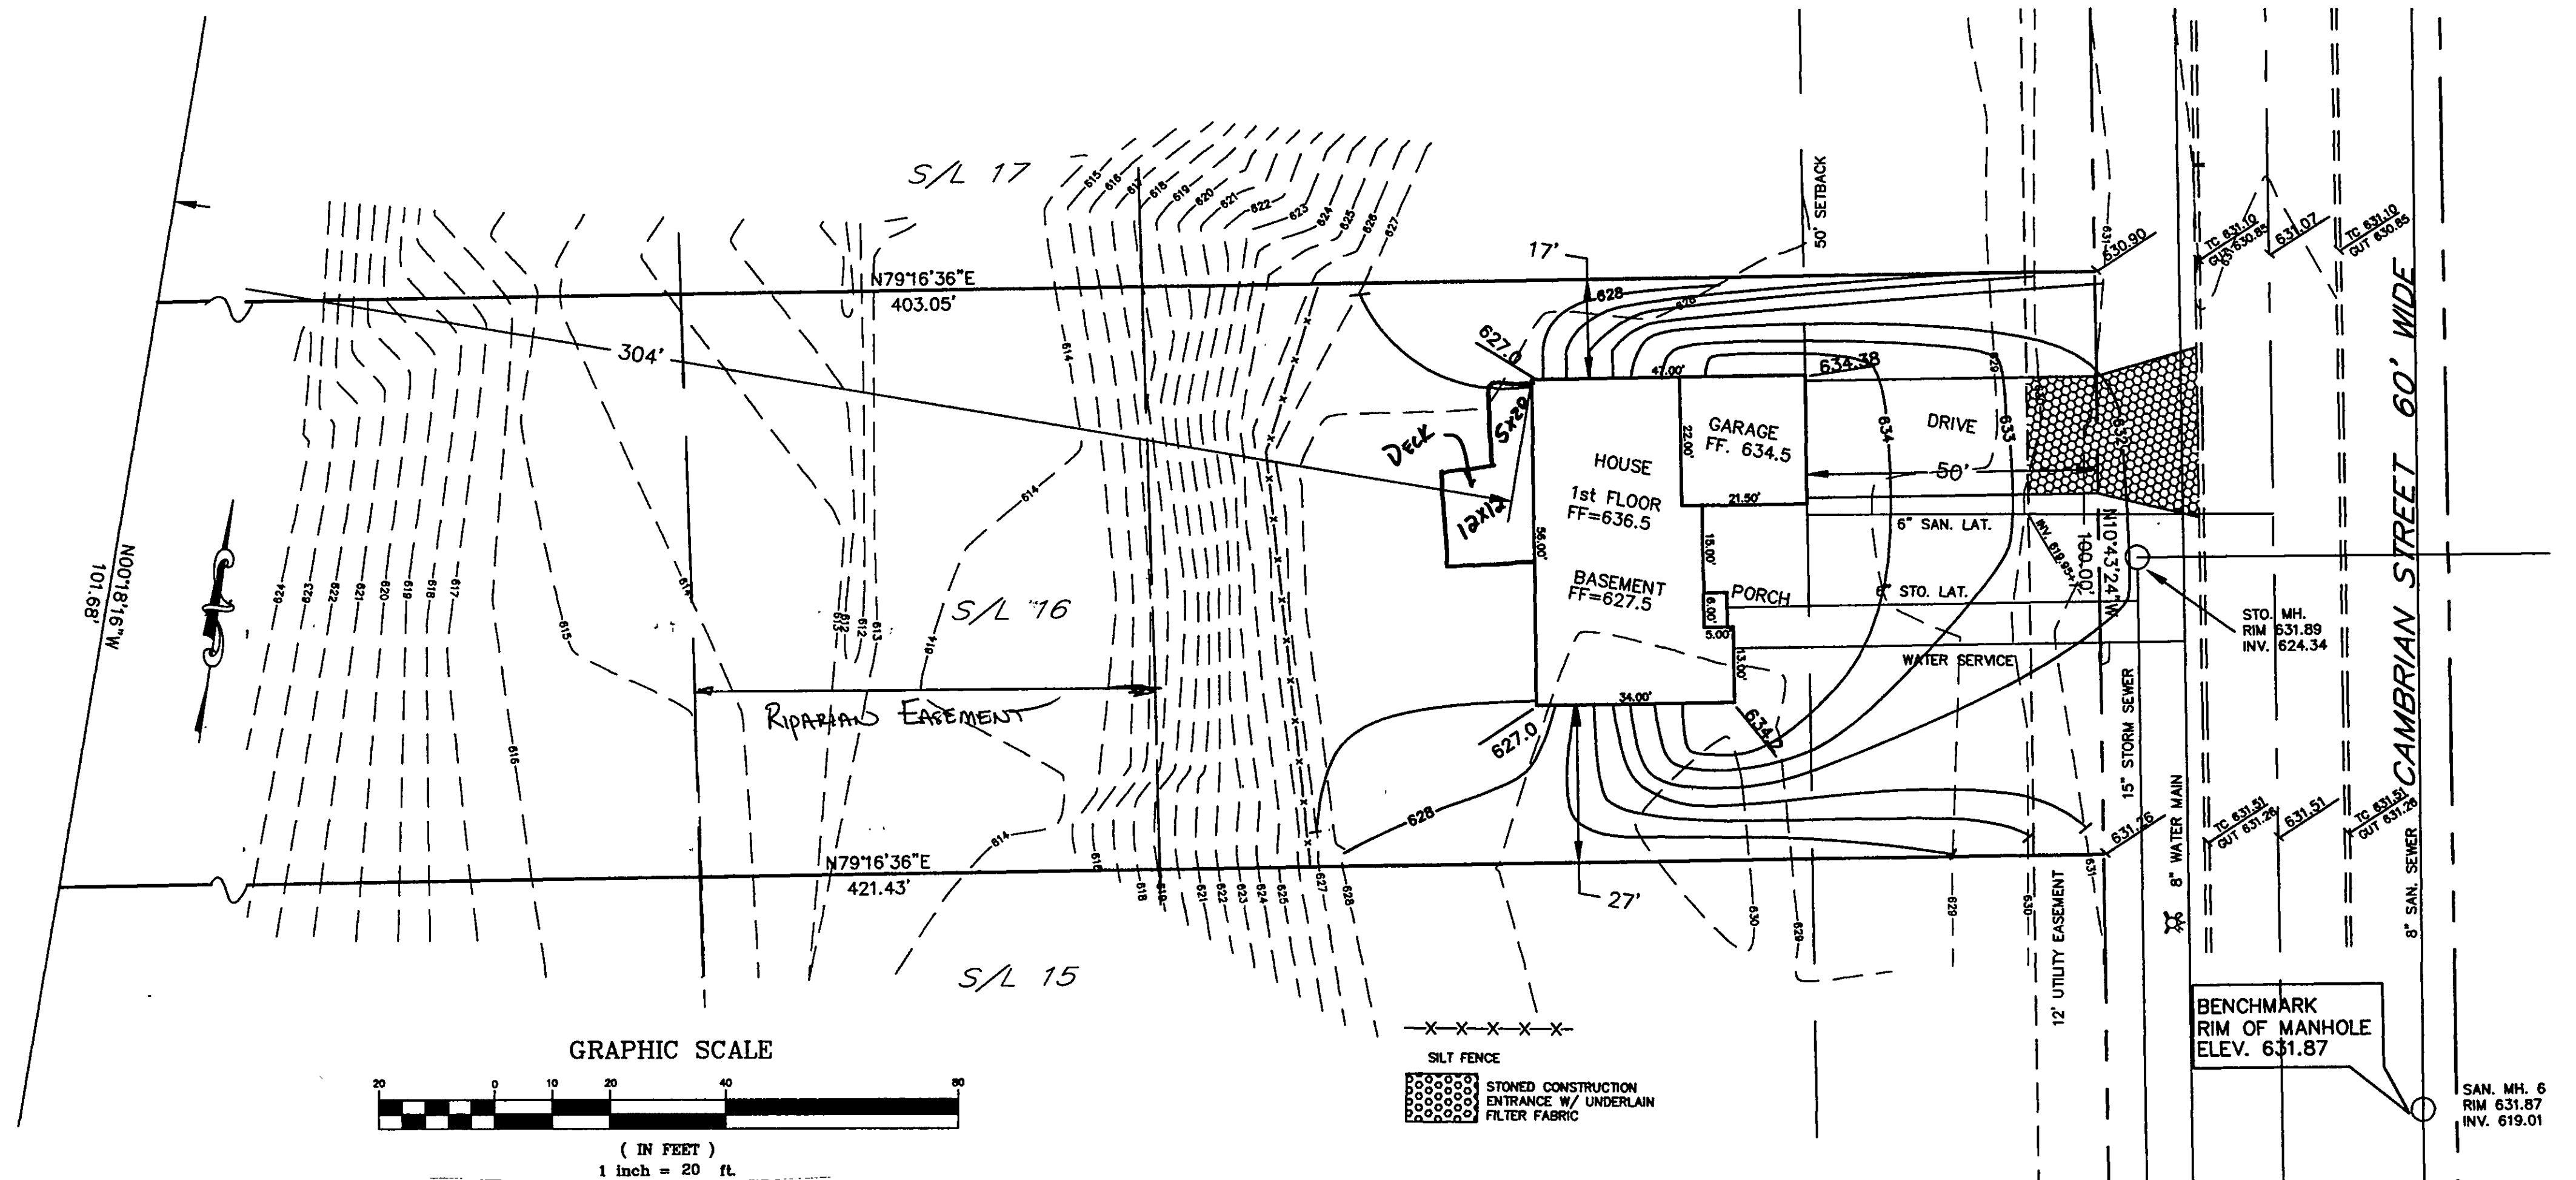

I, the undersigned hereby certify that this topography, indicated by 1' contours and elevations shown hereon represents an actual field survey made by me in DEC., 2006 and that the elevations were taken at appropriate intervals and that as of that date they existed as indicated hereon.

David A. Rapp



- NOTES:**
1. The Contractor Shall Verify the Following Before Starting:
Finish Floor Elevations and House Size.
Location and elevation of existing utility connections.
 2. Contractor Shall Contact OUPS at least 2 Working Days prior to construction, 1-800-362-2764.

D-26079

DAVID RAPP SERVICES

3406 DAYTON ROAD MADISON, OHIO 44057
Stormwater Management Plans
Approved as shown and/or noted

DATE: DEC. 2006
DRAWN BY: DAR
APPROVED BY: DAR
P.S. No. 7597

REALITY BUILDERS
COLLEGE GREEN BUILDERS
MADISON MEADOWS SUBDIVISION
Site Plan For Sublot 16

Erosion and Sediment Control Schedule

Ingress-Egress
A stone access drive complete with under lying geo-textile fabric (20 feet wide and 50 feet long) for ingress and egress at the site shall be installed. This drive shall be the only entrance and exit to the site.

Silt Fence
All silt fence shall be installed prior to any earthwork activities at the site in the locations shown on the site plan as well as along the front of any lot that slopes towards the street.

Temporary Seeding
Disturbed areas of the site that are to remain idle for more than thirty (30) days shall be properly seeded and straw mulched within seven (7) days of completion of initial grading. Temporary seeding and mulching of a thirty (30) foot strip of the entire front of the lot shall be maintained on the site once initial grading is complete.

Stabilization of critical areas within fifty (50) feet of any stream or wetland shall be complete within two (2) days of the disturbance if the site is to remain inactive for longer than fourteen (14) days.


Mulching
Straw-mulch shall be applied at a rate of 1 bale per every ten (10) feet of curb, at a width of thirty (30) feet of the entire length of the lot. Wood chips may also be used but must be spread at a minimum depth of four inches over the thirty-foot width and must be accompanied by a properly installed silt fence.

Maintenance
Erosion and sediment controls shall be inspected every seven (7) days or within 24 hours of a 0.5" or greater rainfall event. Necessary repairs shall be made at this time.

Temporary Seeding Specifications

Seeding Date	Species	LB./1,000 sq. ft.	Per Acre

Construction Entrance Detail

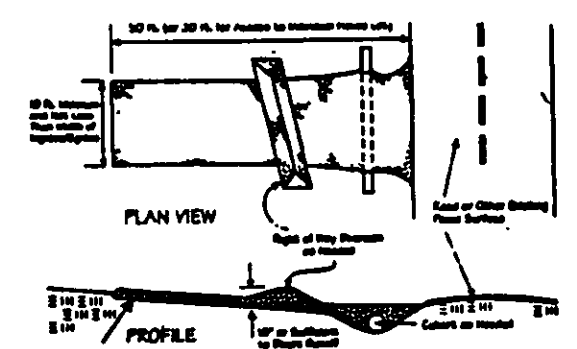

Silt Fence Detail

