
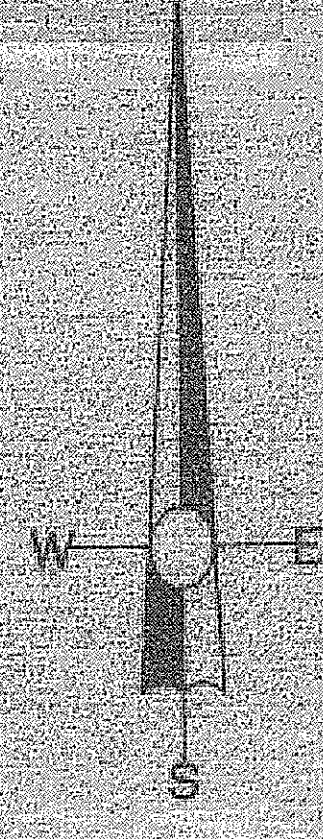


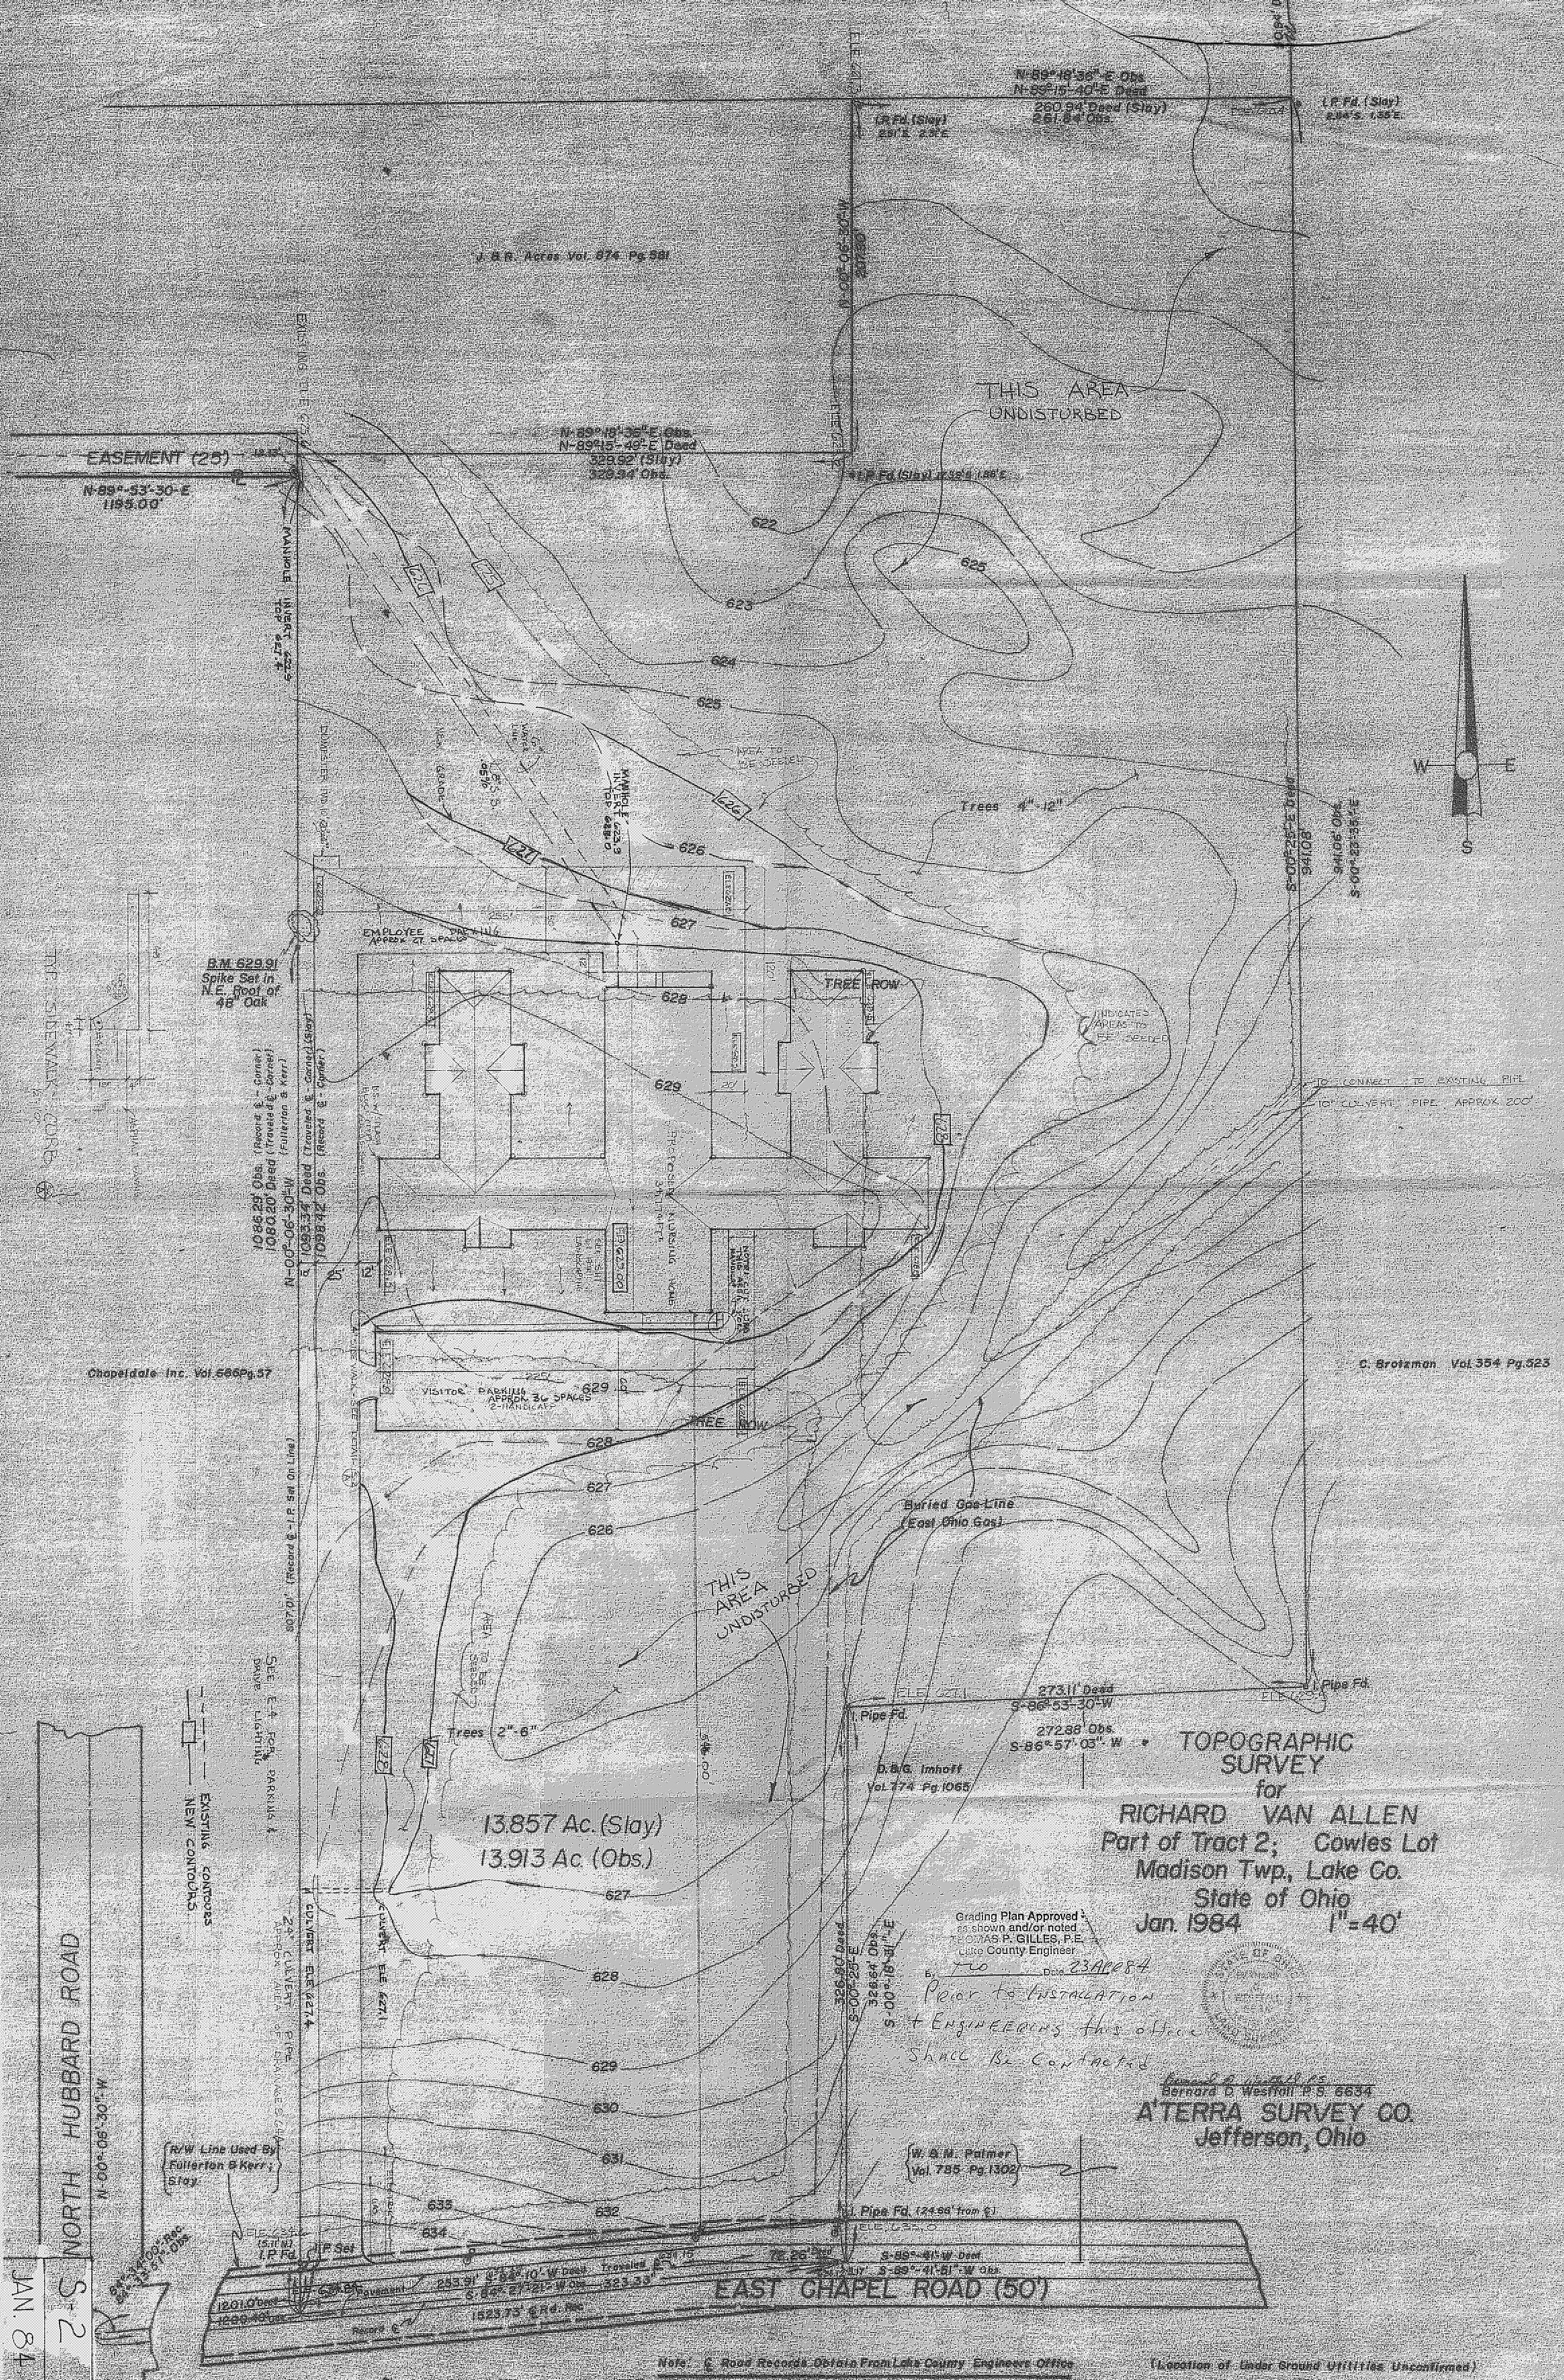

2 S NORTH HUBBARD ROAD
S-00°-05'-30"-W
JAN. 84

EXISTING CONTOURS
NEW CONTOURS

R/W Line Used By
Fullerton & Kerr
Slay

1201.0' Obs.
1200.0' Obs.


JAN. 84

EAST CHAPEL ROAD (50')