

PLAT OF ACREAGE TRANSFER
& SITE PLAN
DAVID LAYMAN

BEING A PART OF LOT 6, PAINE TRACT
IN THE TOWNSHIP OF MADISON, COUNTY
OF LAKE, STATE OF OHIO.

HOWARD L. PRINCE
V. 511-134

DAVID & DIANA LAYMAN
V. 129-1056
0.5516 AC.

DAVID L. & DIANA LAYMAN
V. 126-272

DUPLICATION
AREA

Residue: 0.519 AC.



LAKE COUNTY GENERAL RESUME REQUIRED	
Date	8-9-90
JOEL 1980A, P.E.	
Health Commission	
BY <i>Spunbryne</i>	

- A. To be brought to finished grade
1. Suction tank manhole covers
 2. Suction tank cover
 3. Distribution box cover
- B. No footer drains or downspouts
to be discharged into septic tanks
C. All waste water to be discharged into 50' W
septic tanks

GERARD M. HUGHES, JR.
V. 93-176


Grading Plan Approved
as shown and/or noted
THOMAS P. GILLES, P.E.
Lake County Engineer
By *G.H.* Date 8/14/90

VILLAGE SURVEYING CO.

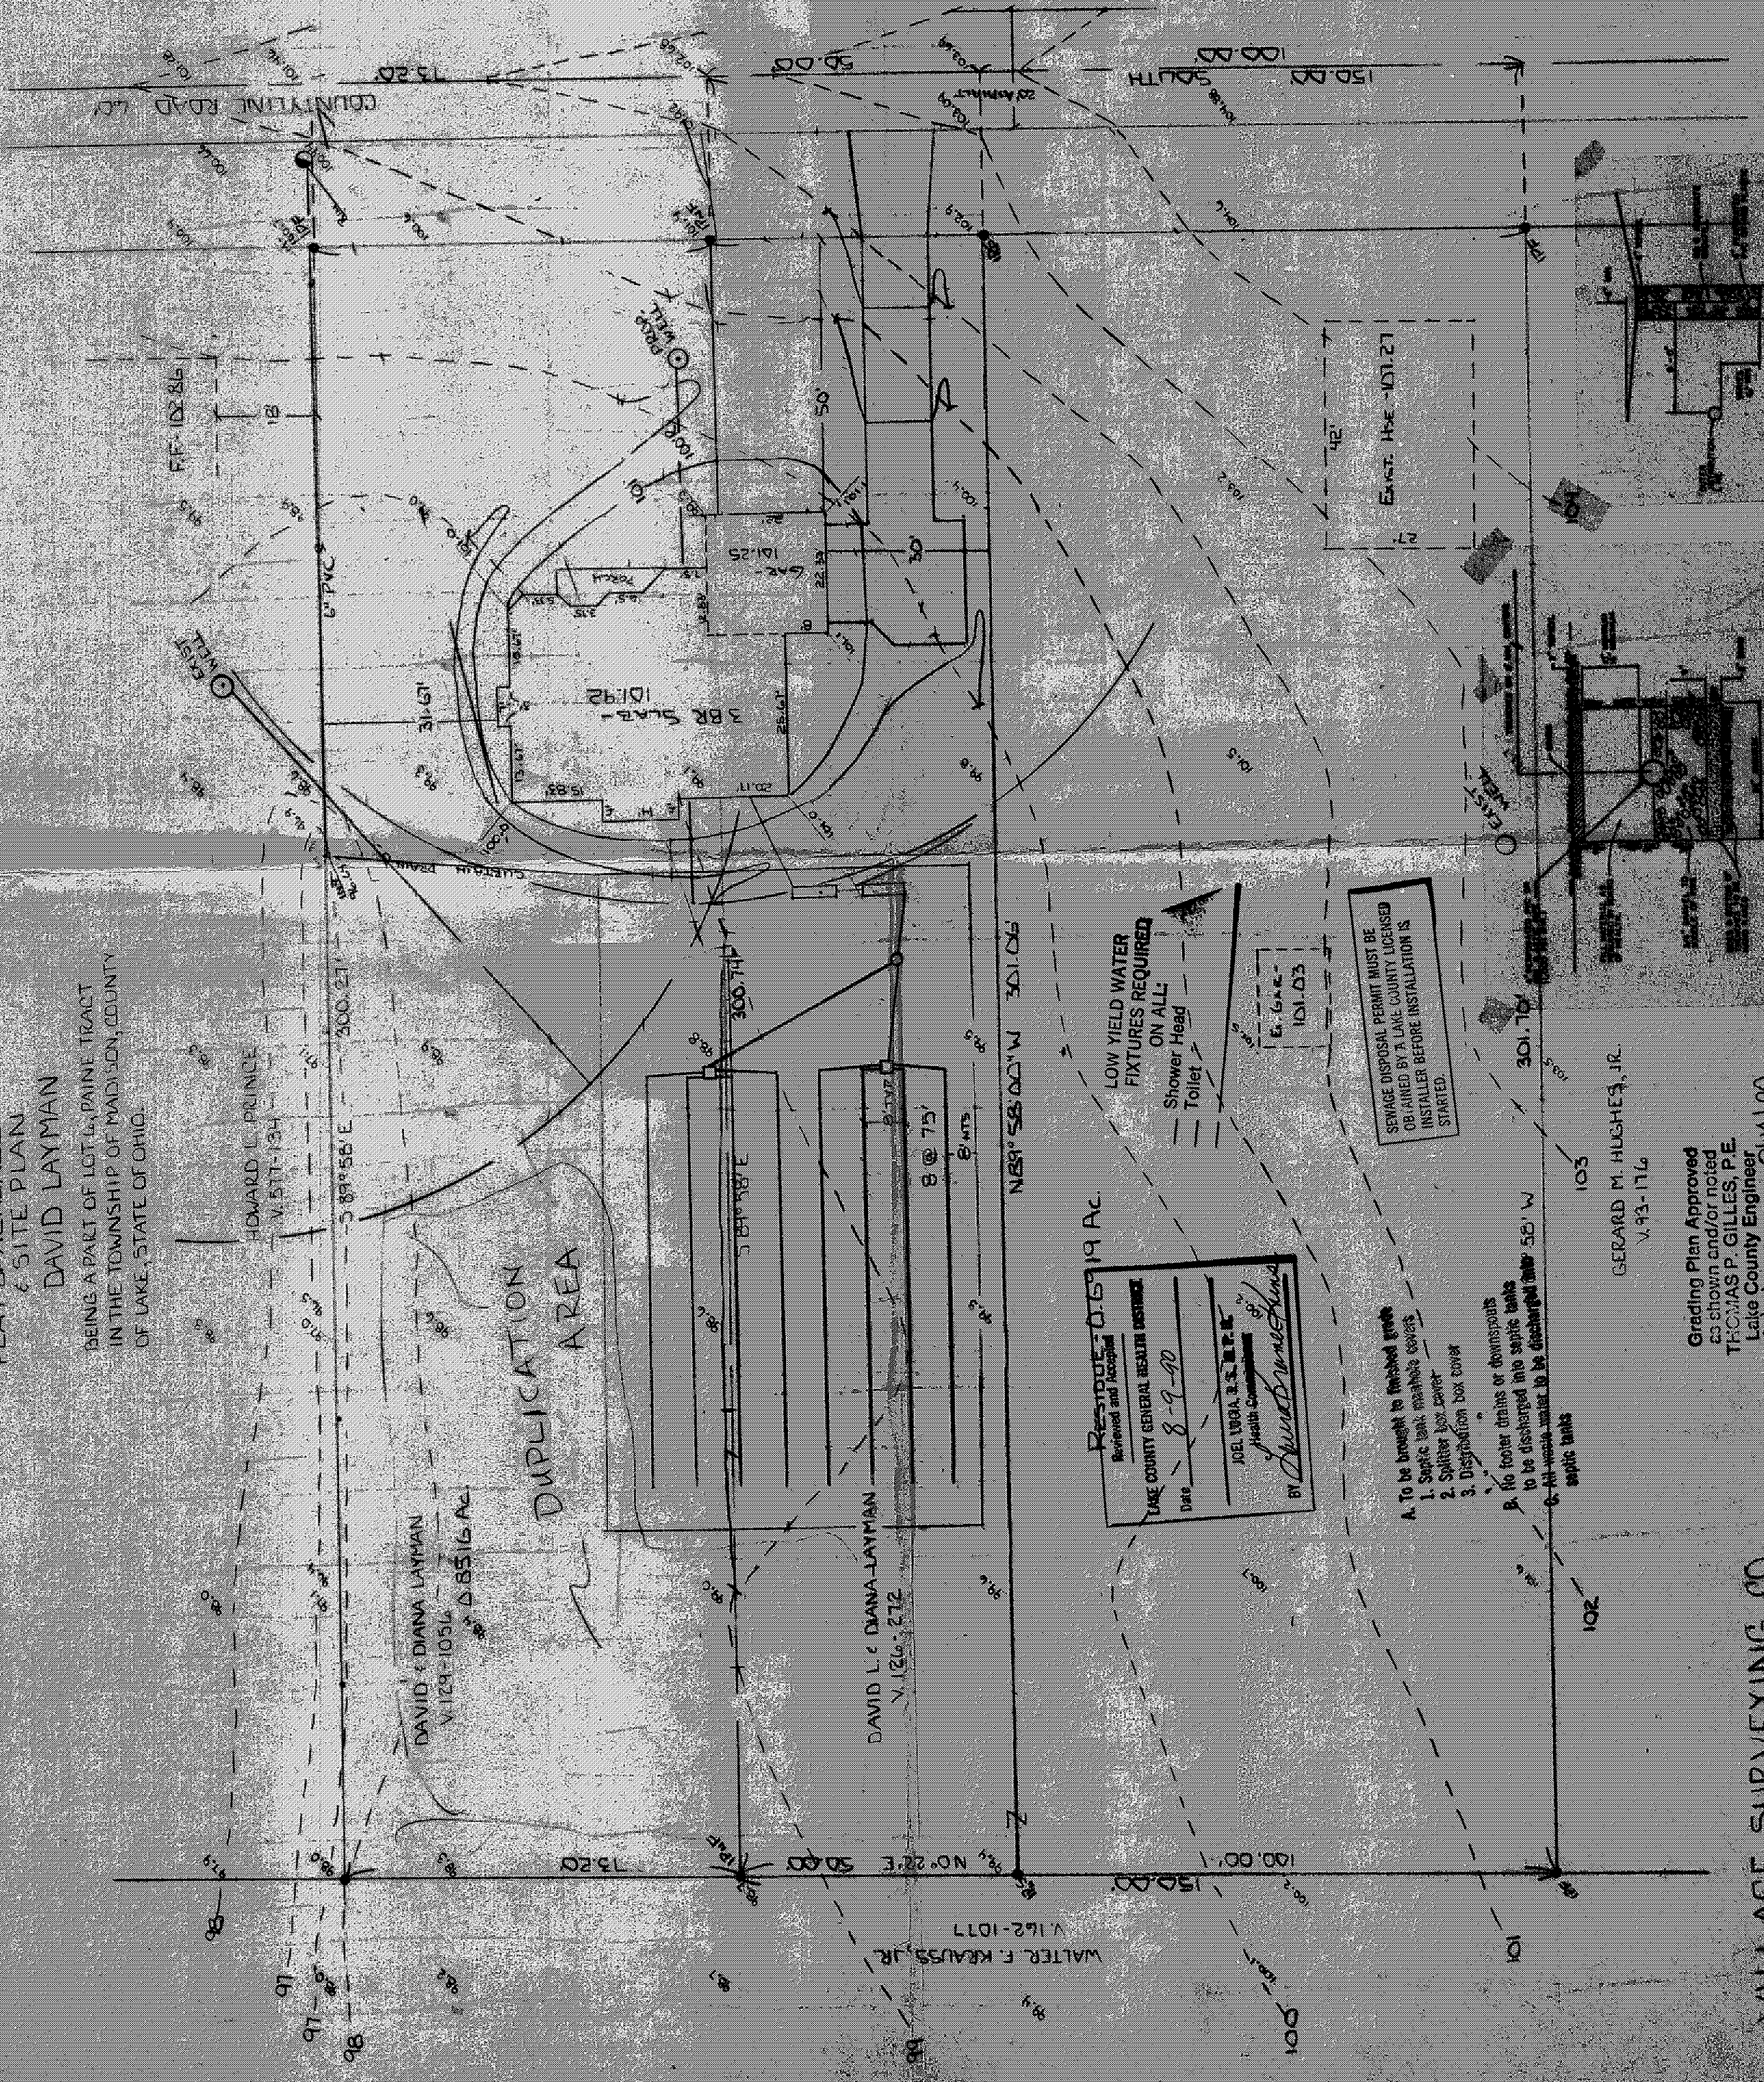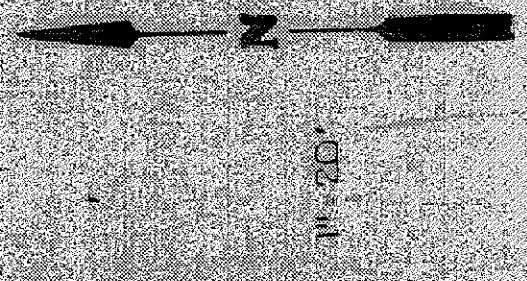

HYDRAULIC PROFILE
VERT. 1" = 3' HORIZ. 1" = 20'

I, the undersigned, hereby certify that this plat was prepared by me and is accurate to the best of my knowledge and belief.

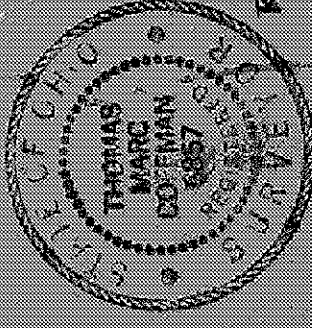

THIS PLAT WAS PREPARED BY ME AND IS ACCURATE TO THE BEST OF MY KNOWLEDGE AND BELIEF.

THOMAS M. COFFMAN, P.S.
8-8-90
KENT, OHIO